



CONSTRUCT DRIVE  
 192+45, LT. (GRAVEL) 12' W  
 195+42, LT. (GRAVEL) 16' W  
 198+35, LT. (GRAVEL) 12' W

# THIS SHEET IS FOR WETLANDS AND RARE AND ENDANGERED SPECIES ONLY

PLAN  
 SURVEYED BY: \_\_\_\_\_  
 PLOTTED BY: \_\_\_\_\_  
 CHECKED BY: \_\_\_\_\_  
 DATE: \_\_\_\_\_

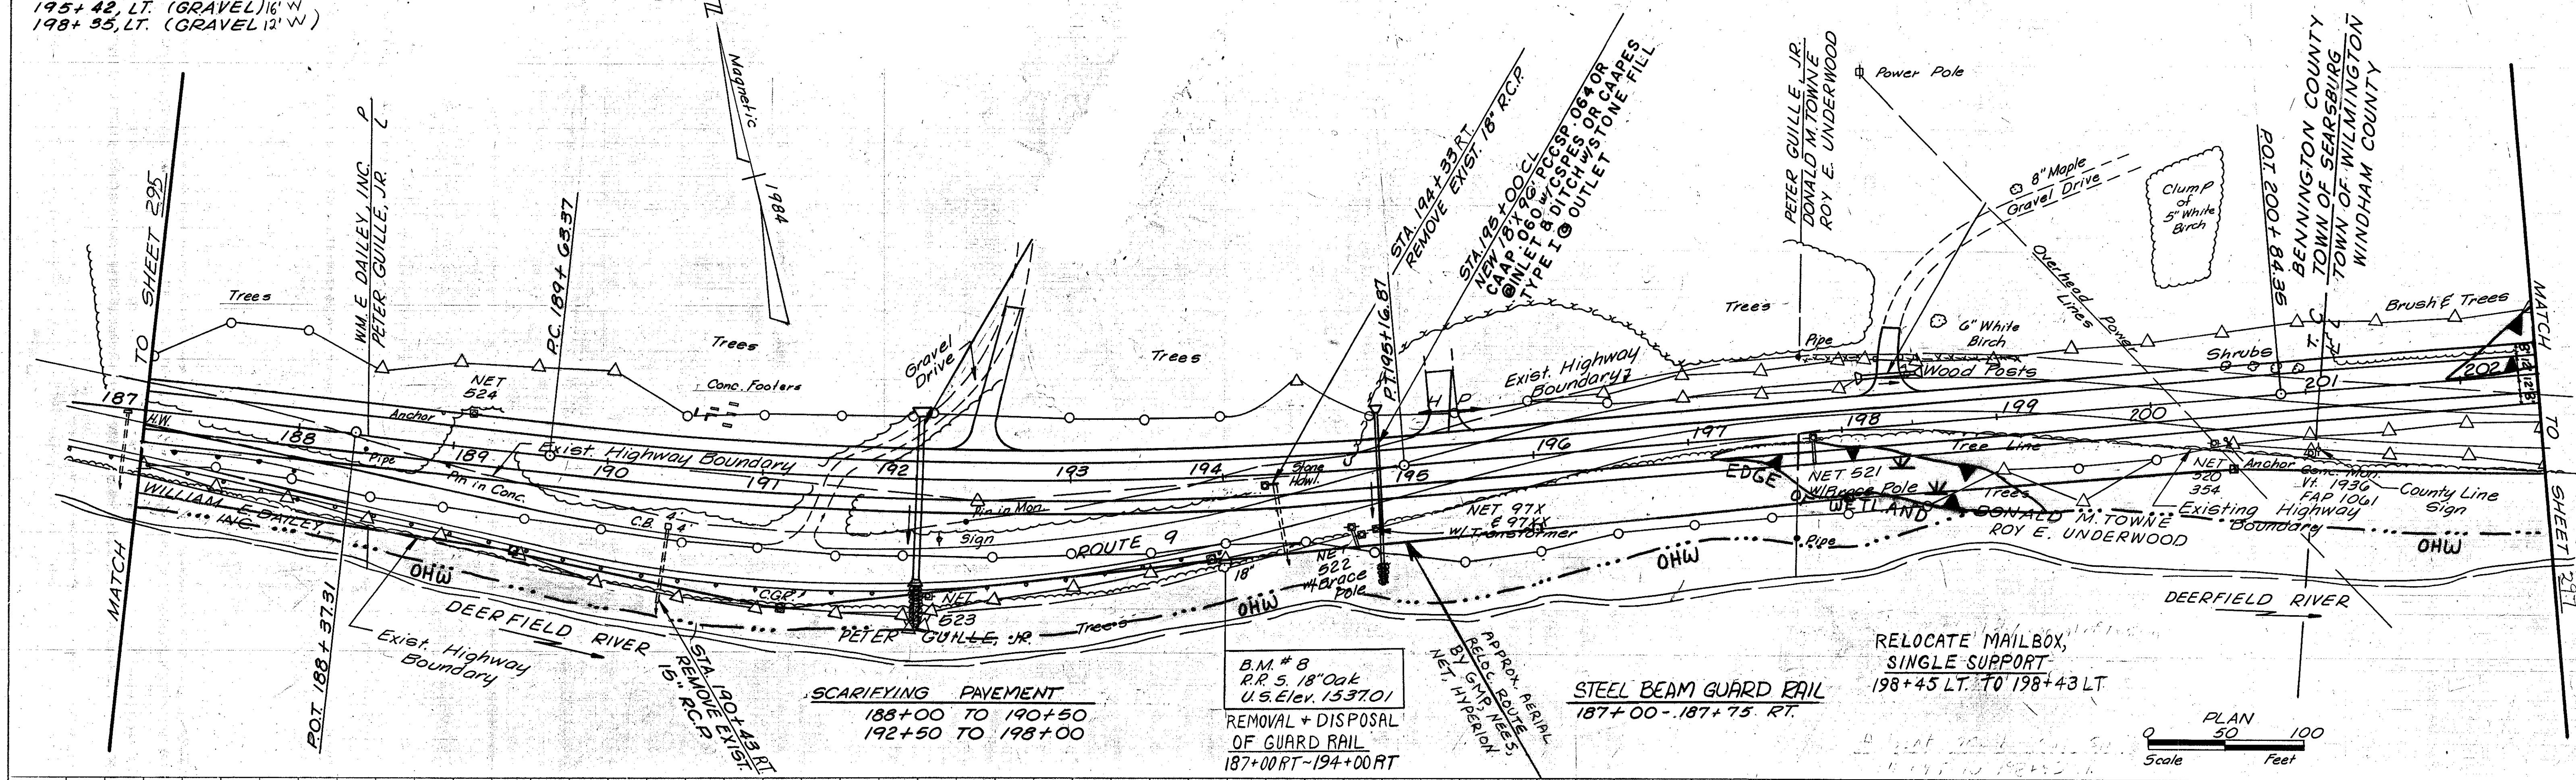

PROFILE  
 SURVEYED BY: \_\_\_\_\_  
 PLOTTED BY: \_\_\_\_\_  
 CHECKED BY: \_\_\_\_\_  
 DATE: \_\_\_\_\_

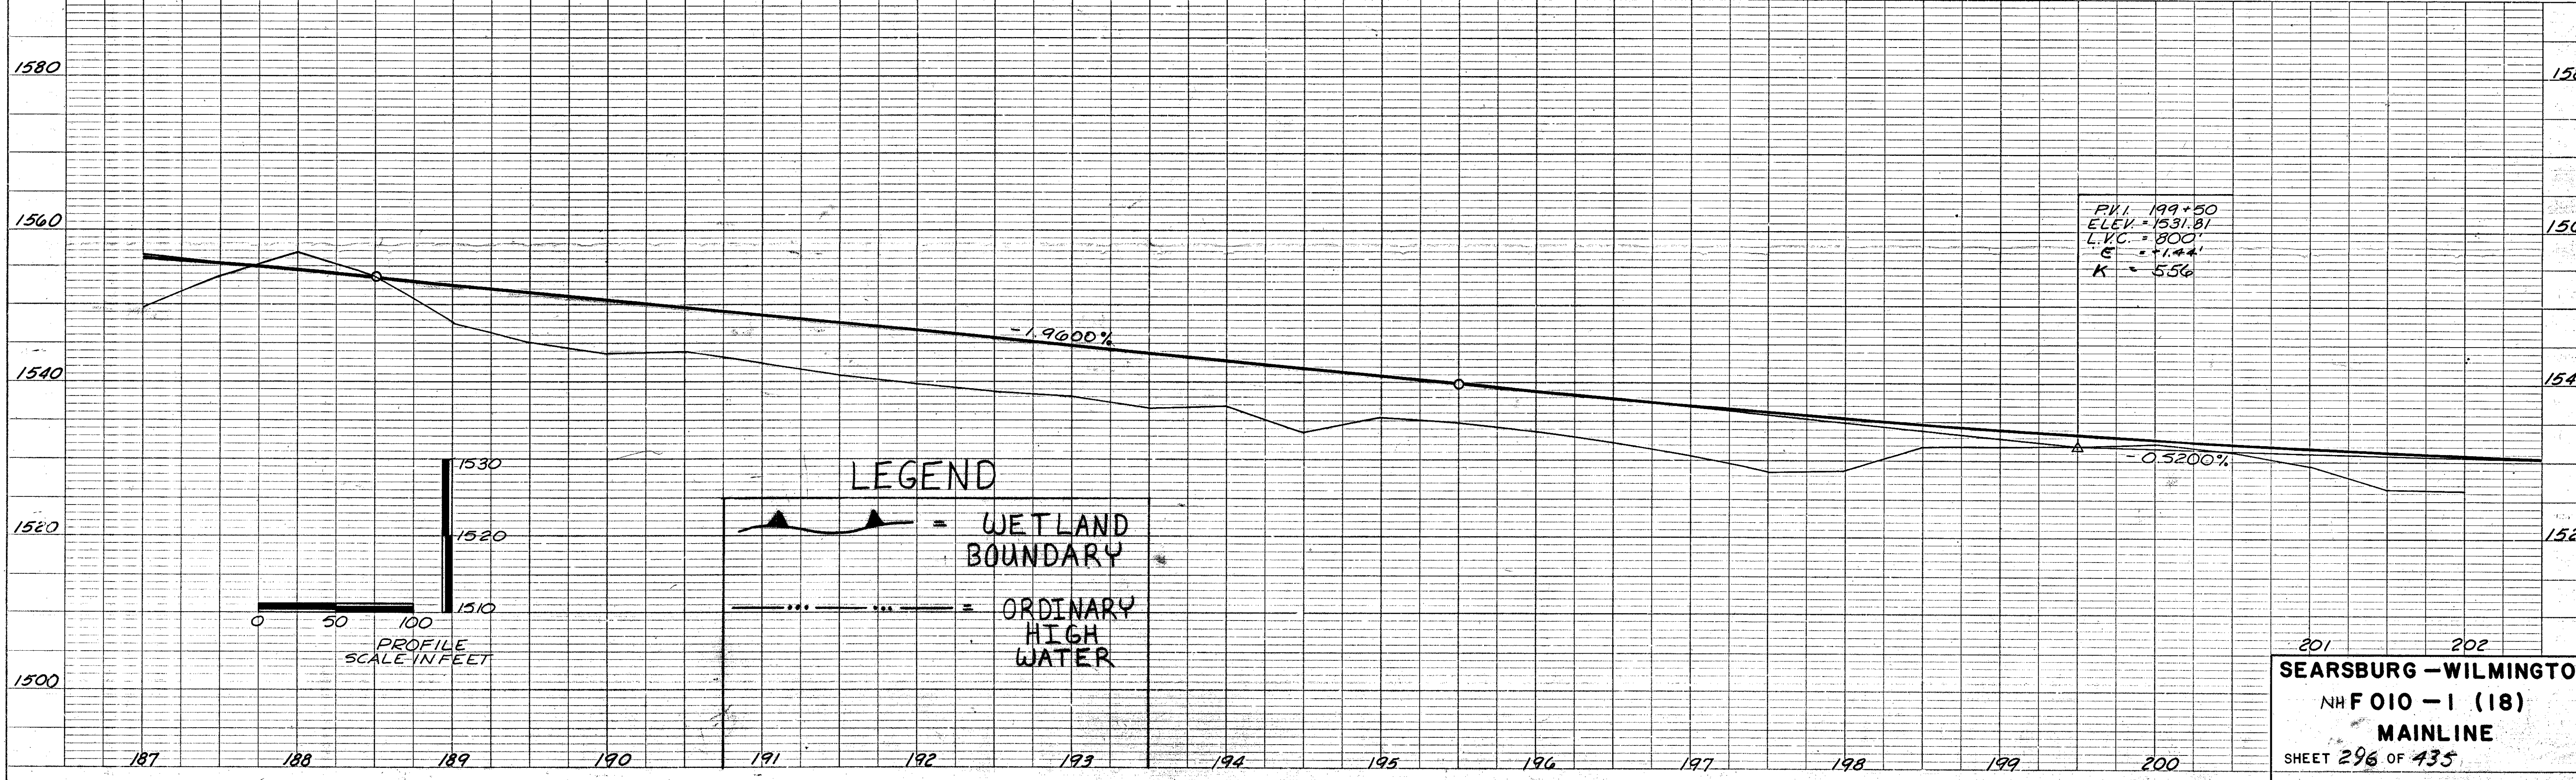

SEARSBURG - WILMINGTON  
 NH F 010 - 1 (18)  
 MAINLINE  
 SHEET 296 OF 435