


THIS SHEET IS FOR WETLANDS AND RARE AND ENDANGERED SPECIES ONLY

PLAN
 DATE: _____
 BY: _____
 CHECKED: _____
 NO. _____

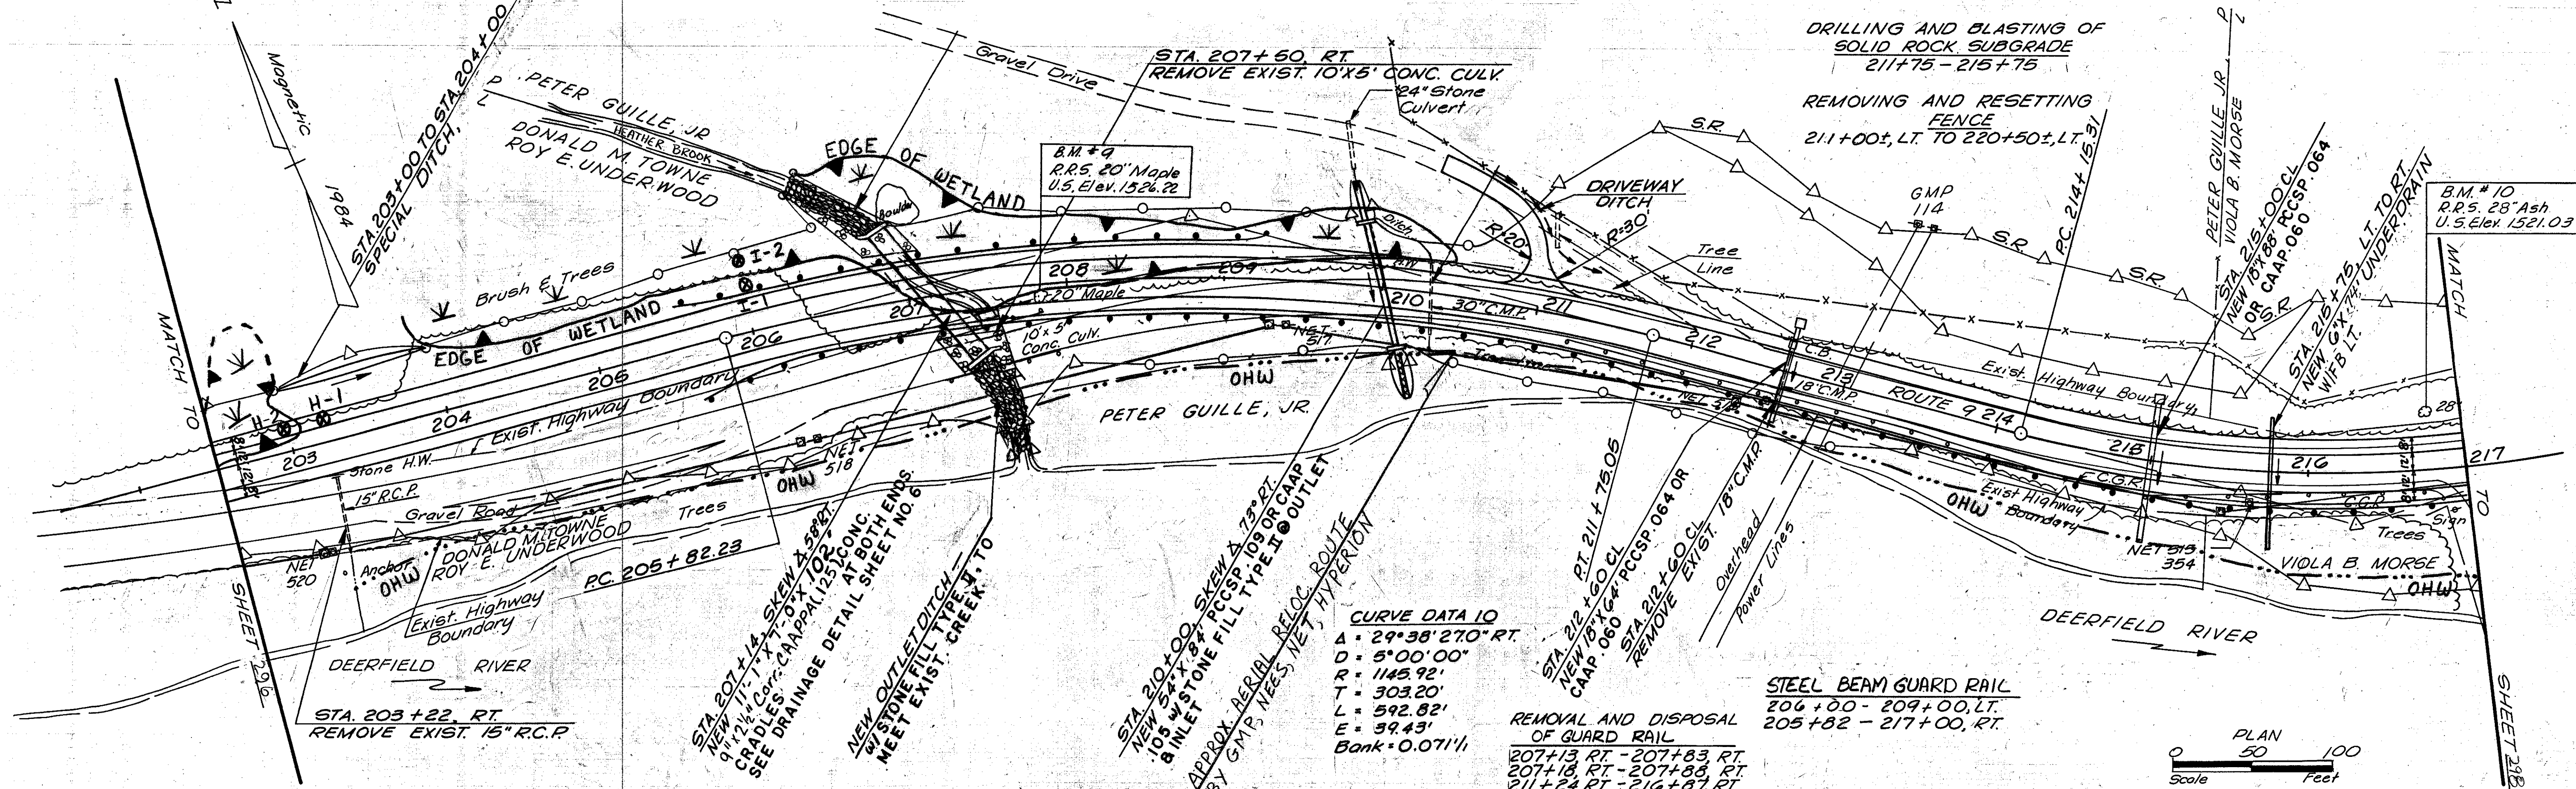

PROFILE
 DATE: _____
 BY: _____
 CHECKED: _____
 NO. _____

