
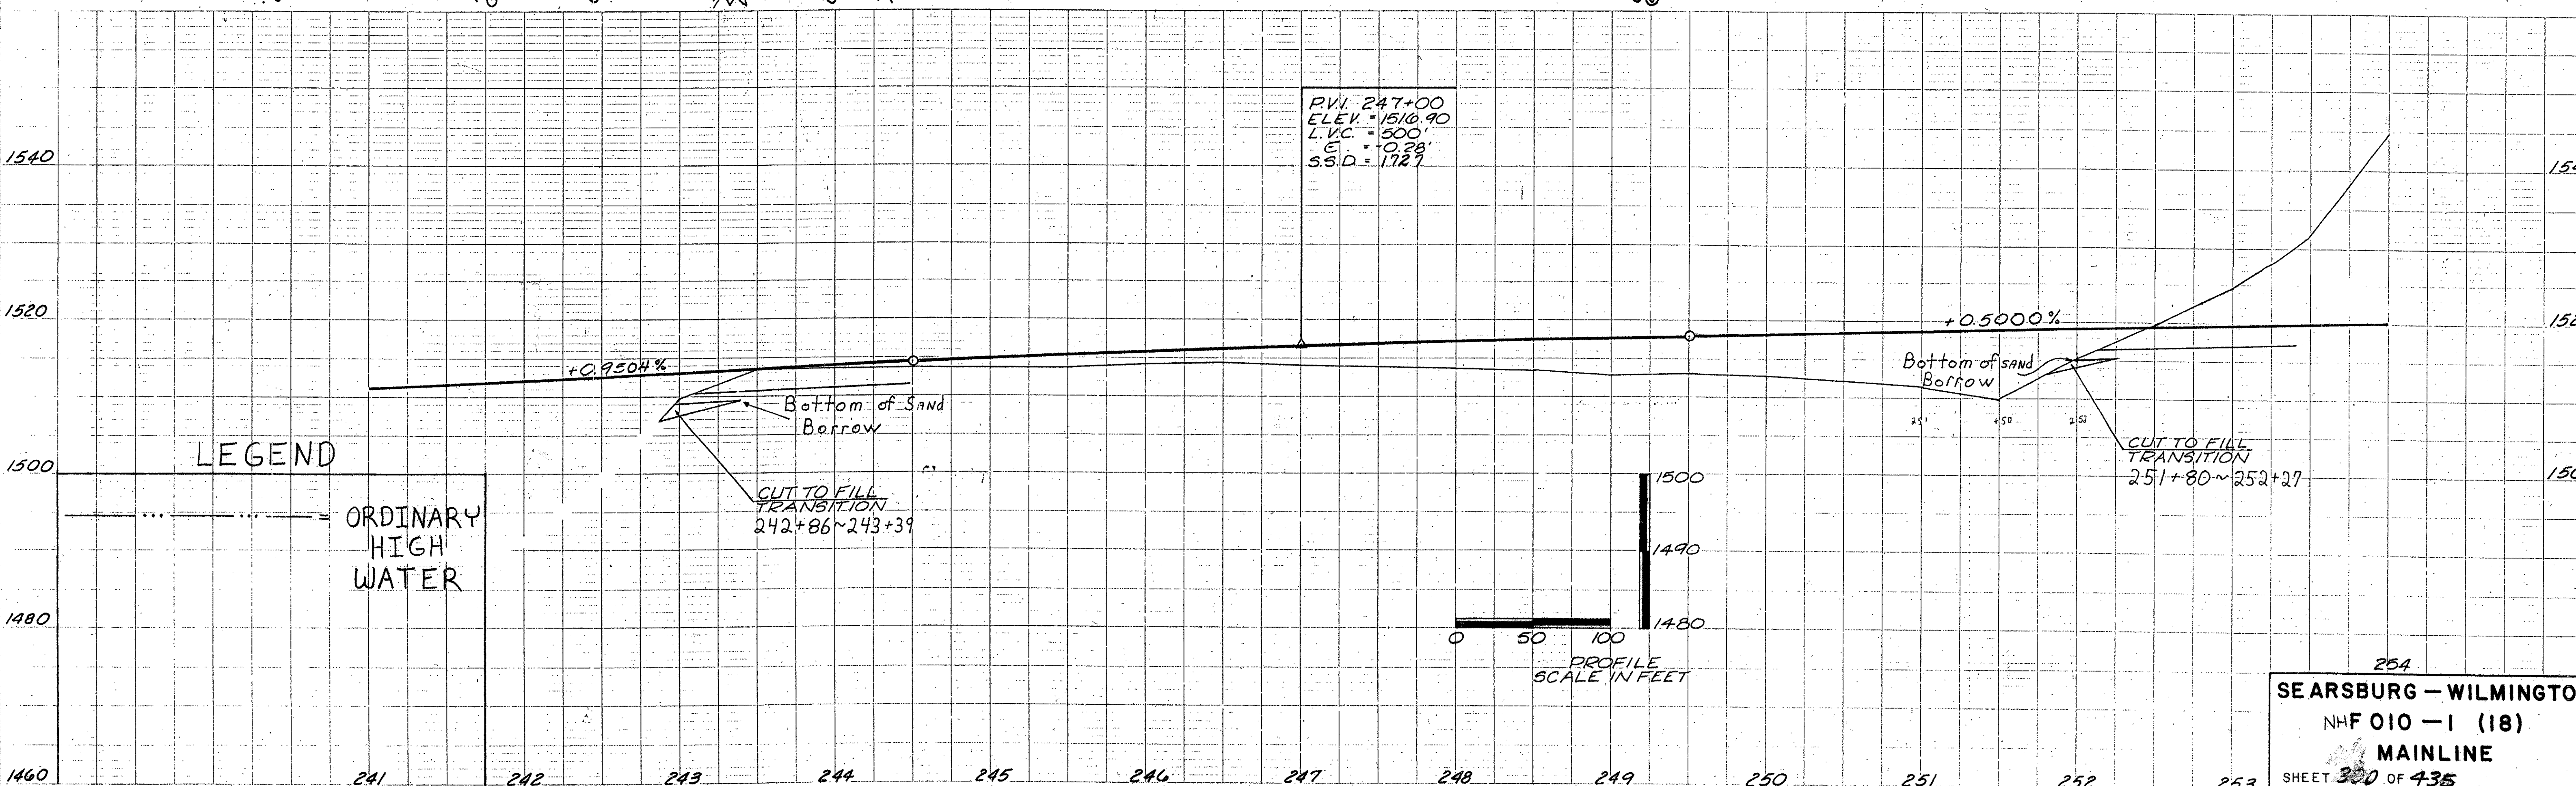


NOTE

THIS SHEET IS FOR WETLANDS AND RARE AND ENDANGERED SPECIES ONLY

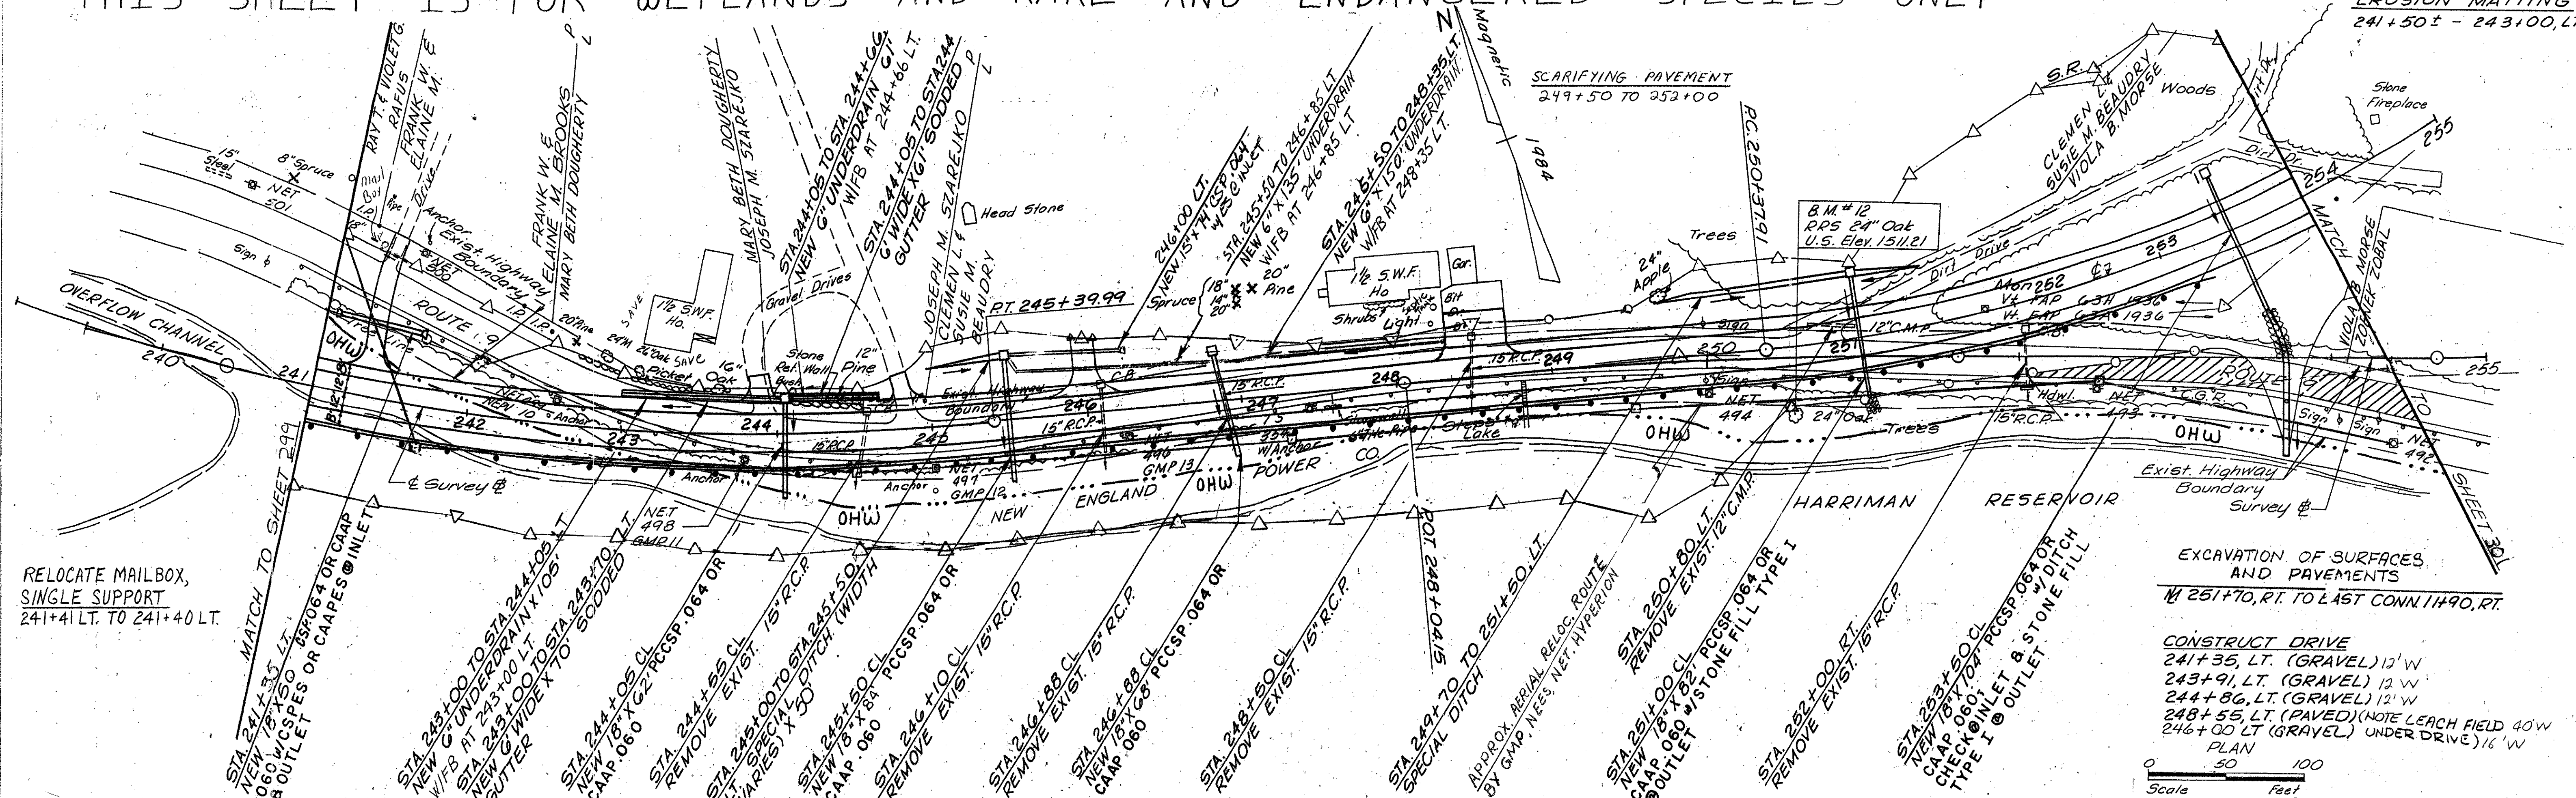

264  
SEARSBURG - WILMINGTON  
NH F 010 - 1 (18)  
MAINLINE  
SHEET 300 OF 435