


THIS SHEET IS FOR WETLANDS AND RARE AND ENDANGERED SPECIES ONLY

DATE: _____
 BY: _____
 CHECKED: _____
 APPROVED: _____
 TITLE: _____



DATE: _____
 BY: _____
 CHECKED: _____
 APPROVED: _____
 TITLE: _____

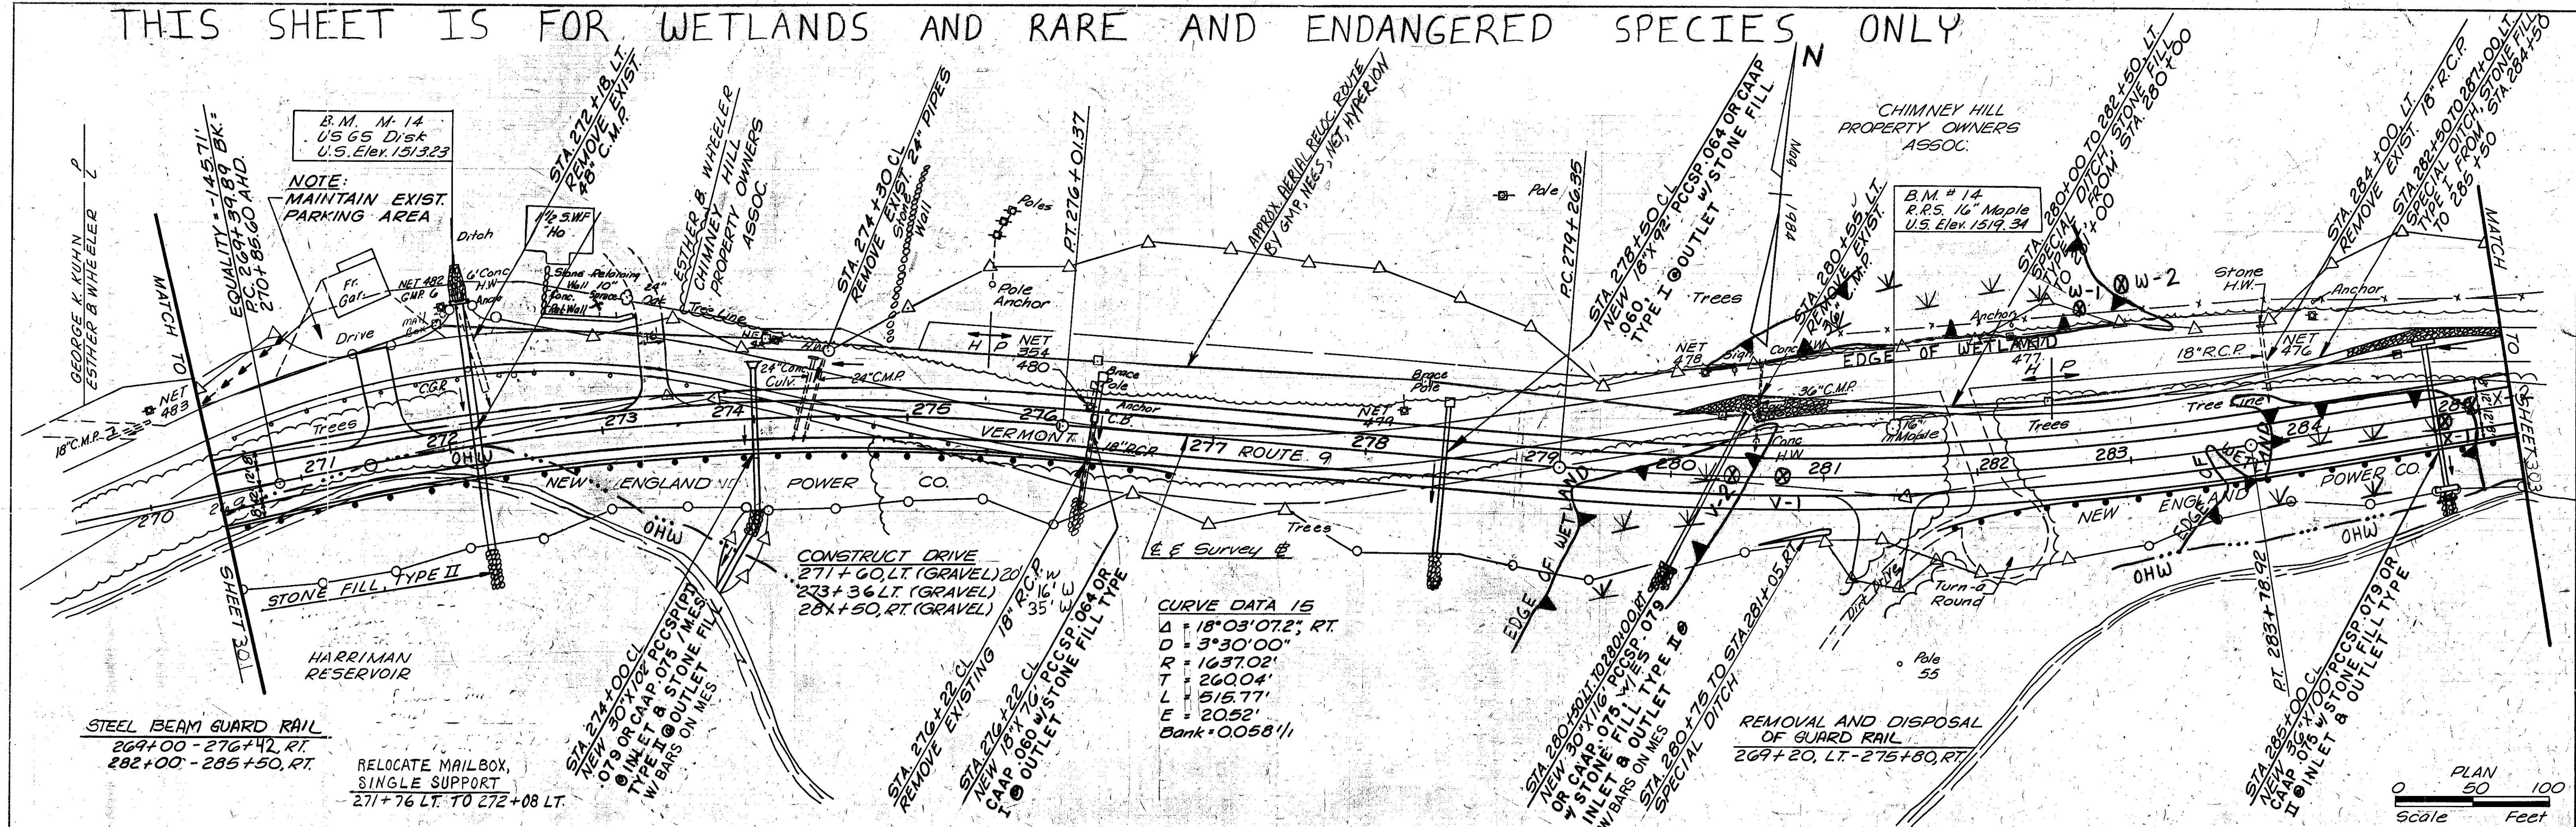