

PLAN
 NOTE BOOK
 NO.


PROFILE
 NOTE BOOK
 NO.

EROSION MATTING
 285+50 - 288+00, LT.
 290+75 - 292+00, LT.

CHIMNEY HILL PROPERTY OWNERS ASSOC.


B.M. # 15
 R.R.S. Pole
 U.S. Elev. 1516.43

CONSTRUCT DRIVE
 290+50, LT. (GRAVEL 24" WIDE)

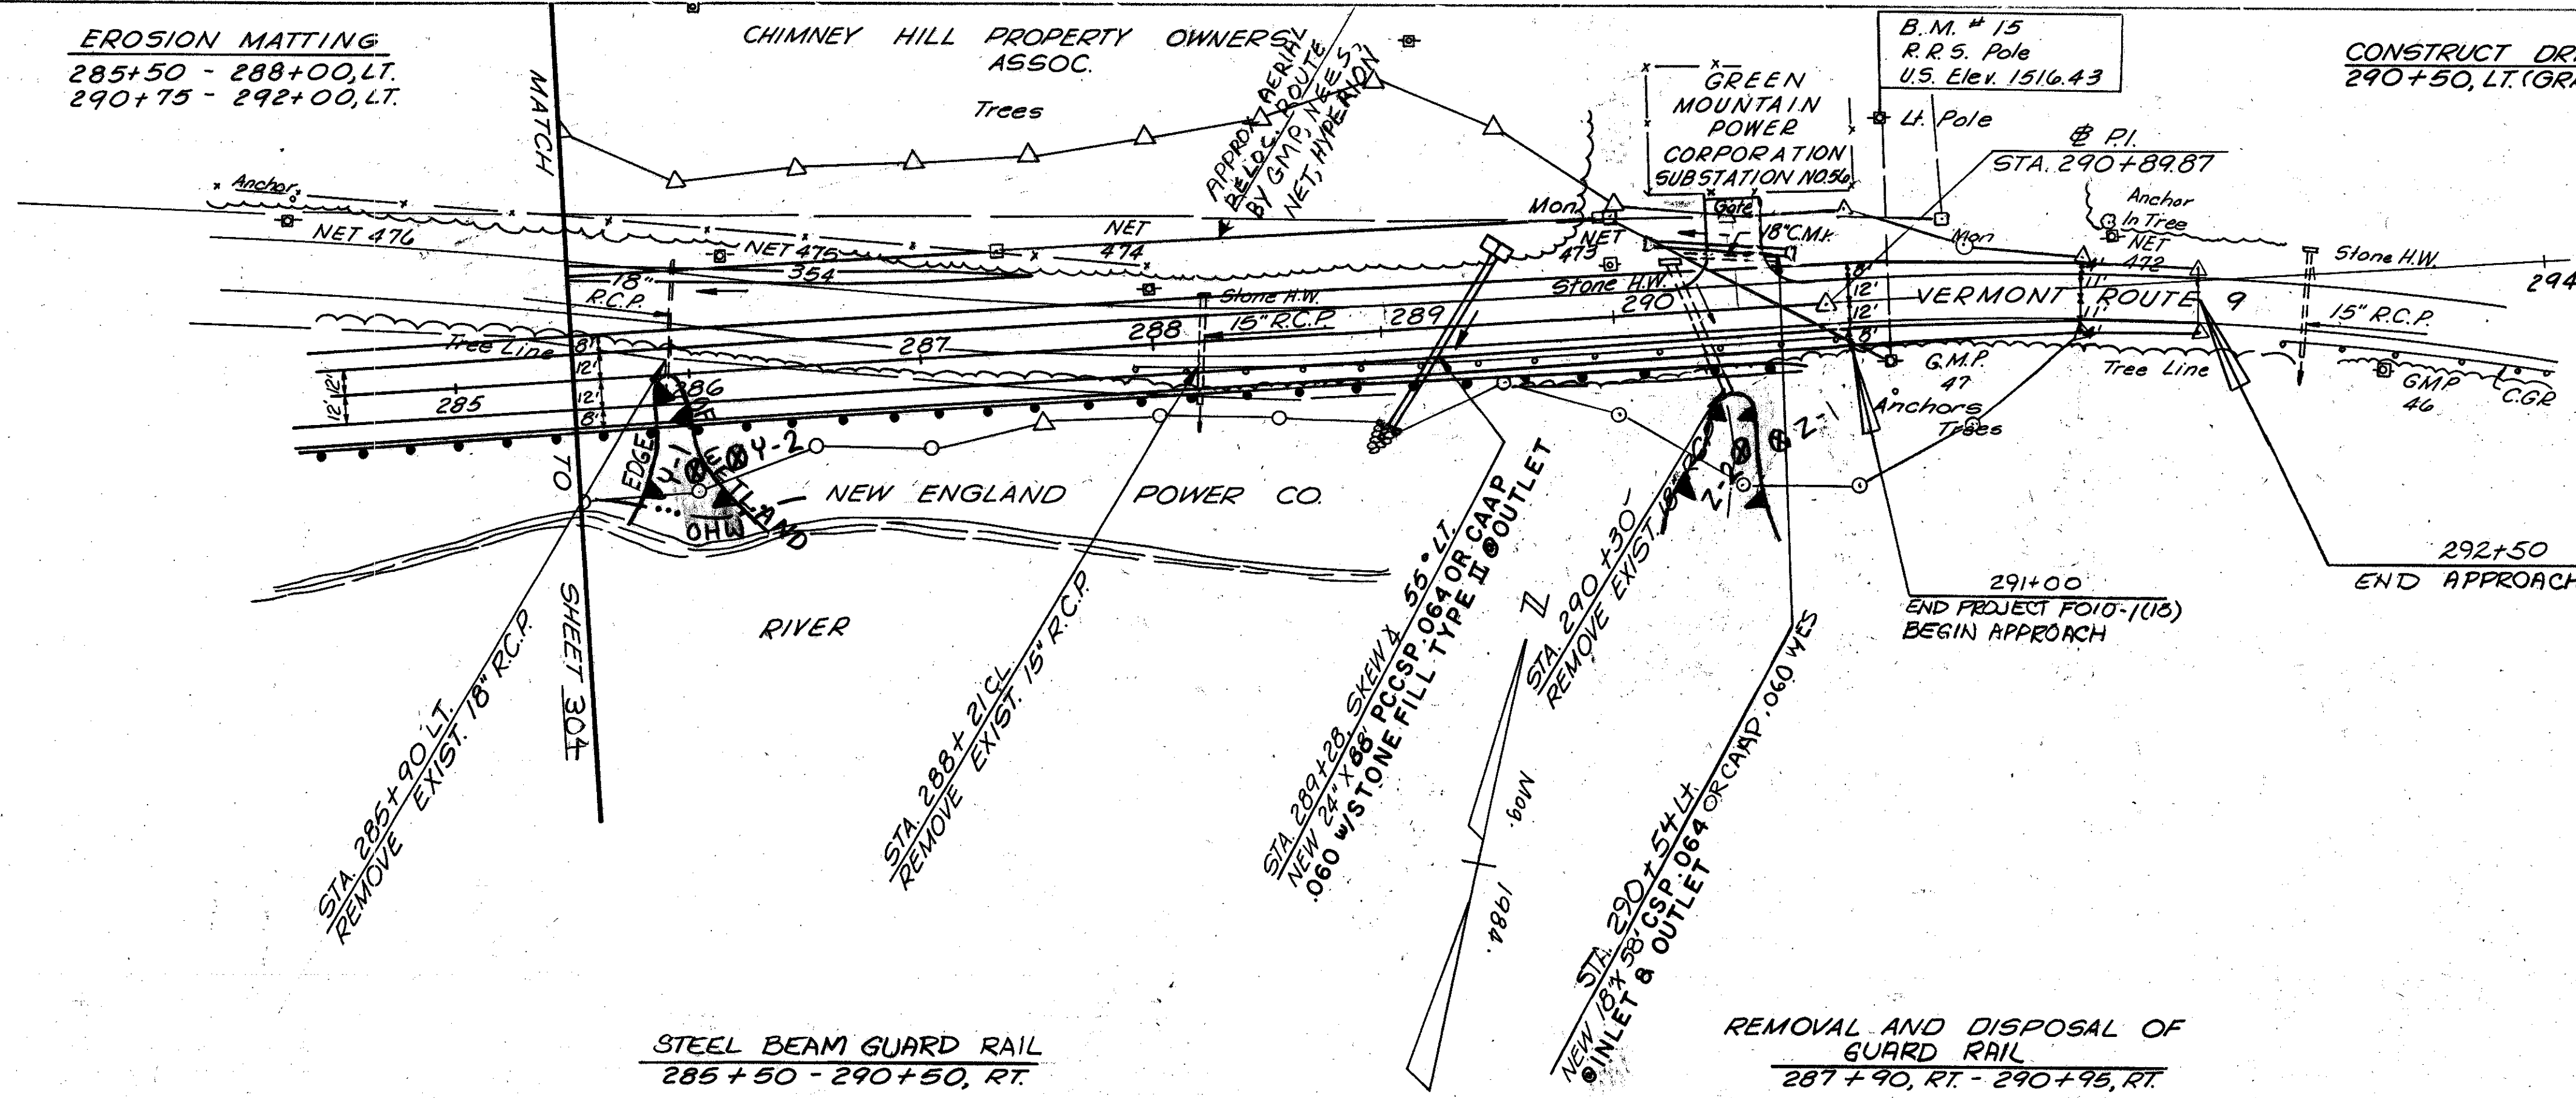

THIS SHEET IS FOR WETLANDS AND RARE AND ENDANGERED SPECIES ONLY

PLAN
 0 50 100
 Scale Feet

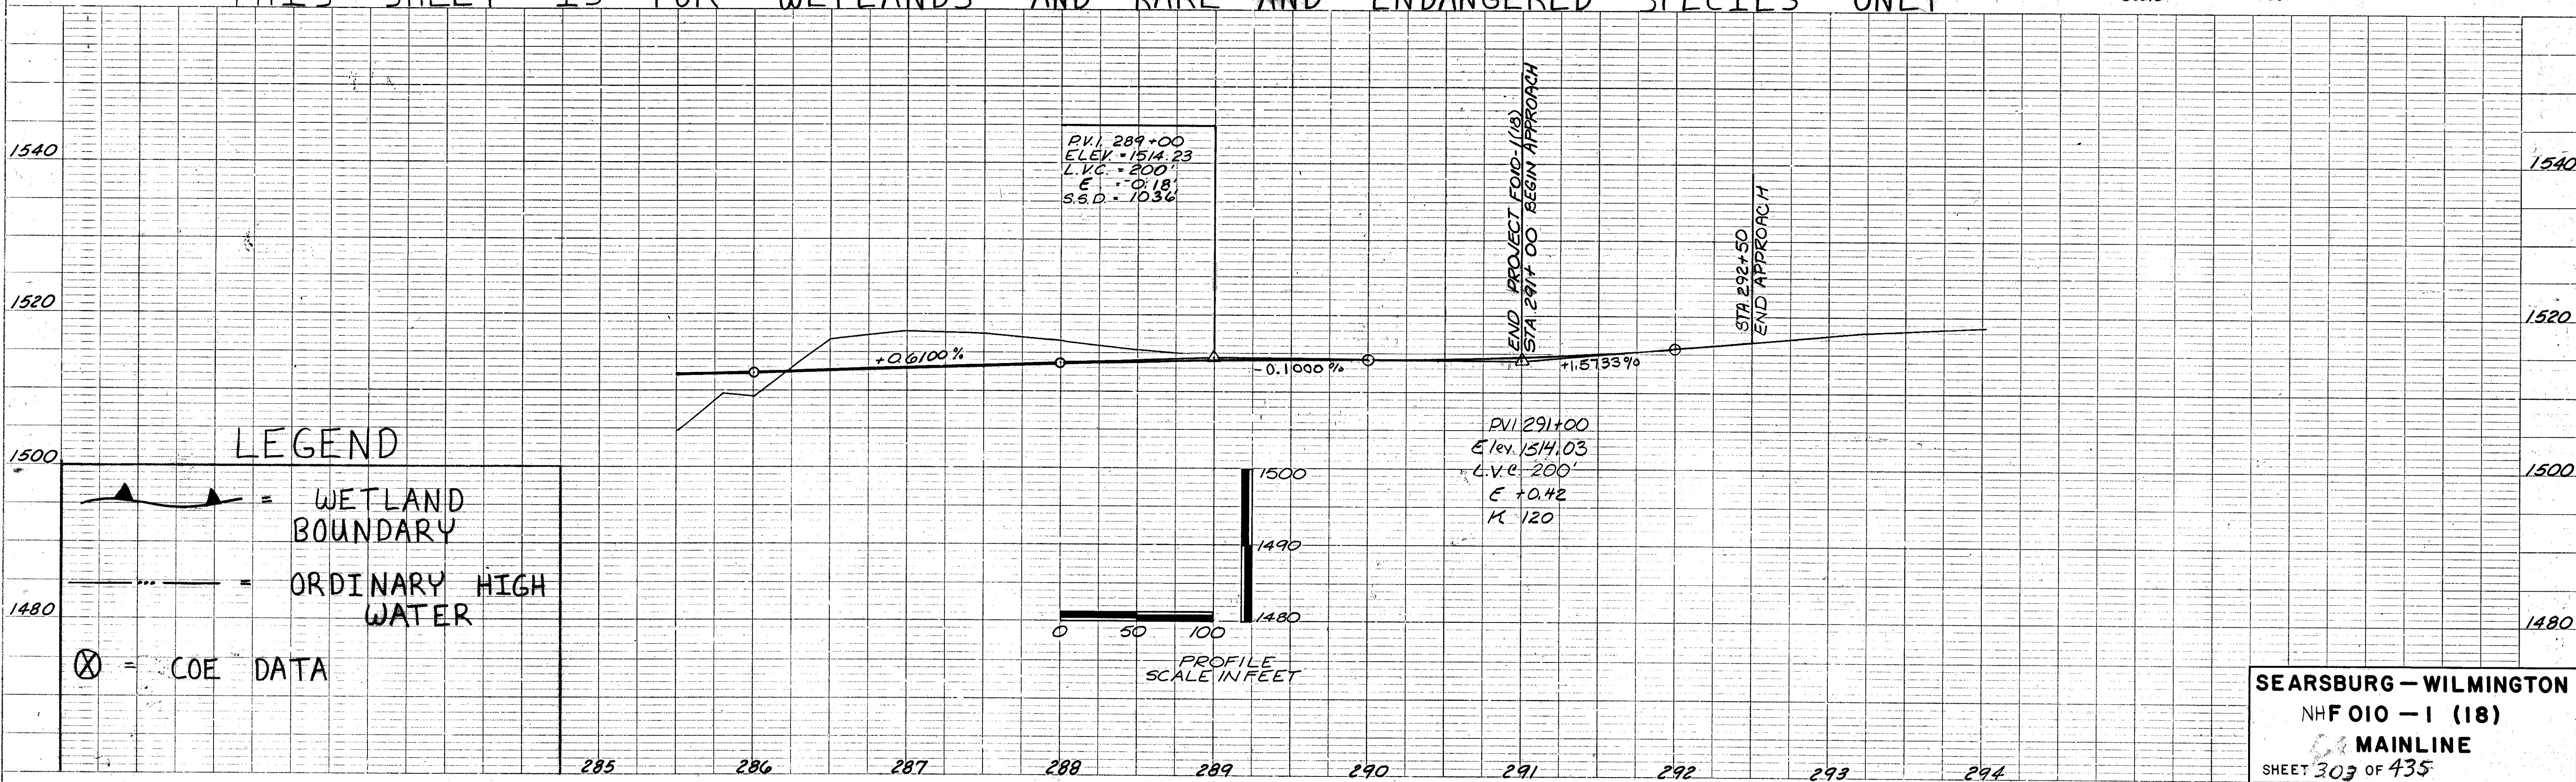

SEARSBURG - WILMINGTON
 NHF 010 - 1 (18)
 MAINLINE
 SHEET 303 OF 435