


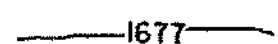



STA 9+25

MATCH TO SHEET 5 of 12

LEGEND


-  1677 FINISH GRADE CONTOURS
-  EXISTING WETLAND BOUNDARY
-  WETLAND SYMBOL
-  AREA TO BE PLANTED WITH SALIX SERICEA CUTTINGS
-  AREA TO BE PLANTED WITH SALIX SERICEA CUTTINGS AND RUSH/BULRUSH-WINTER RYE SEED MIX

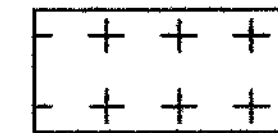

NOTES:

1. THE FOLLOWING AREAS ARE TO BE SEEDED WITH THE NEW ENGLANDRUSH/BULRUSH SEED MIX AND WINTER RYE AND MULCHED WITH STRAW AS DIRECTED BY THE ENGINEER:
ALL DISTURBED AREAS WITH THE EXCEPTION OF THE POND, SEASONAL POOL, THE EXISTING WETLAND AREAS, AND A 16' VAST/DEERFIELD VALLEY TRAIL RIGHT-OF-WAY THE 20' WIDE PLANTING BERM, OUTSIDE OF MULCHED SHRUB PLANTING POCKETS.
THE NORTHERN AND EASTERN MITIGATION SITE BUFFER (SHOWN IN DOTS)
2. AREAS TO RECEIVE FINAL PLANTING DURING THE SECOND YEAR OF CONSTRUCTION (POND & SEASONAL POOL) SHALL BE SEEDED WITH WINTER RYE IMMEDIATELY FOLLOWING FINAL GRADING, OR AS DIRECTED BY THE ENGINEER.

* ALL SALIX SERICEA CUTTINGS AND RUSH/BULRUSH MIX WERE USED IN THE GRADED PORTIONS OF THE WETLAND, SINCE THESE BUFFER AREAS HAVE NATURALLY RE-VEGETATED WITH WILLOWS AND OTHER SPECIES.

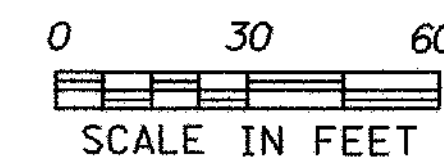

PROPOSED WETLAND MITIGATION LANDSCAPE PLAN

| | | | |
|-------------------|------------------------|--------------|-------------|
| PROJECT: | SEARSBURG - WILMINGTON | PROJECT NO.: | NHF 010-108 |
| DESIGN FILE NAME: | ZD096-006.DGN | PLOT DATE: | 11/09/01 |
| IPARM FILE NAME: | | SURVEY DATE: | |
| SURVEYED BY: | RICHARD GILMAN | DRAWN BY: | K.R.KOLOSKI |
| SQUAD LEADER: | C.W. BRODIE | SHEET: | 6 OF 12 |

SHEET 324 OF 435

| | |
|------------|------------|
| DATUM | |
| VERTICAL | NAVD 1988 |
| HORIZONTAL | NAD-83(92) |