


PROFILE

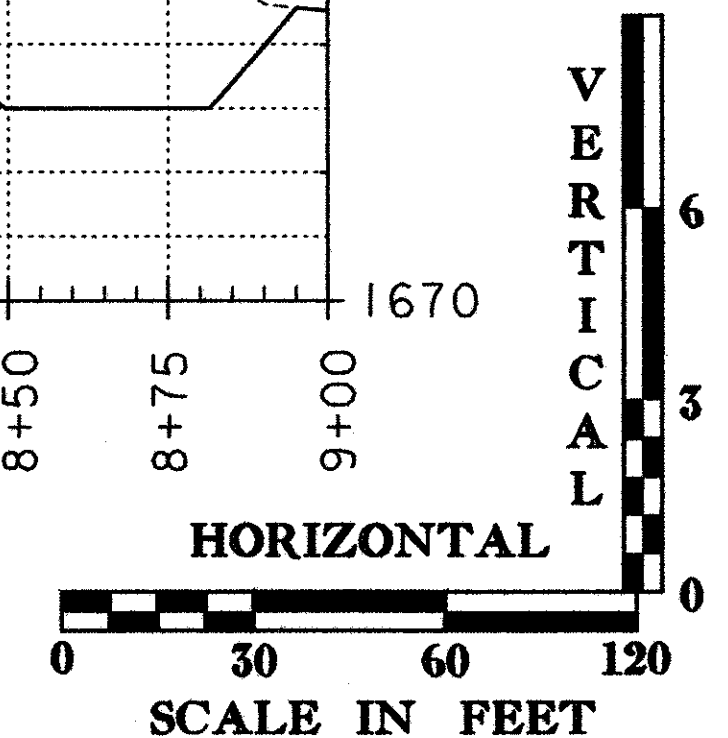

DATUM	
VERTICAL	_____
HORIZONTAL	_____

PROJECT: SEARSBURG - WILMINGTON	PROJECT NO.: NHF 010-1(18)
DESIGN FILE NAME: IPARM FILE NAME: DD096XS1.DGN	PLOT DATE: 11/09/01
SURVEYED BY: SQUAD LEADER: C. W. BRODIE	SURVEY DATE: DRAWN BY: K. R. KOLOSKI
	SHEET: 8 OF 12