


DATUM
 VERTICAL _____
 HORIZONTAL _____

SECTIONS 2+50 TO 4+00

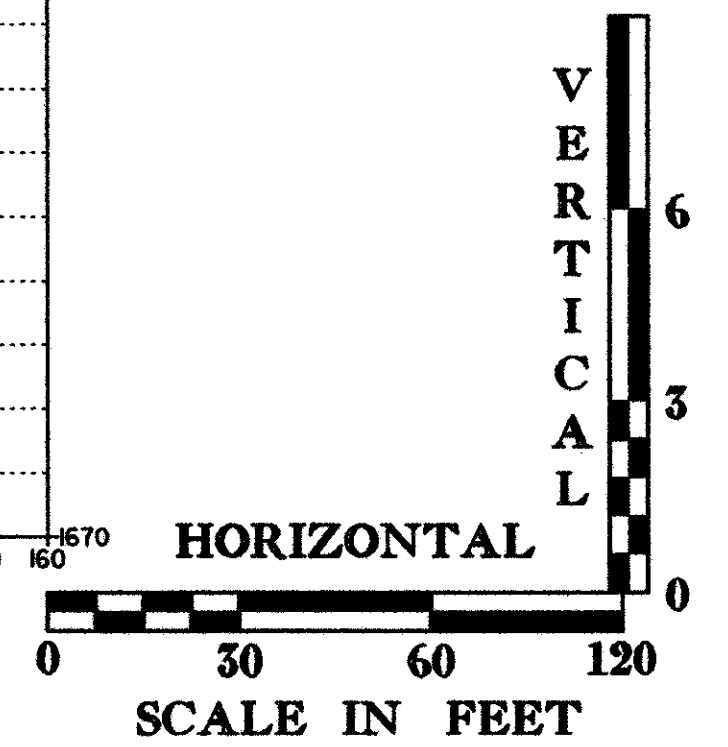

| | |
|--|-------------------------------------|
| PROJECT: SEARSBURG - WILMINGTON | PROJECT NO.: NHF 010-1018 |
| DESIGN FILE NAME: IPARM FILE NAME: DD096XS1.DGN | PLOT DATE: 11/09/01 |
| SURVEYED BY: | SURVEY DATE: |
| SQUAD LEADER: C. W. BRODIE | DRAWN BY: K. KOLOSKI |
| | SHEET: 10 OF 12 |