


SECTIONS 4+50 TO 6+00

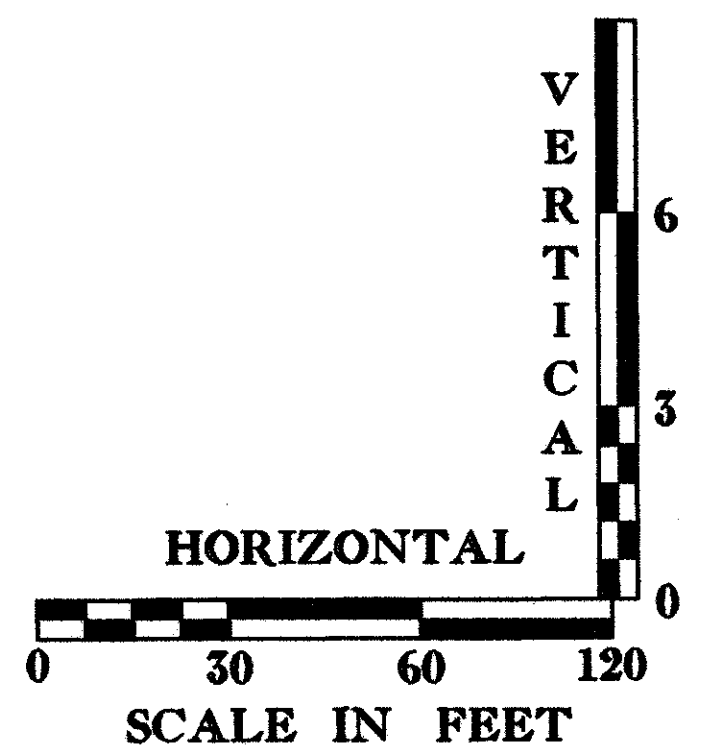

DATUM
 VERTICAL _____
 HORIZONTAL _____

| | |
|--|--------------------------------------|
| PROJECT: SEARSBURG - WILMINGTON | PROJECT NO.: NHF 010-1(18) |
| DESIGN FILE NAME: IPARM FILE NAME: DD096XS1.DGN | PLOT DATE: 11/09/01 |
| SURVEYED BY: | SURVEY DATE: |
| SQUAD LEADER: C. W. BRODIE | DRAWN BY: K. R. KOLOSKI |
| | SHEET: 11 OF 12 |