


SECTIONS 8+00 TO 9+00

DATUM	
VERTICAL	_____
HORIZONTAL	_____

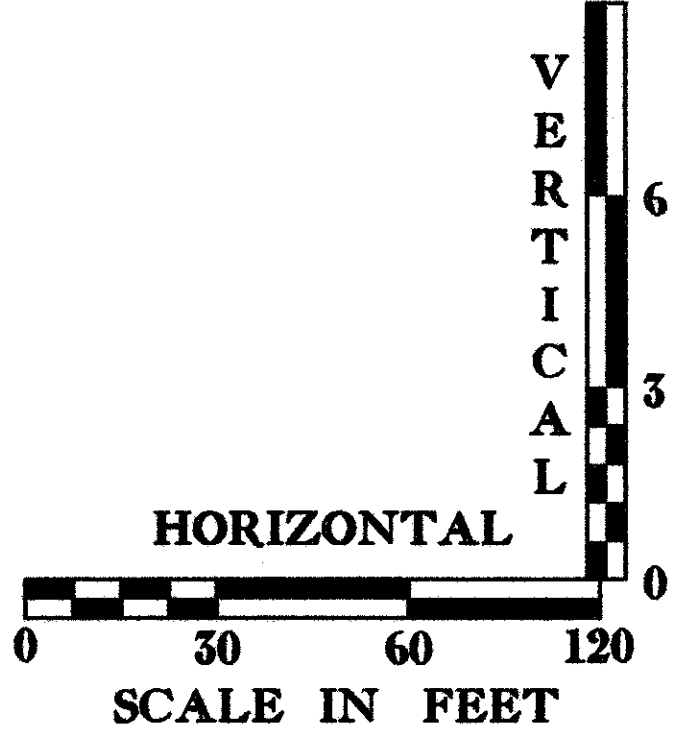

PROJECT: SEARSBURG - WILMINGTON	PROJECT NO.: NHF 010-1(18)
DESIGN FILE NAME: IPARM FILE NAME: D0096XS1.DGN	PLOT DATE: 11/09/01
SURVEYED BY:	SURVEY DATE:
SQUAD LEADER: C. W. BRODIE	DRAWN BY: K. KOLOSKI
	SHEET: 12 OF 12