




226+50
C.L.

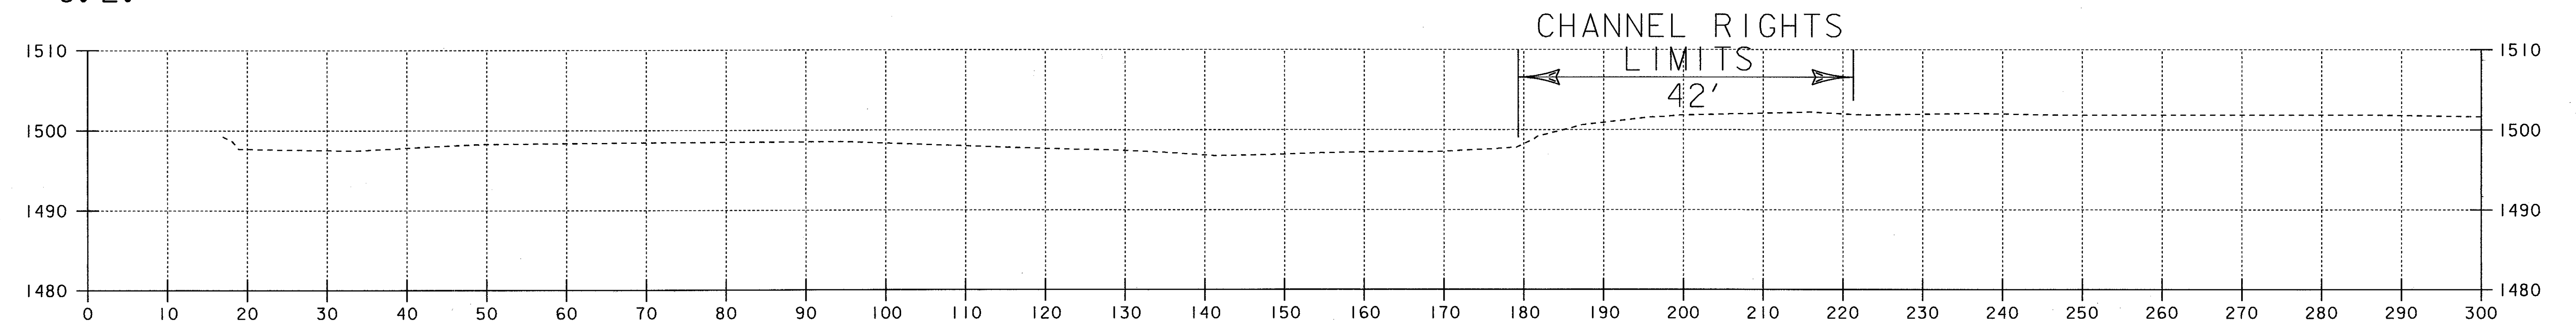

226+00
C.L.

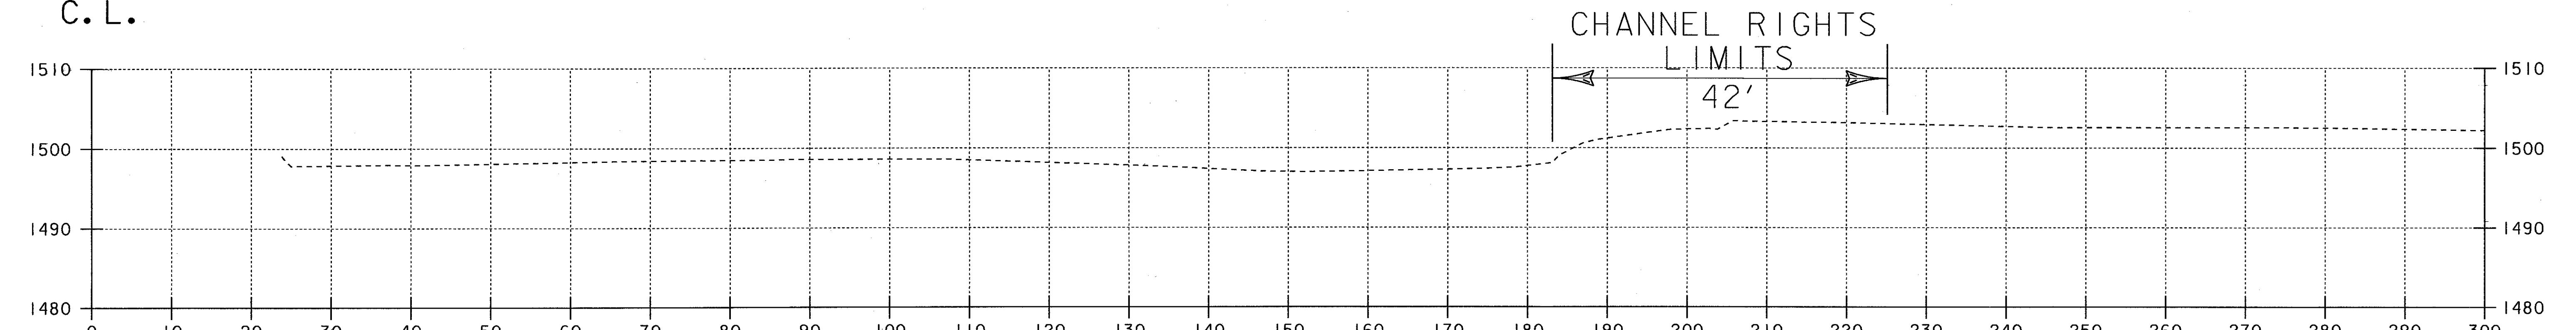


225+50
C.L.

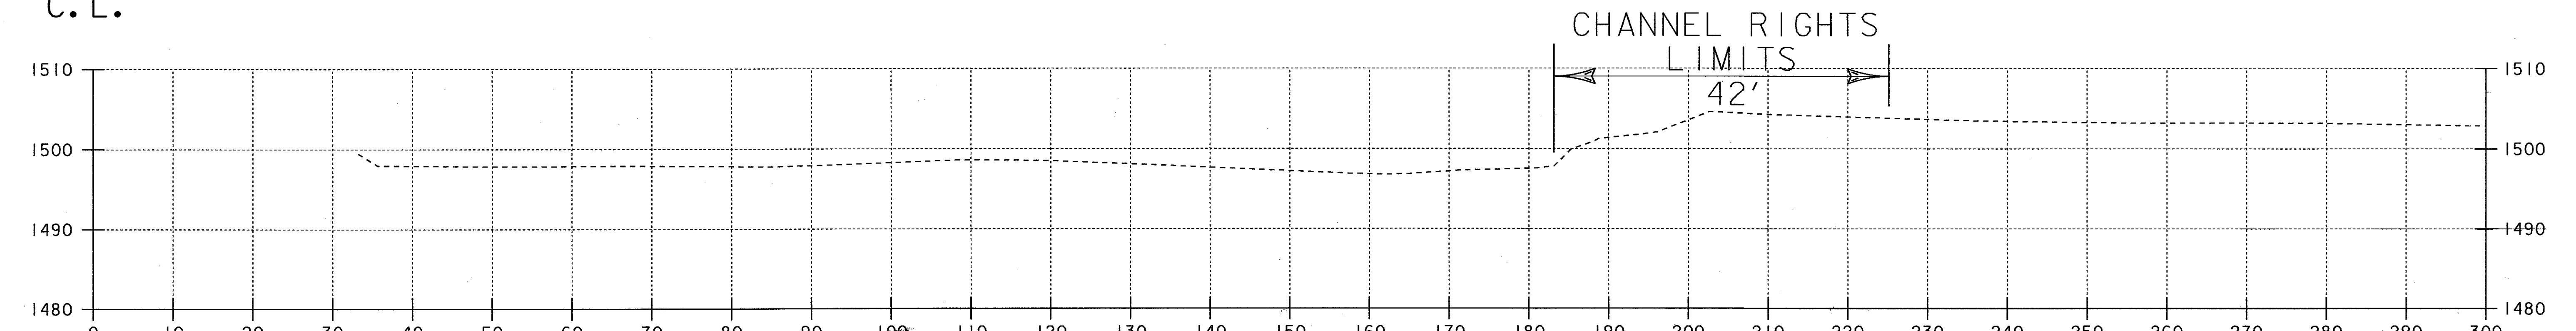

225+00
C.L.

CHANNEL RIGHTS CROSS SECTIONS

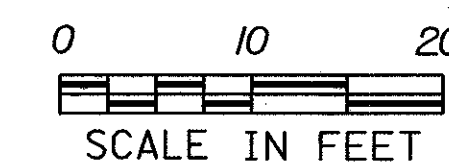

PROJECT NAME:	SEARSBURG - WILMINGTON
PROJECT NUMBER:	NHF 010-1(18)
PLOT FILE NAME:	DD096CRI
PROJECT LEADER:	DELLA SANTA
DESIGN FILE NAME:	78D096/DESIGN/DD096CWRK.DGN
PLOT DATE:	31-JUL-2001
DRAWN BY:	SQUAD B
SHEET 33/ OF 435	