


CHANNEL RIGHTS CROSS SECTIONS

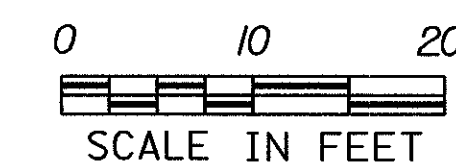

PROJECT NAME:	SEARSBURG - WILMINGTON
PROJECT NUMBER:	NHF 010-1(18)
PLOT FILE NAME:	DD096CR2
PROJECT LEADER:	DELLA SANTA
DESIGN FILE NAME:	78D096/DESIGN/DD096CWRK.DGN
PLOT DATE:	31-JUL-2001
DRAWN BY:	SQUAD B
SHEET 332 OF 435	