


DATE	
BY	
SURVEYED	
PLOTTED	
TEMPLATE	
AREAS	
CHECKED	
ORIGINAL SURVEY	
NOTE BOOK	
NO.	

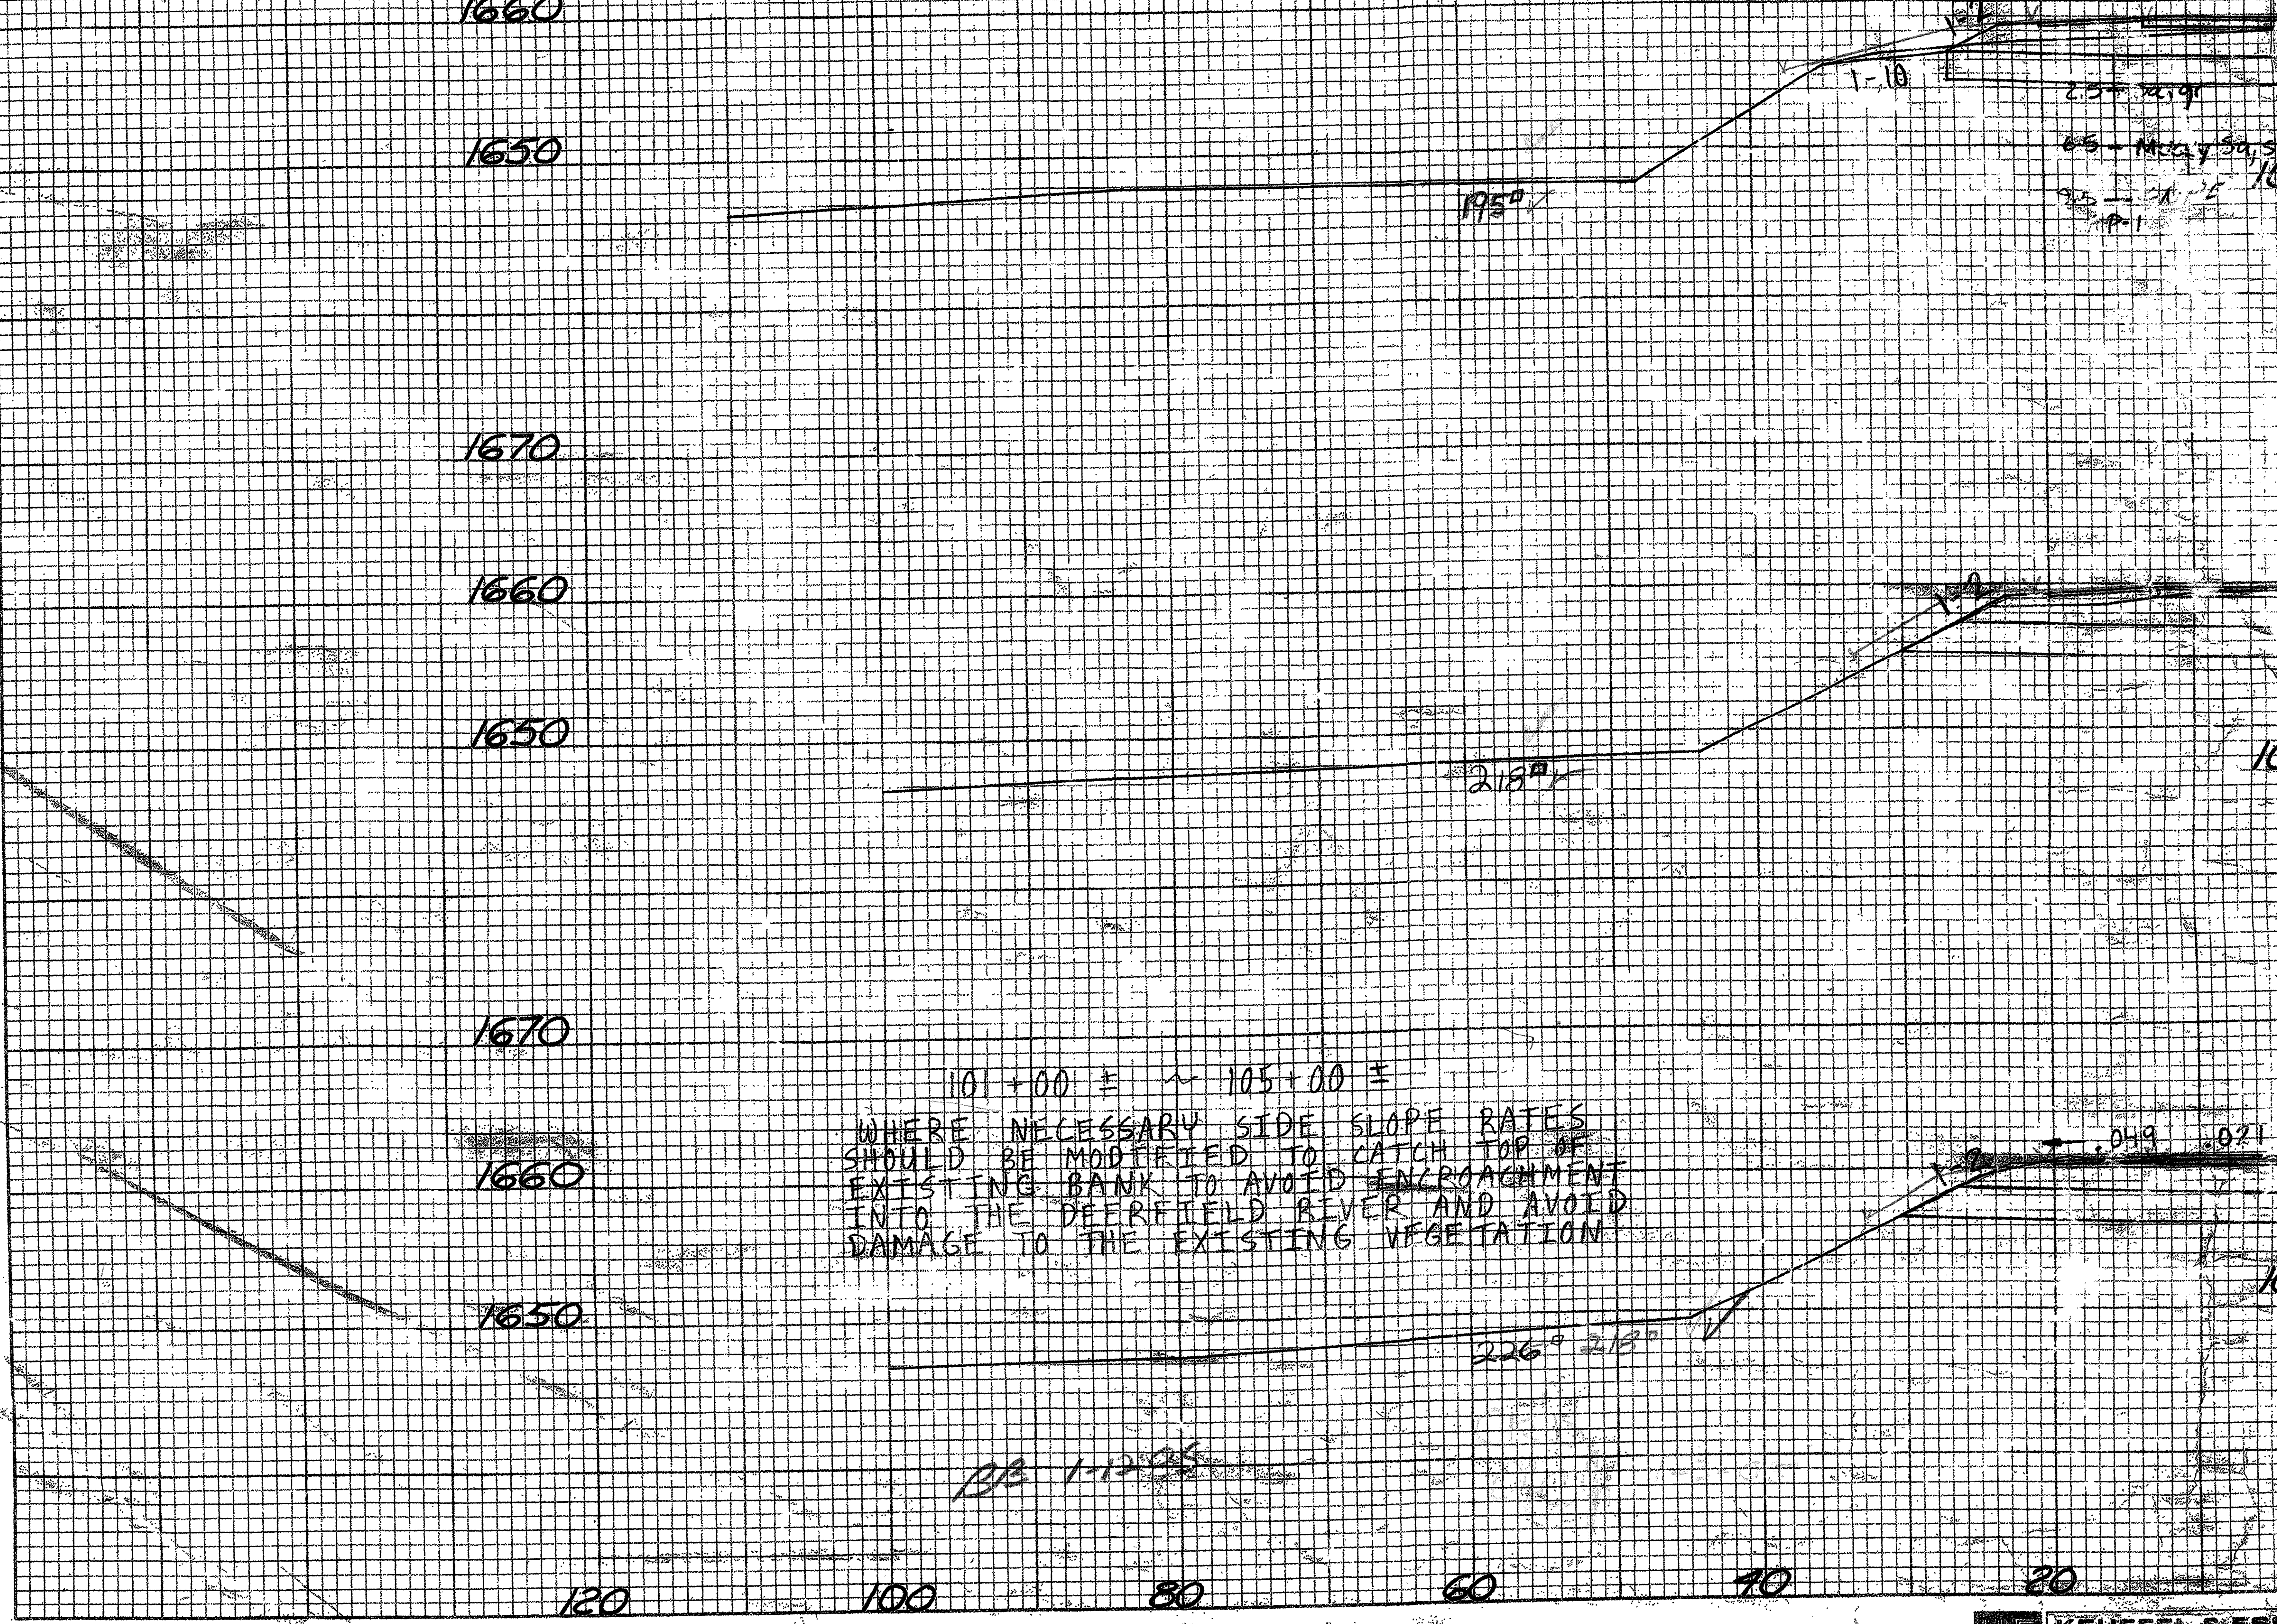

101+00 ± ~ 105+00 ±
 WHERE NECESSARY SIDE SLOPE RATES
 SHOULD BE MODIFIED TO CATCH TOP OF
 EXISTING BANK TO AVOID ENCROACHMENT
 INTO THE DEERFIELD RIVER AND AVOID
 DAMAGE TO THE EXISTING VEGETATION