

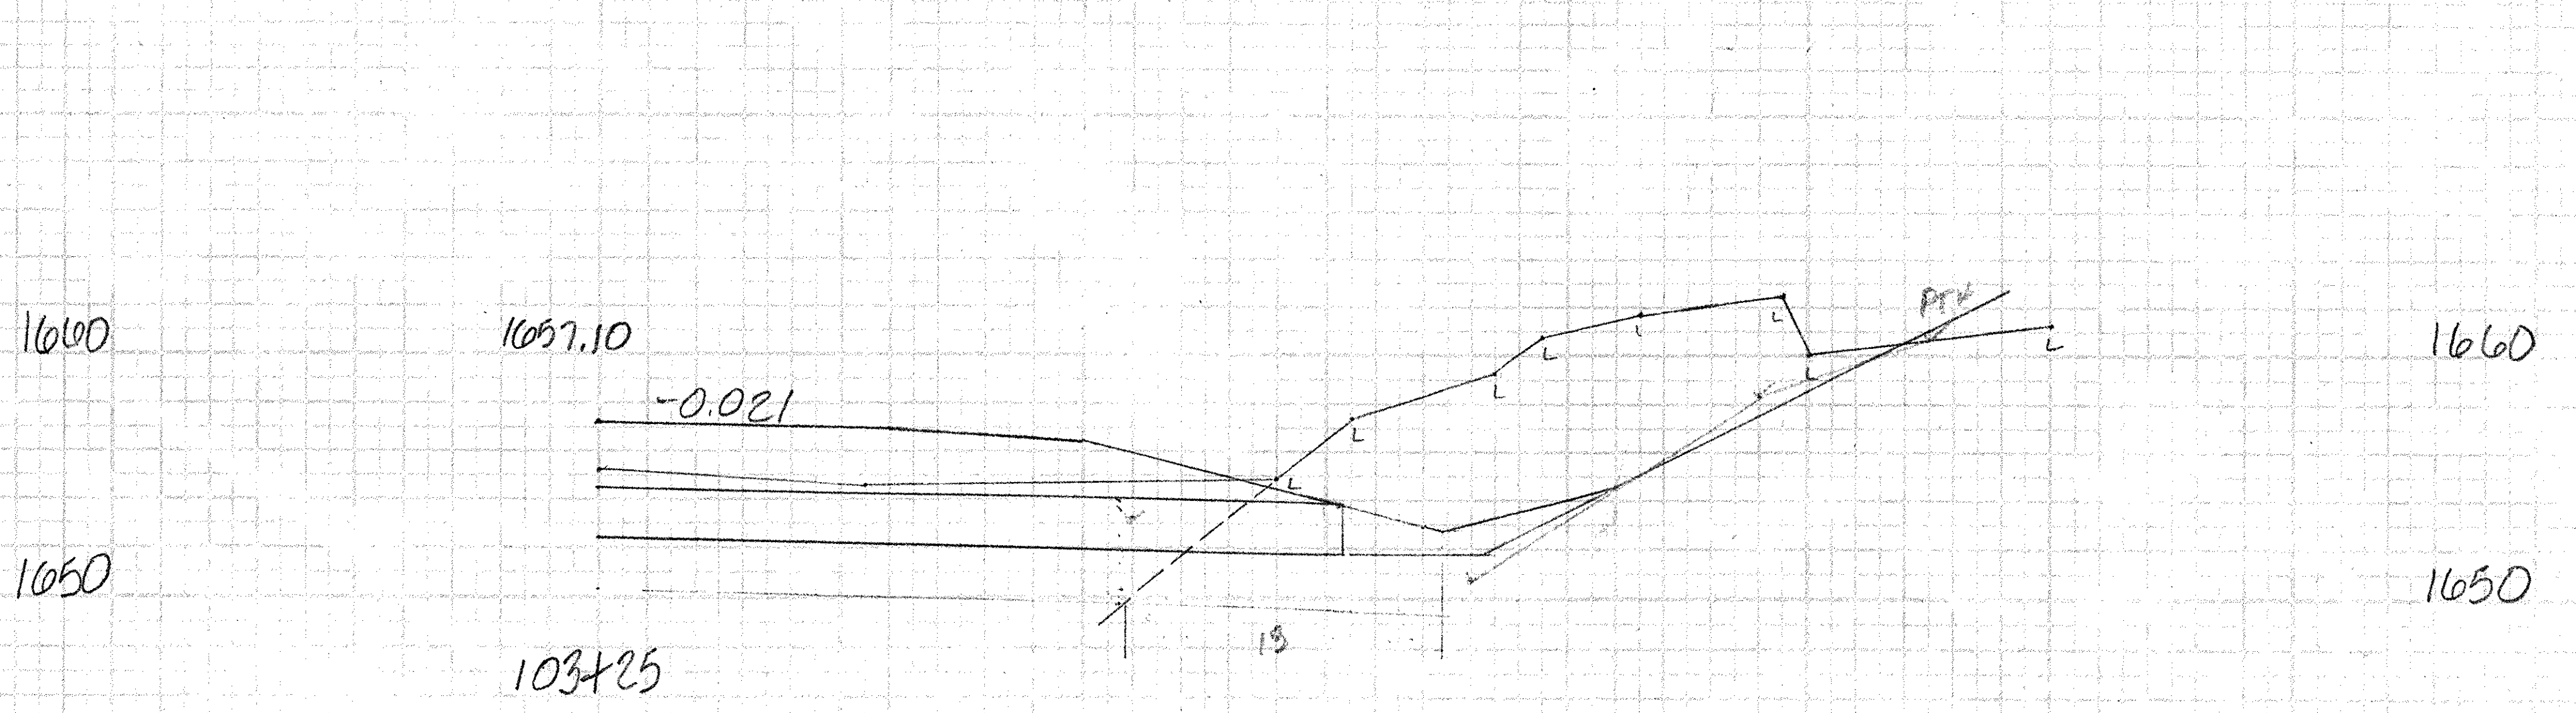
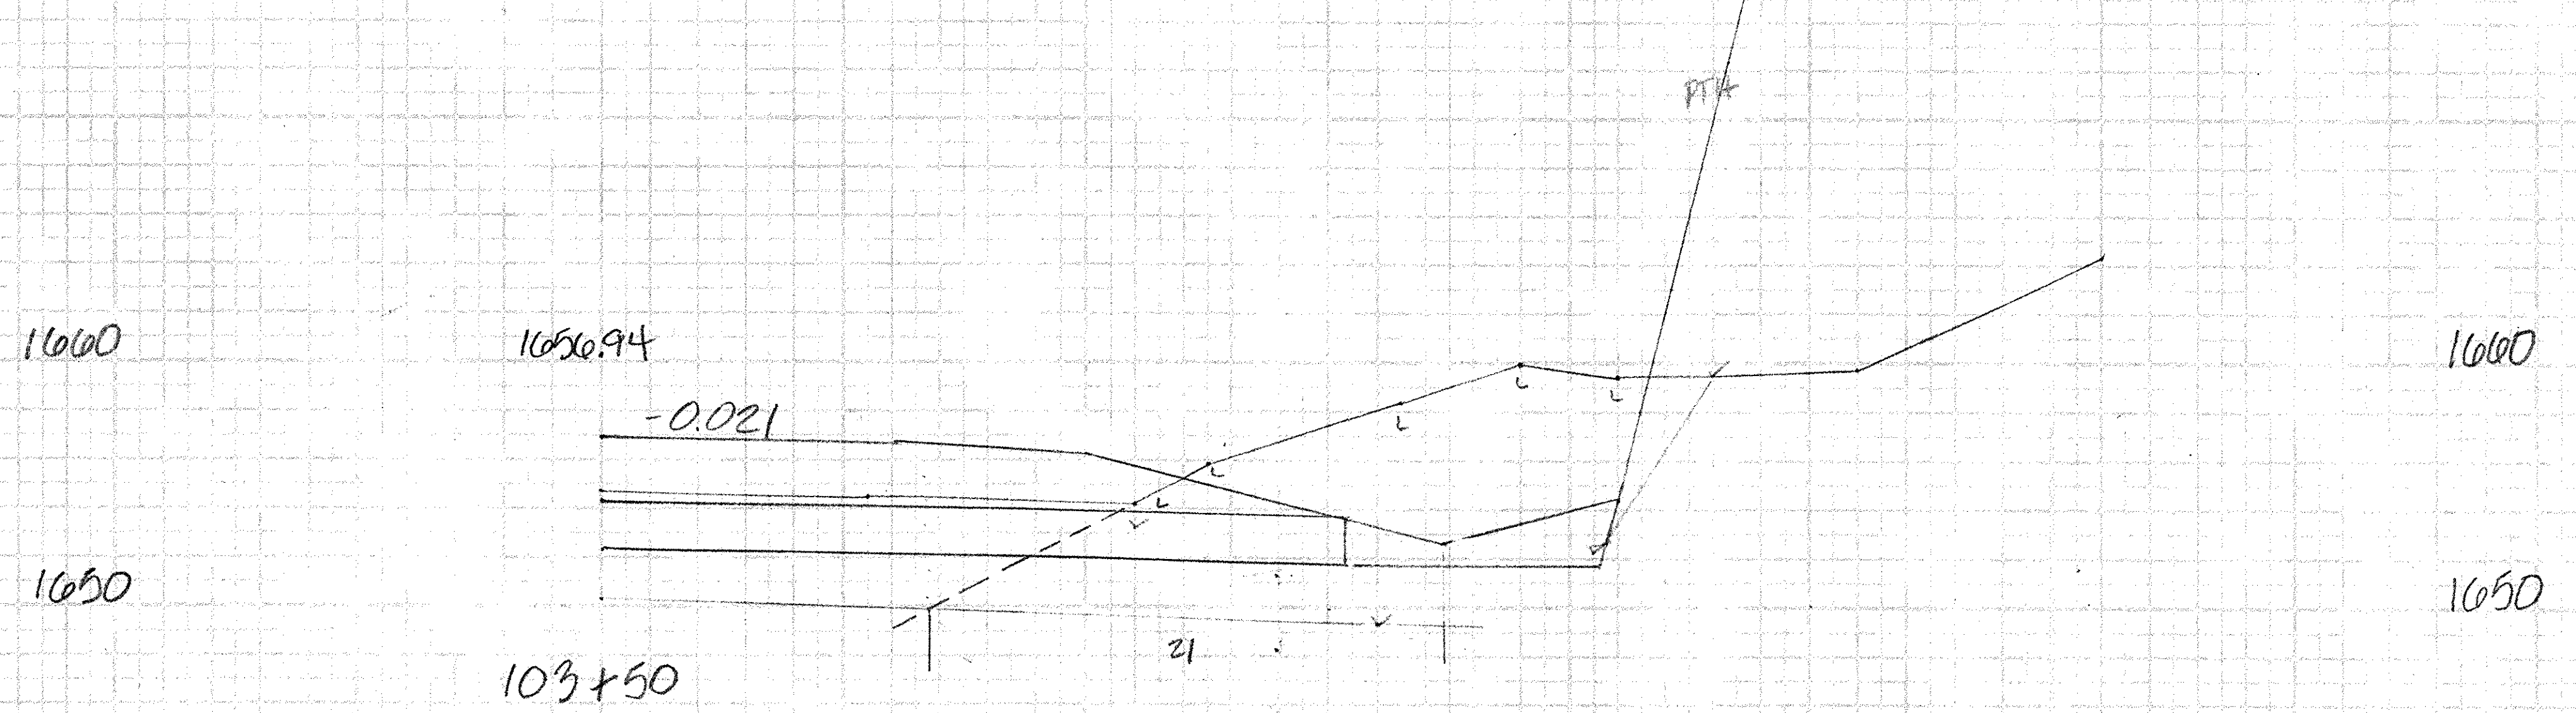
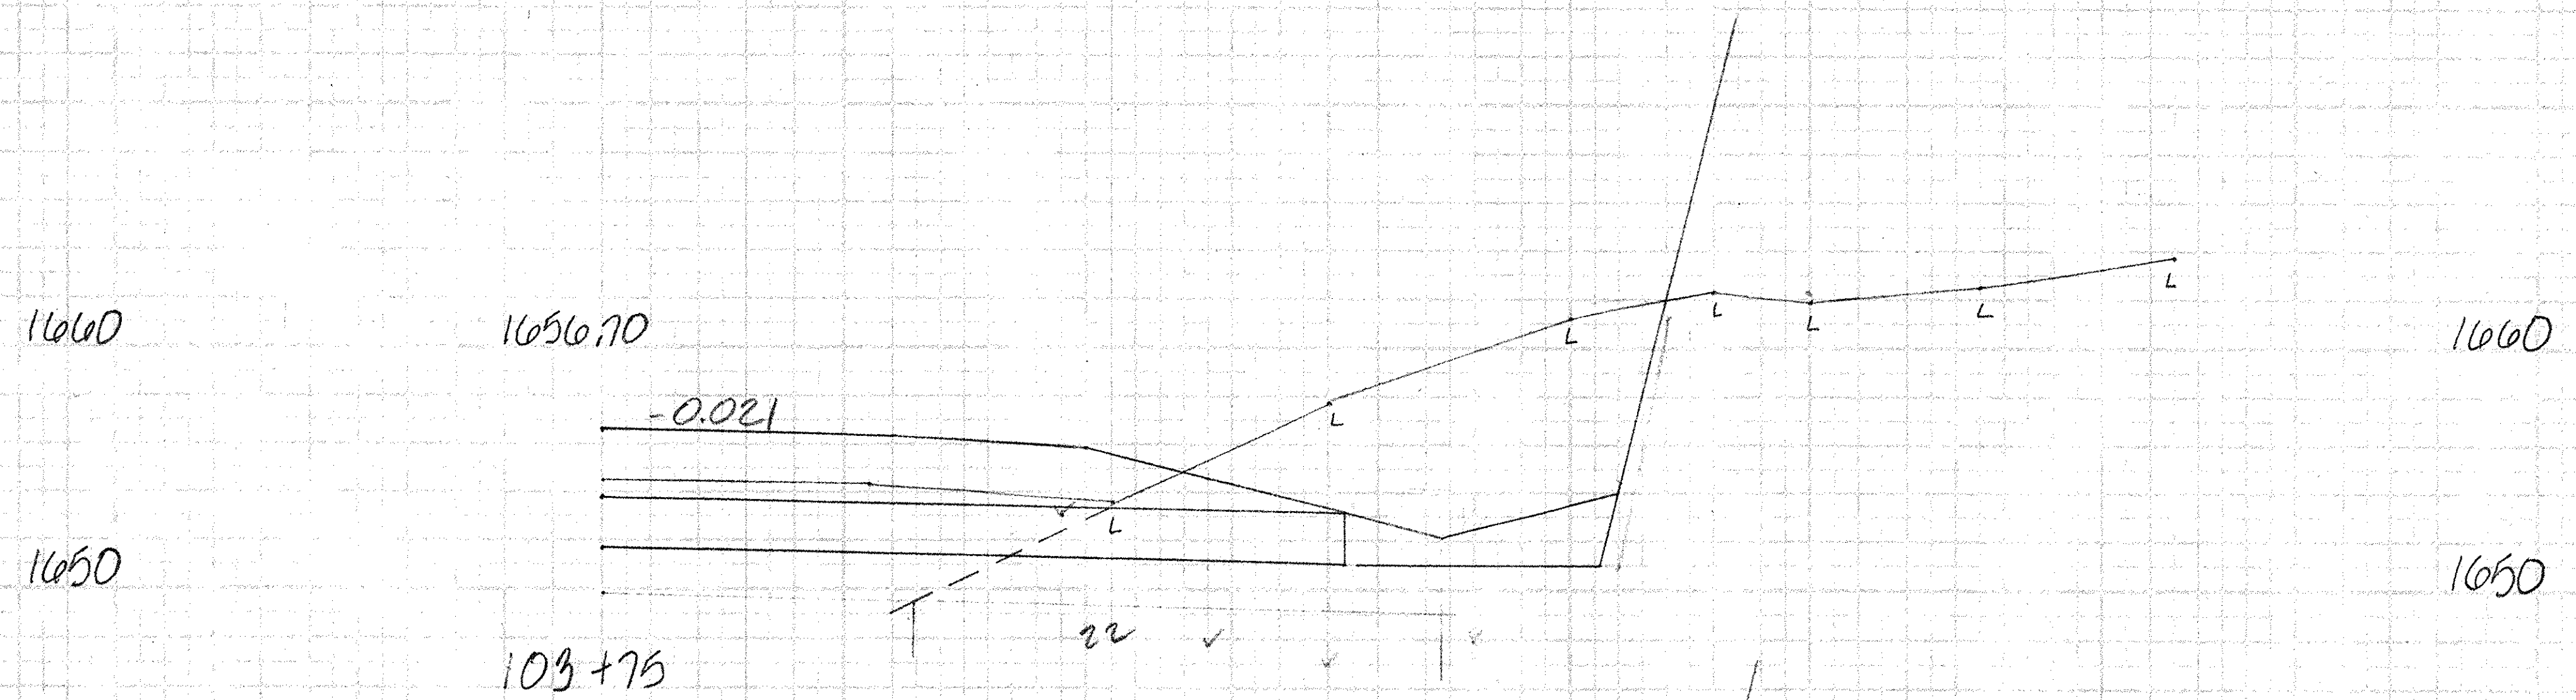
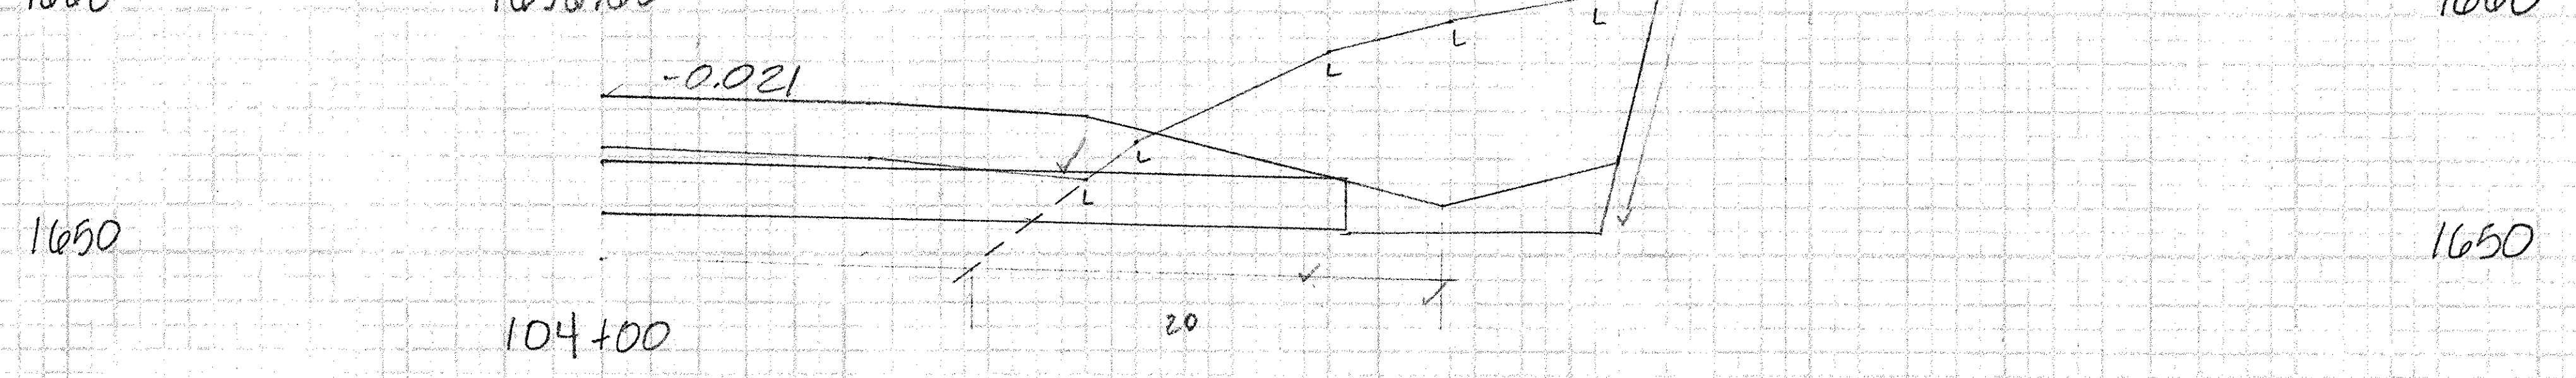
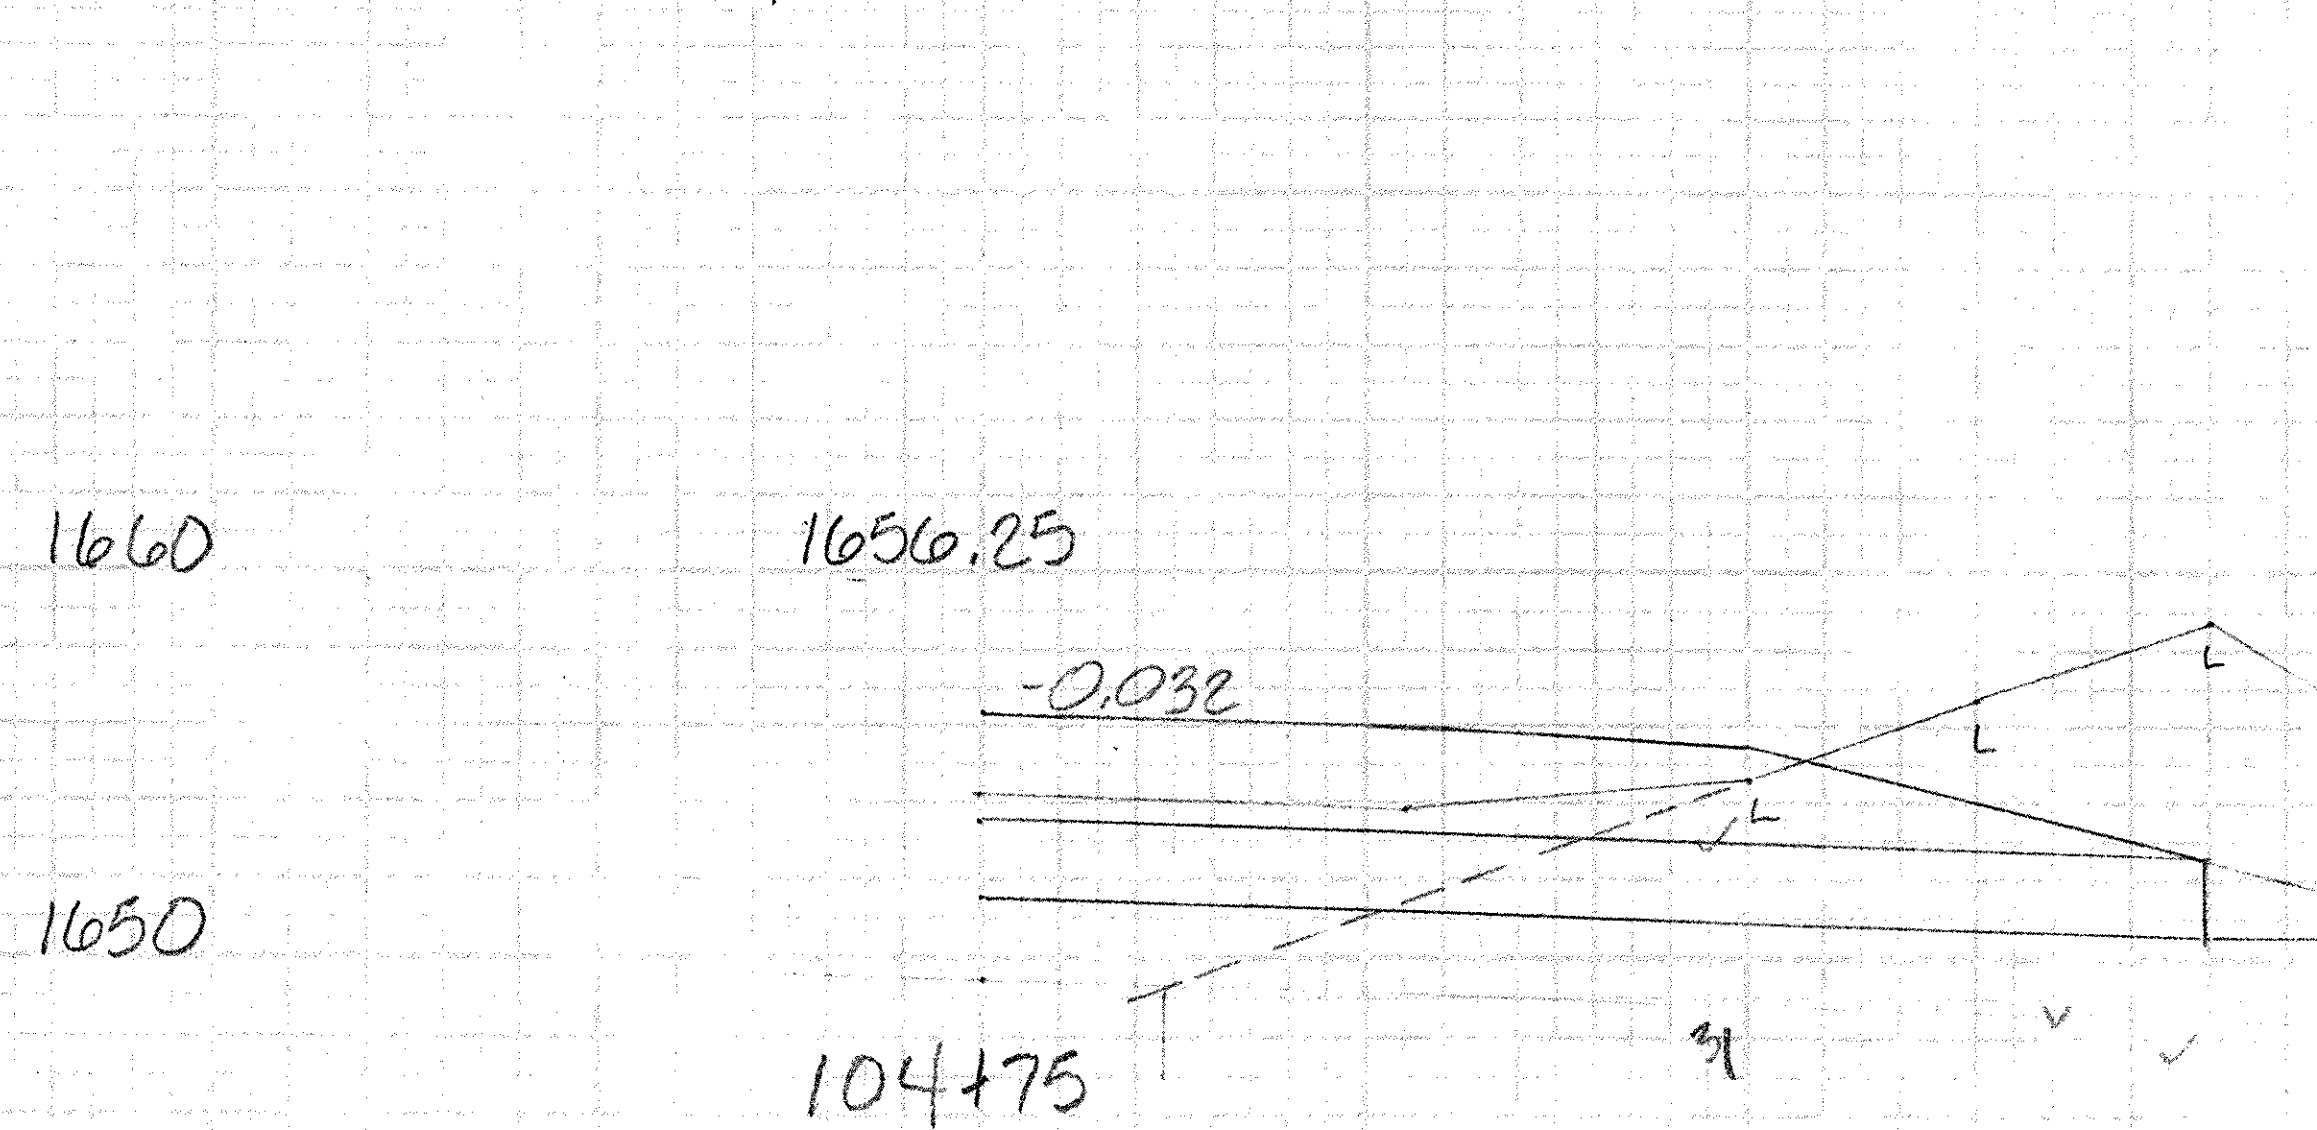
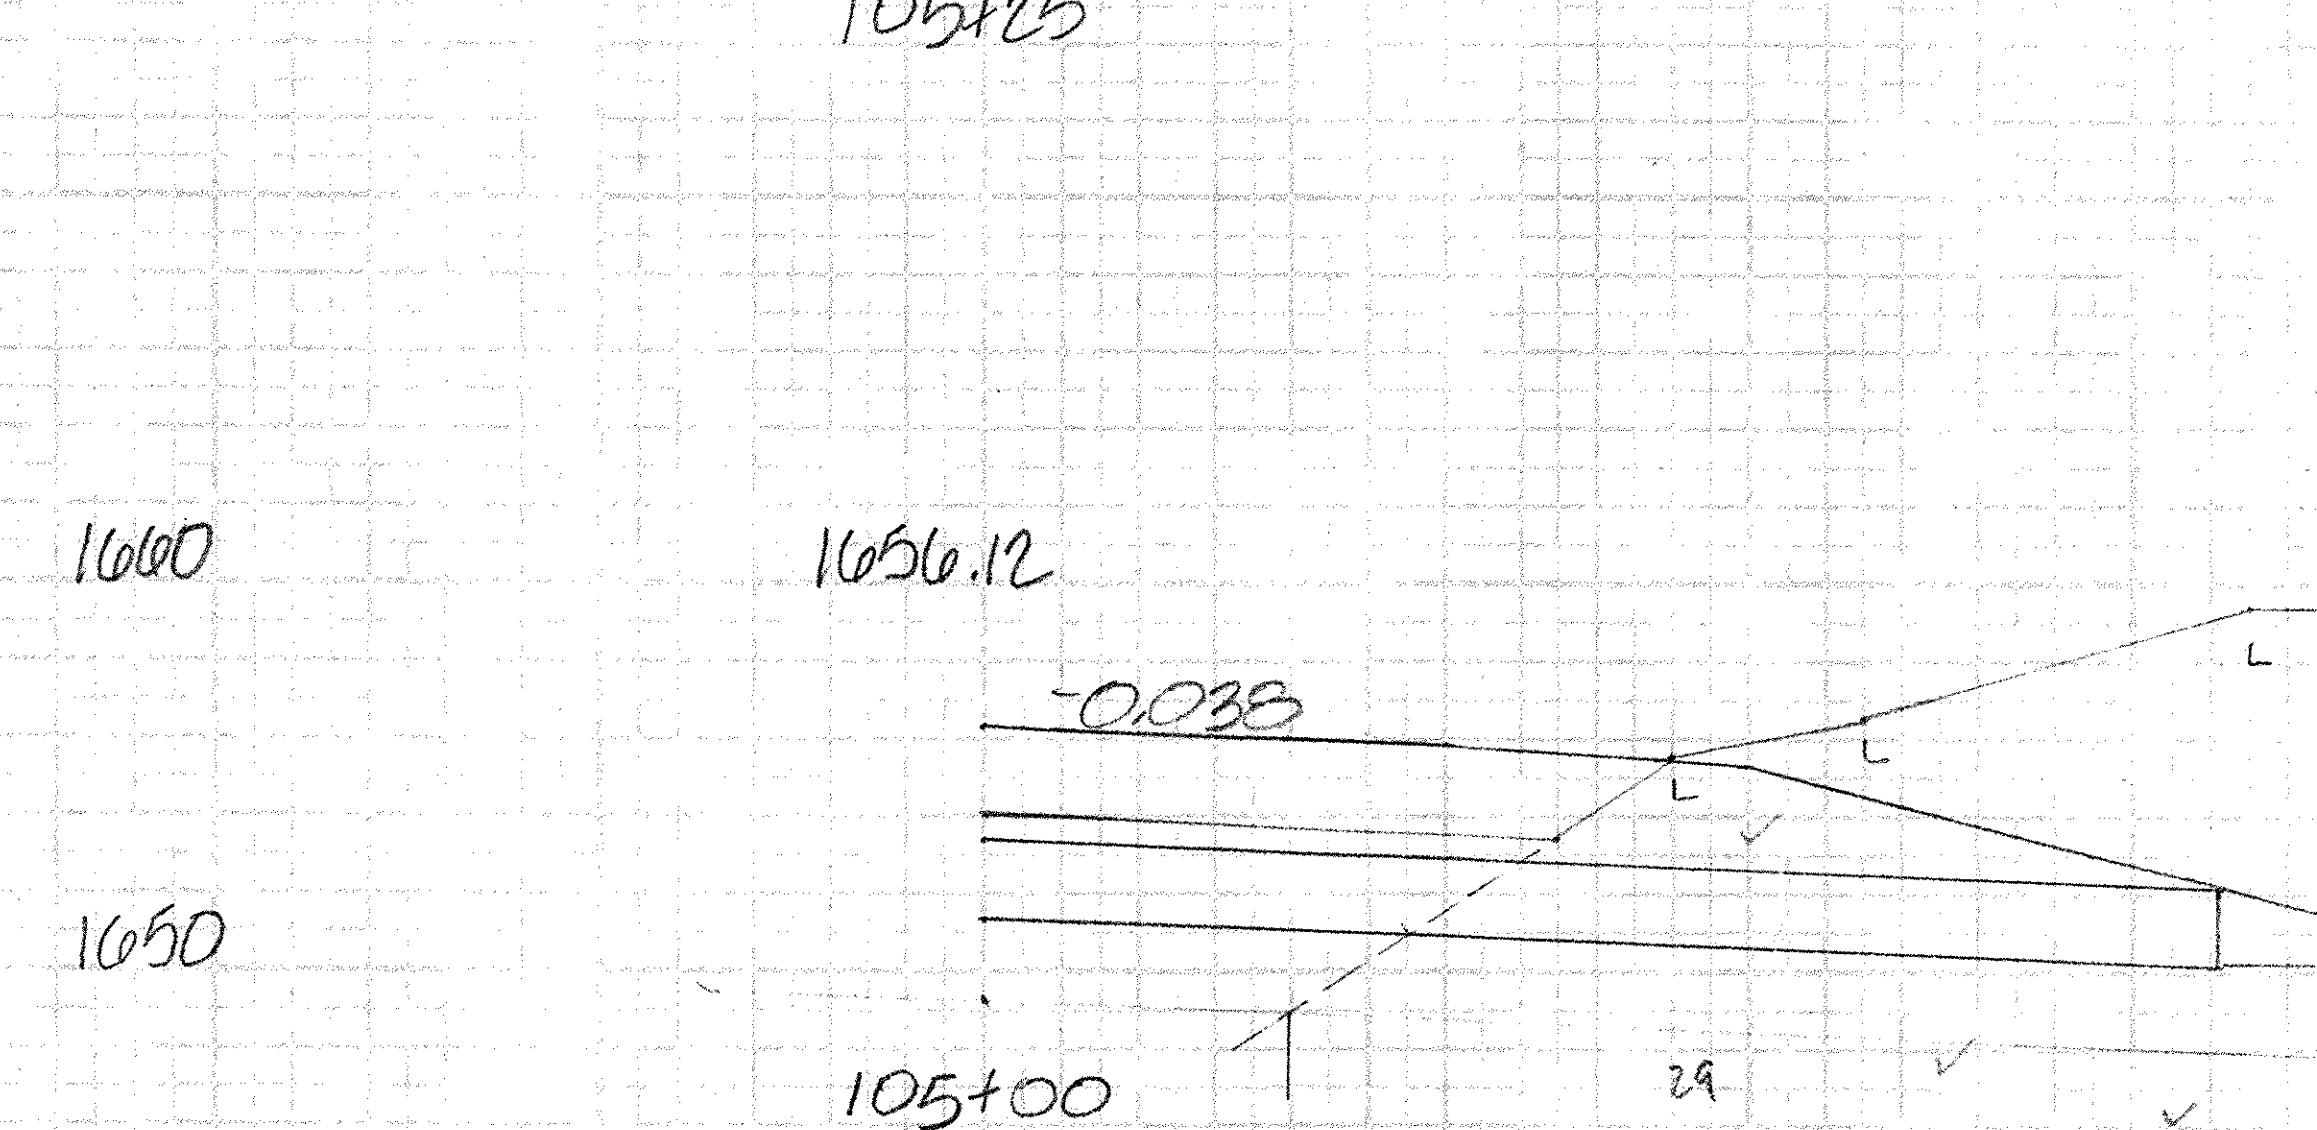


ORIGINAL SURVEYED BY DATE  
 SURVEY PLOTTED  
 NOTE BOOK NO. DATE  
 AREA CHECKED NO.

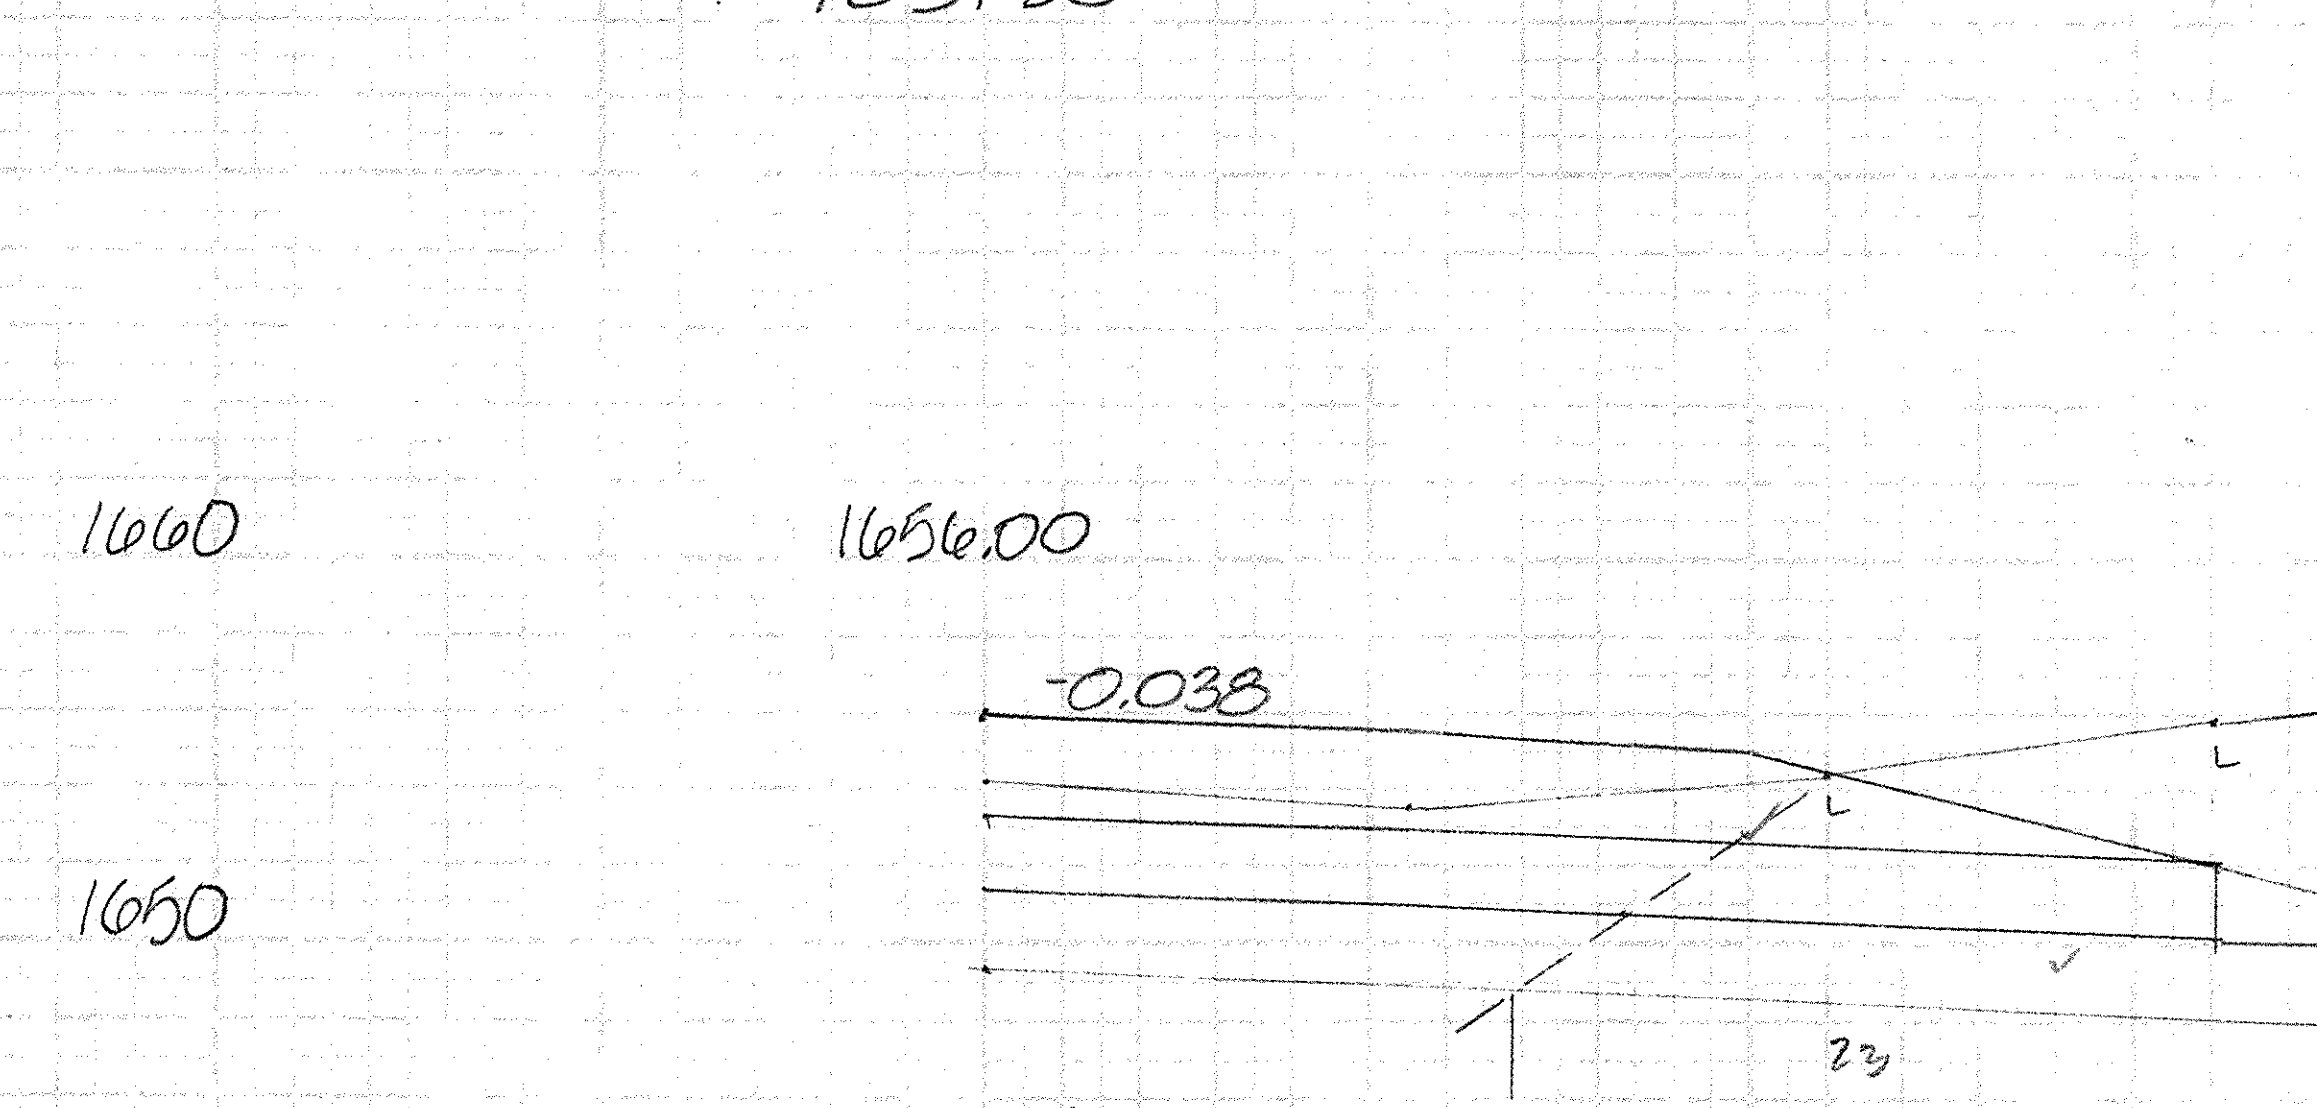

E

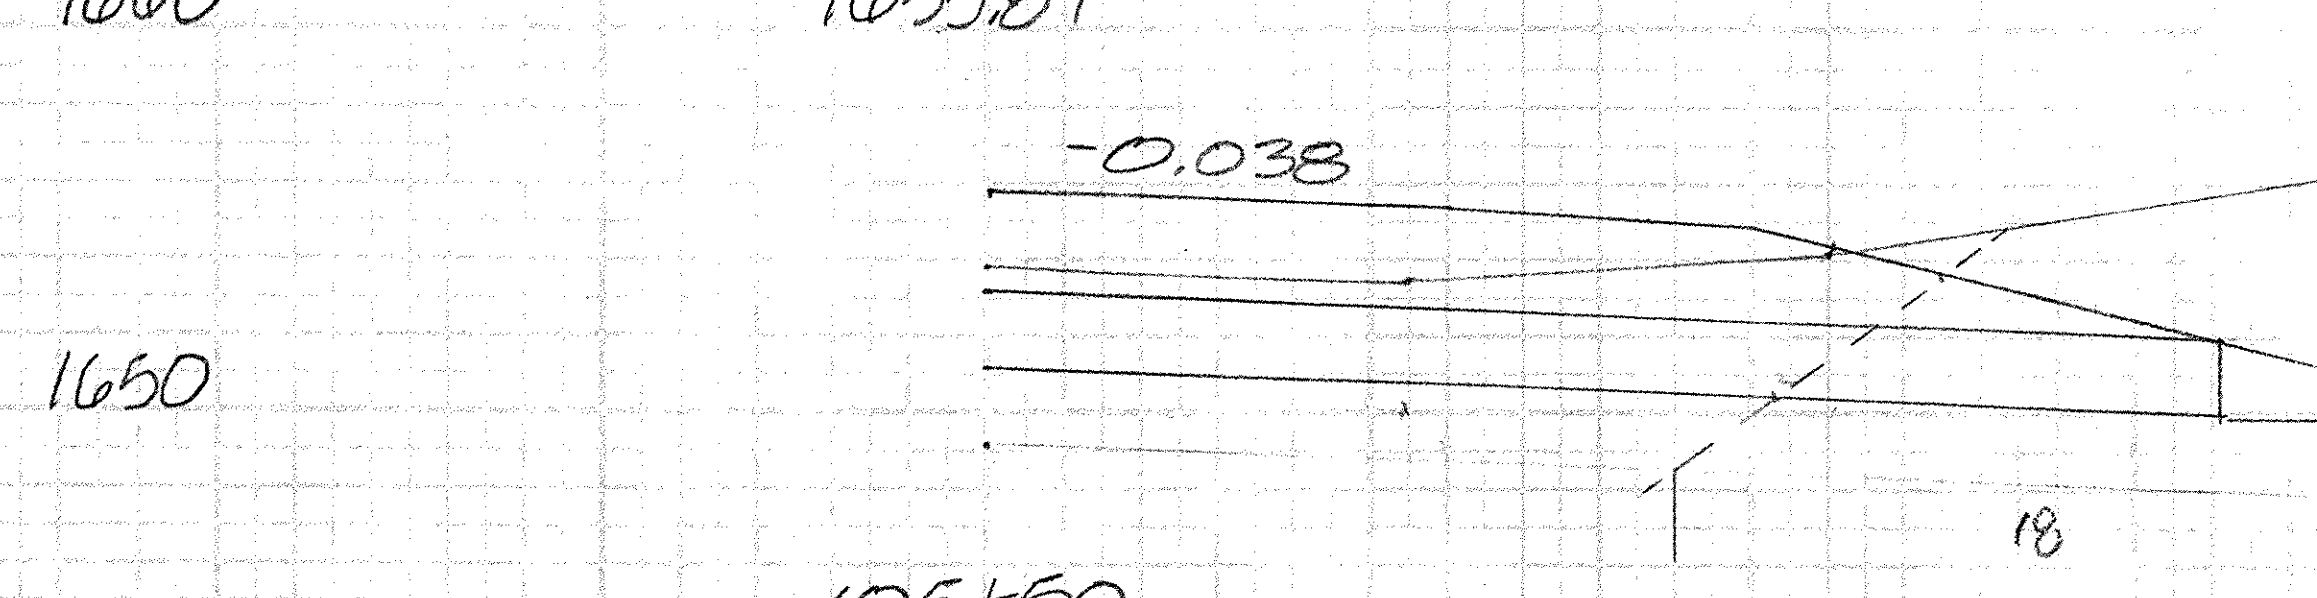

E