



112+00


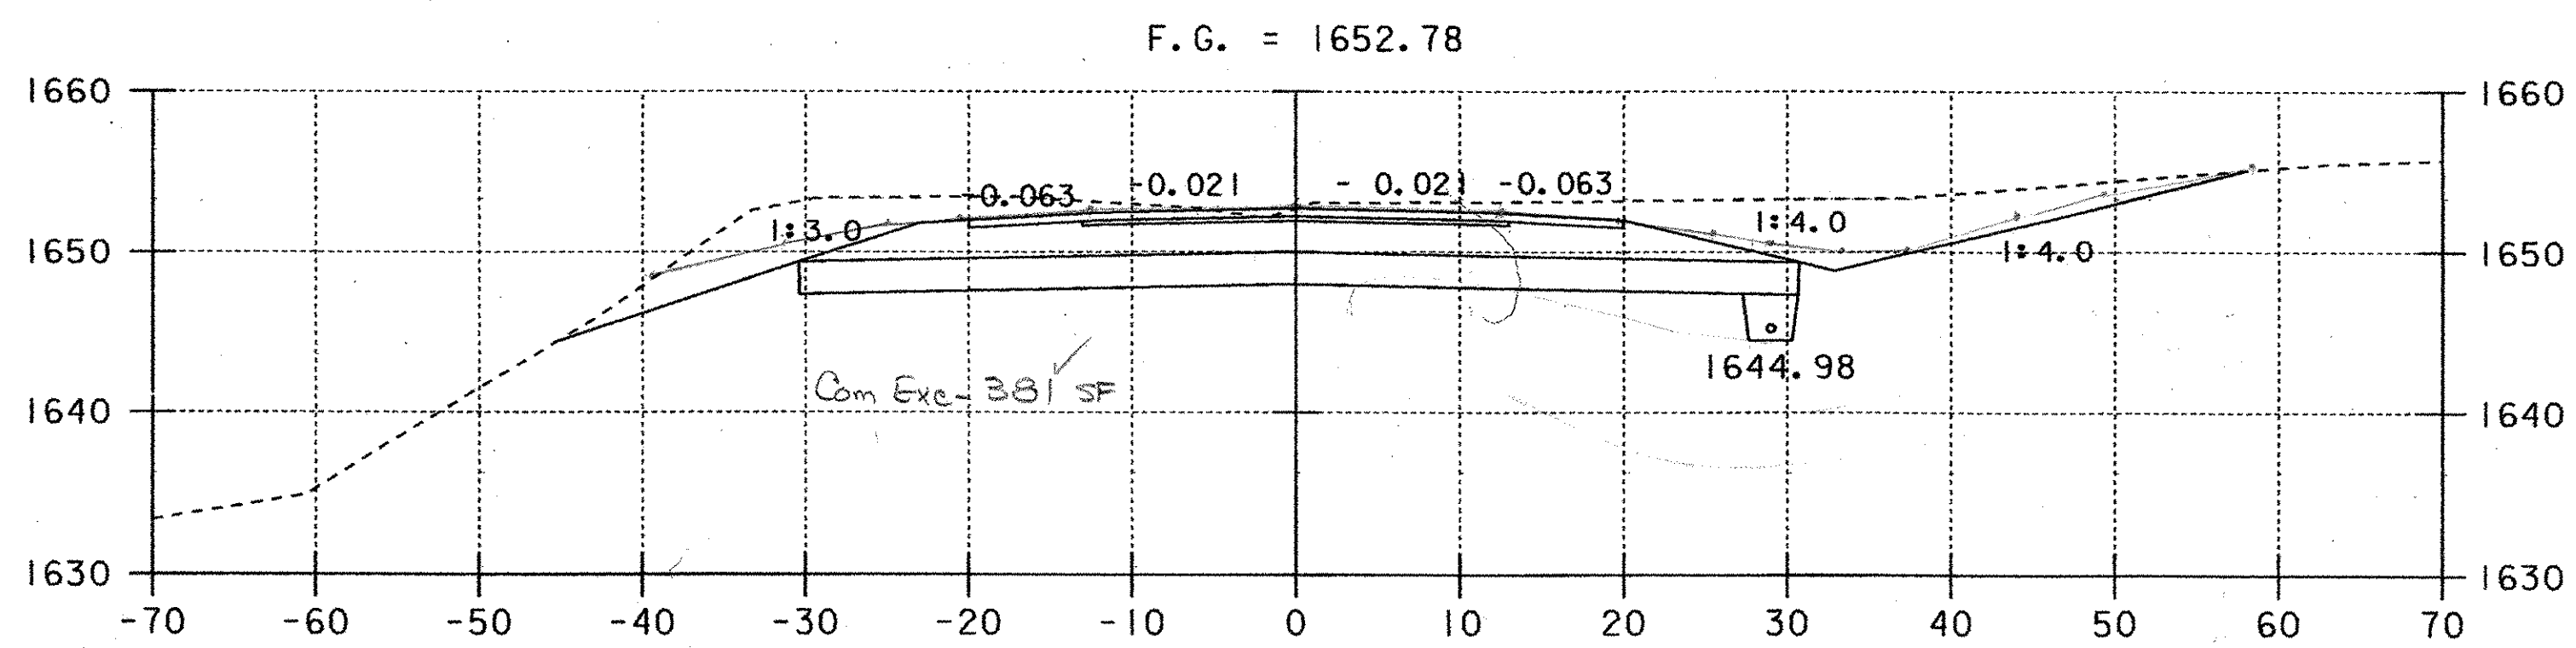


111+50

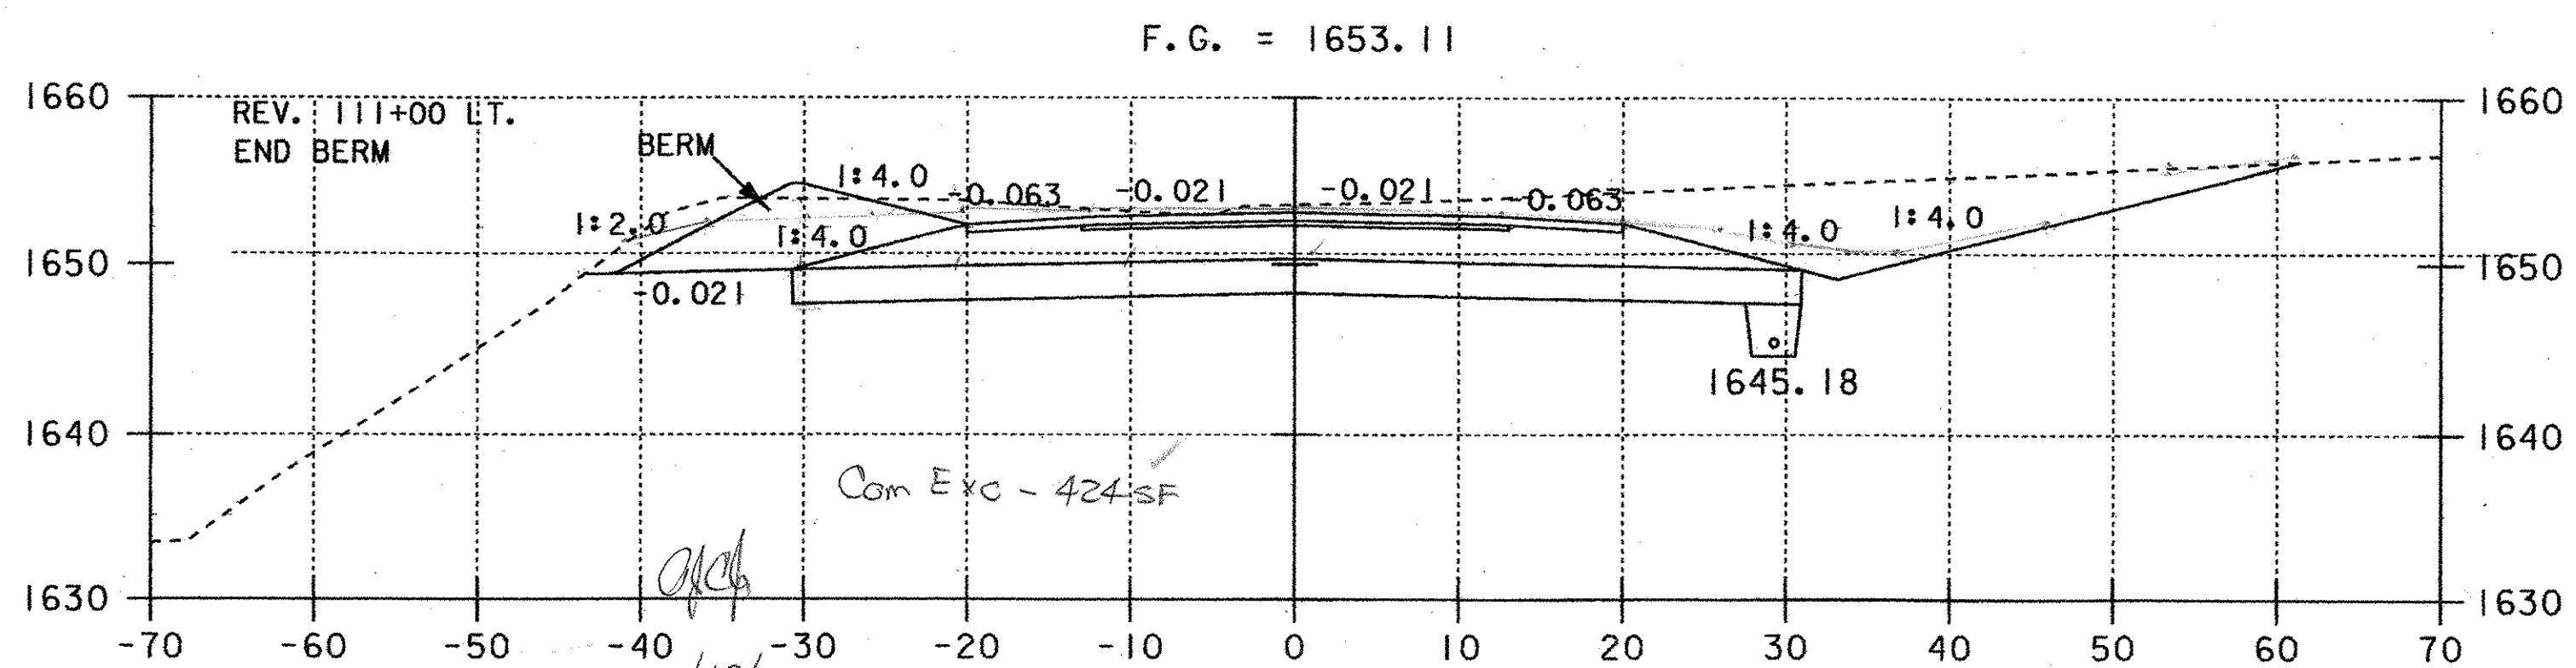


111+00


REV. PT 110+53.95 BK. =  
110+54.92 ADH.  
EQ. = -0.97'

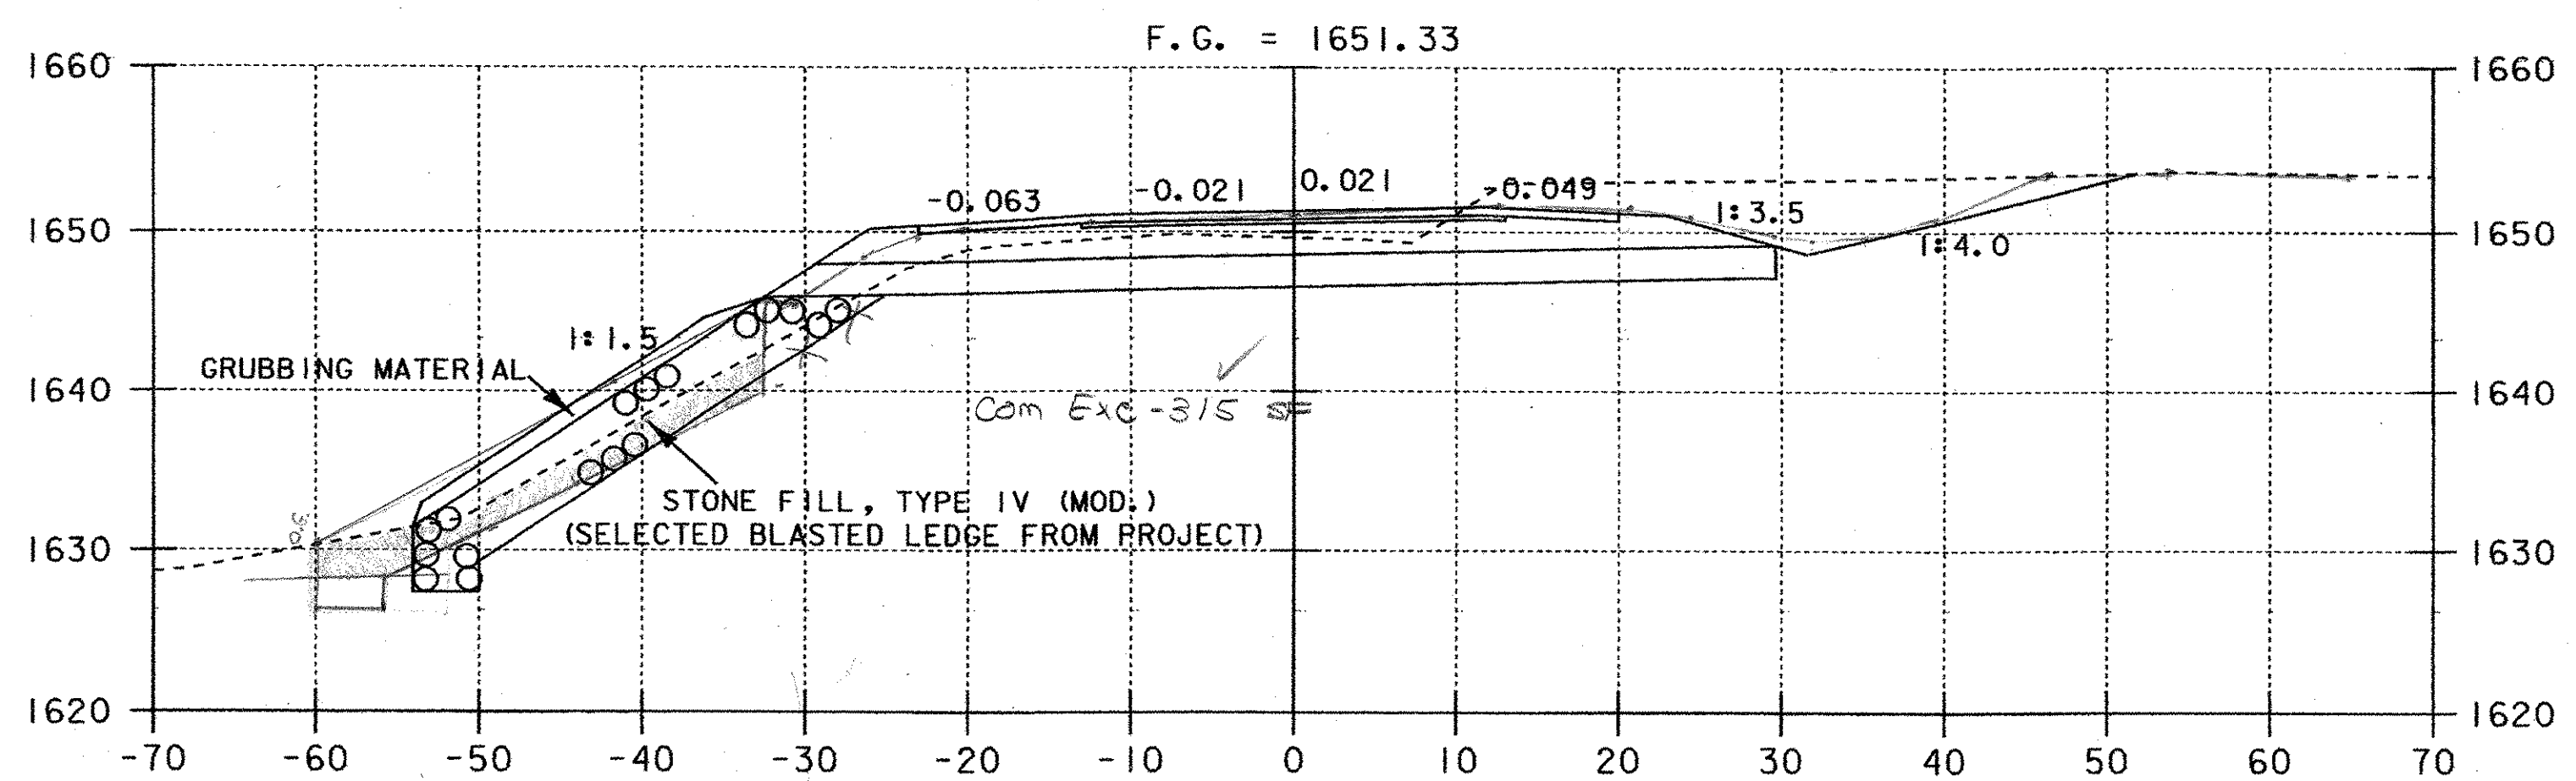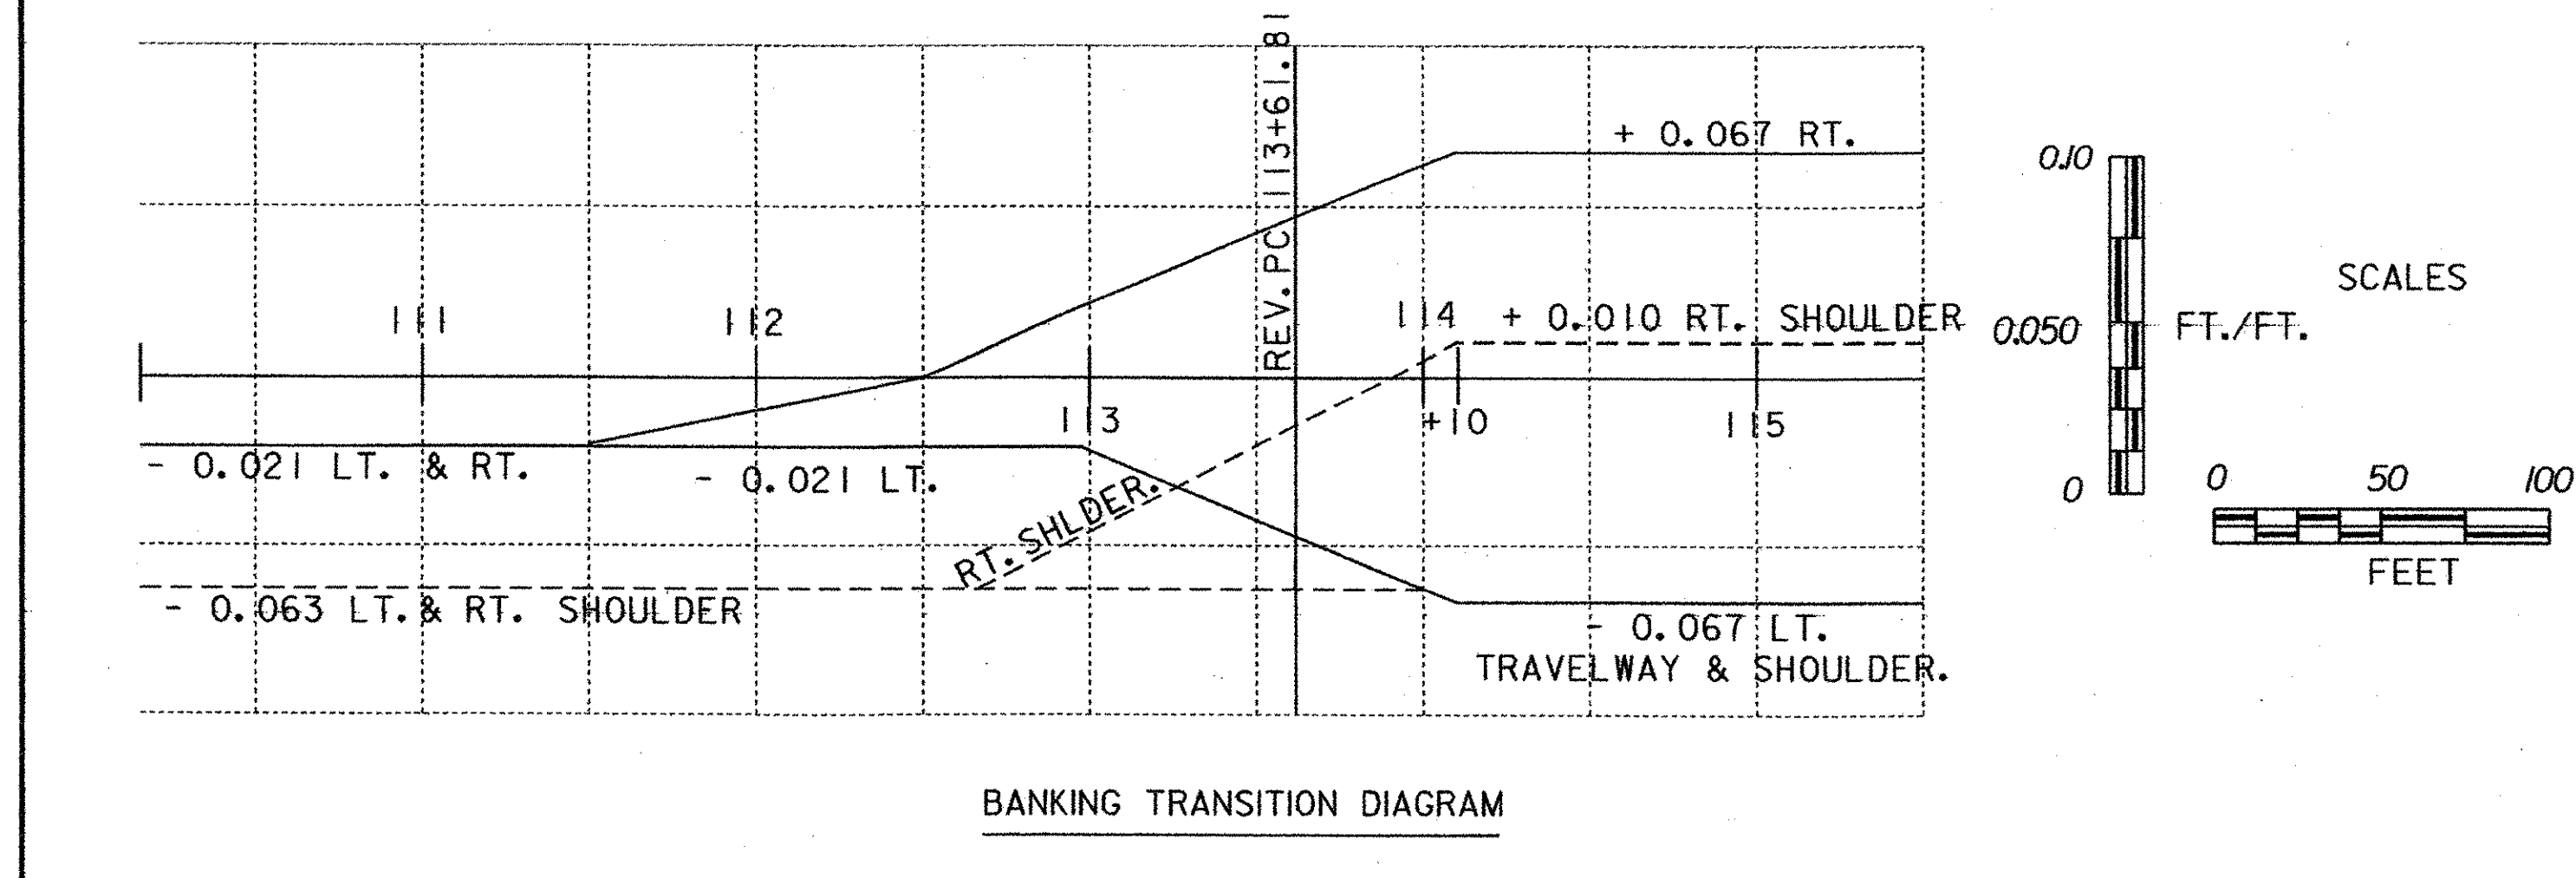

113+00

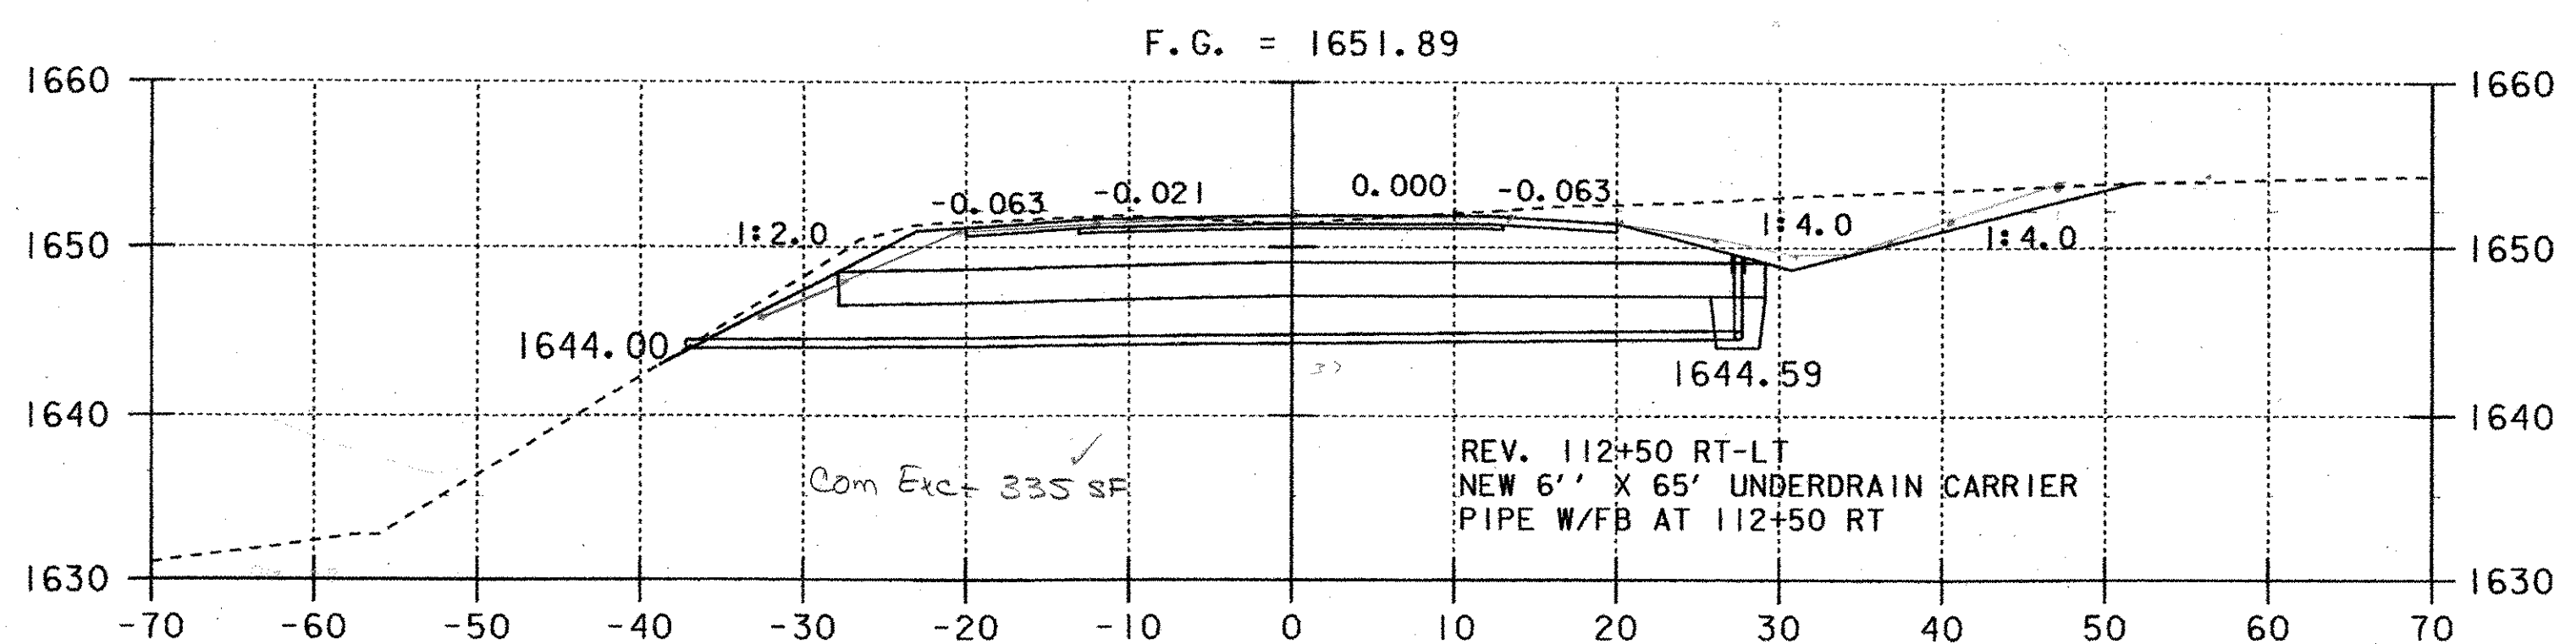

112+50

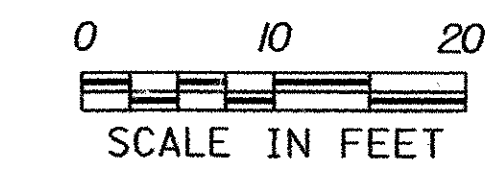

PROJECT NAME:	SEARSBURG - WILMINGTON
PROJECT NUMBER:	NHF 010-1(18)
PLOT FILE NAME:	DD096X01
PROJECT LEADER:	DELLA SANTA
DESIGN FILE NAME:	78D096/DESIGN/DD096CWRK.DGN
PLOT DATE:	18-JAN-2002
DRAWN BY:	SQUAD B
SHEET 339 OF 435	