



114+50

STONE TYPE III MOD 2 70# ✓
 GEO UNDER S.F = 8 LF ✓
 RB 4-7-05

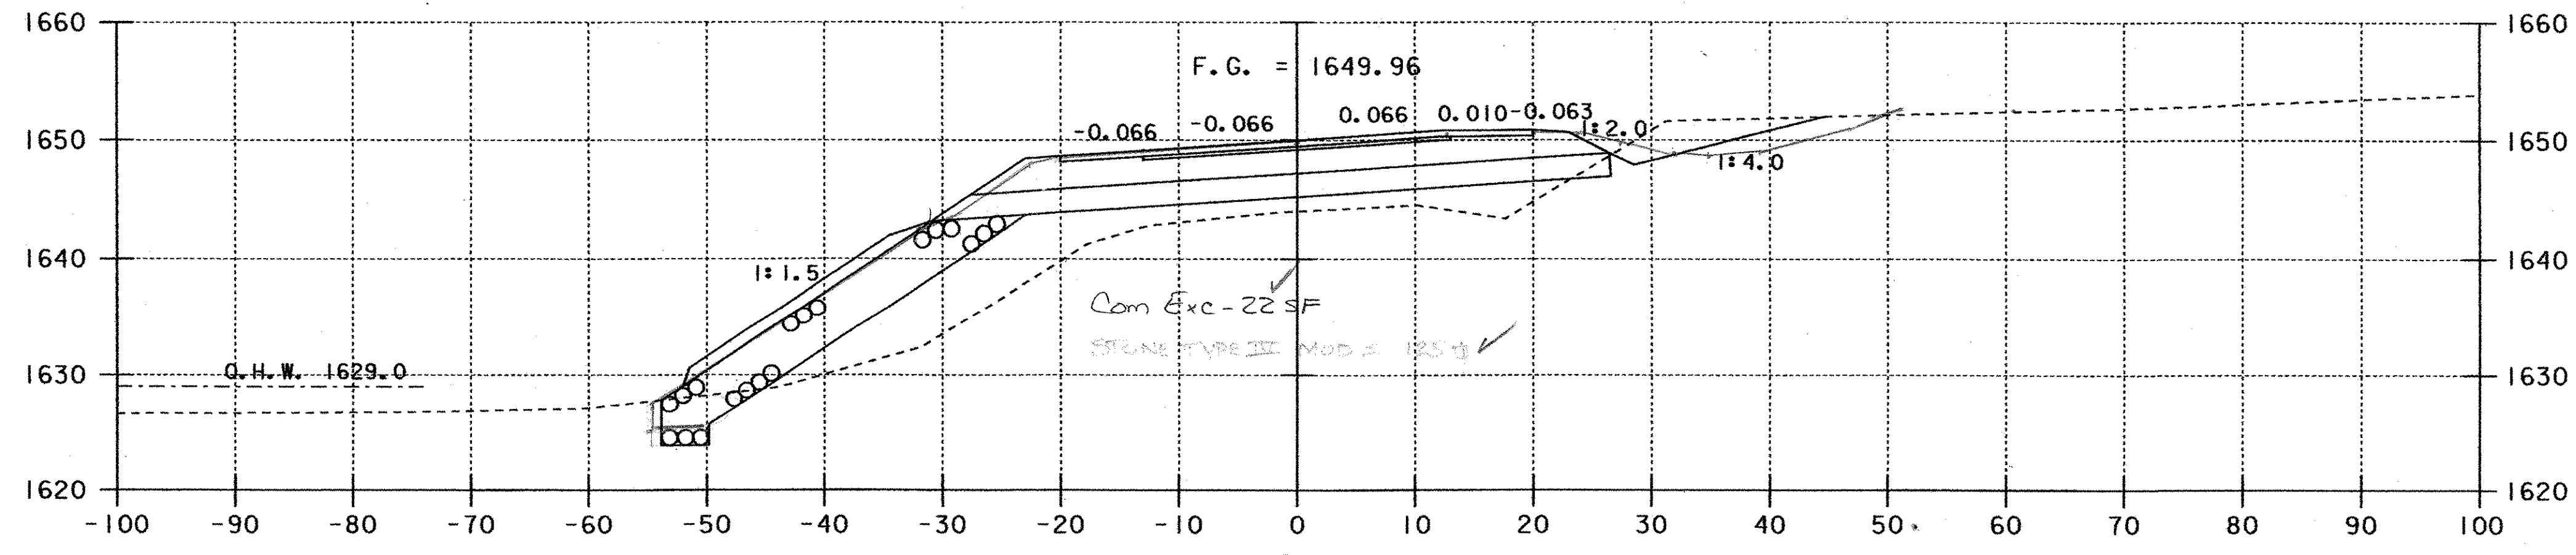


114+00

Com Exc - 22 SF ✓
 STONE TYPE III MOD 2 70# ✓
 GEO UNDER S.F = 7 LF ✓
 RB 4-7-05

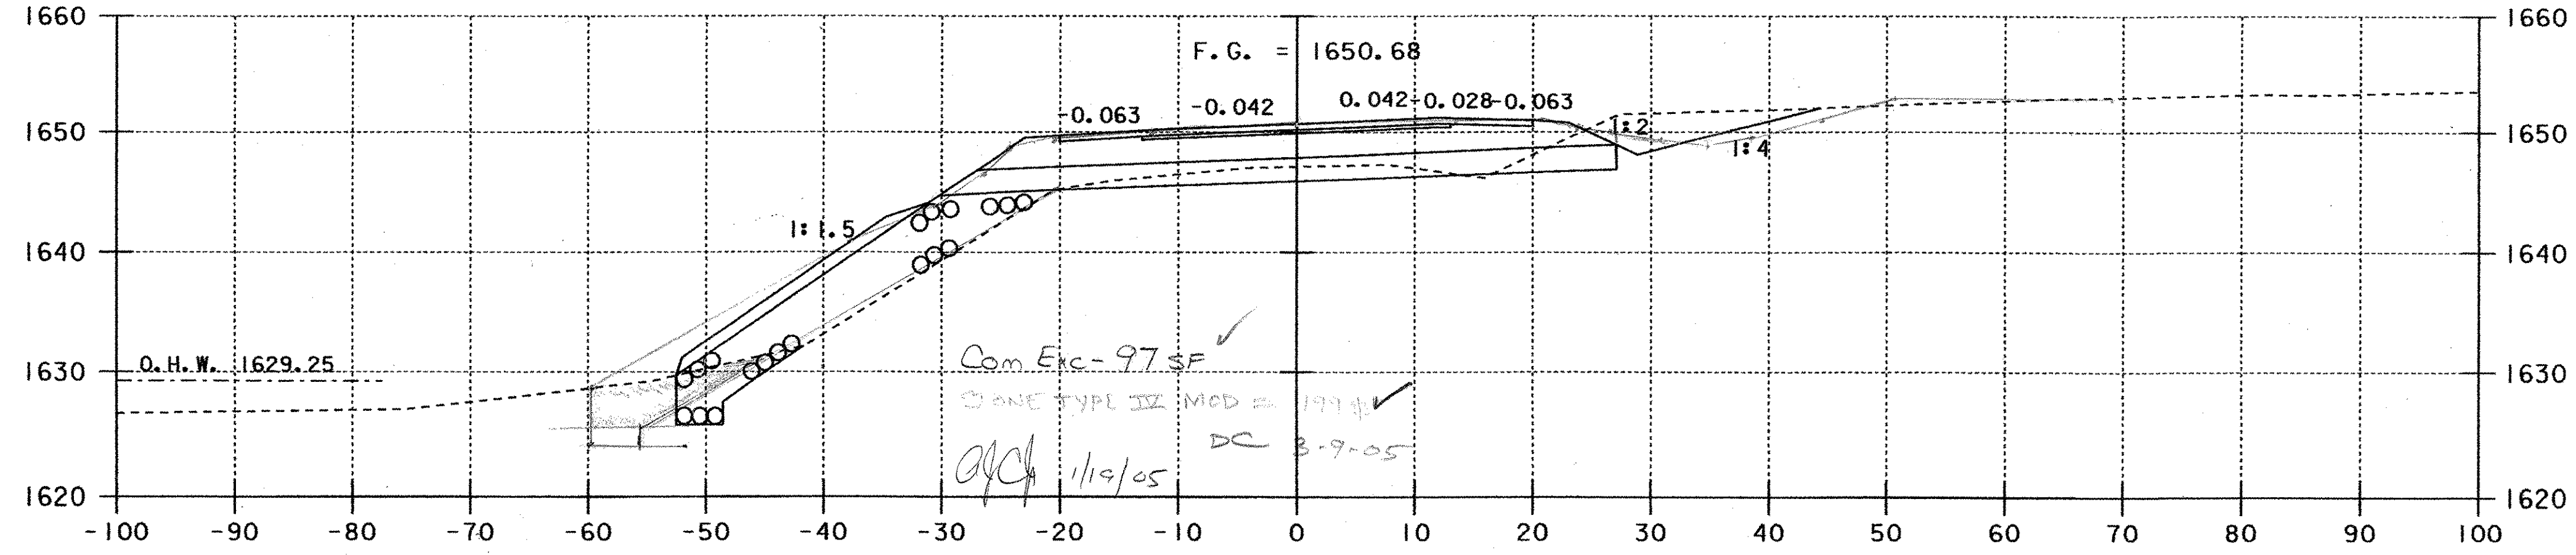

113+50

Com Exc - 97 SF ✓
 STONE TYPE III MOD 2 100# ✓
 DC 3-9-05
 DC 3-17-05
 RB 4-7-05
 DC 3-10-05

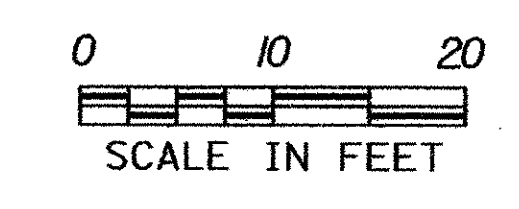

PROJECT NAME:	SEARSBURG - WILMINGTON		
PROJECT NUMBER:	NHF 010-1(18)		
PLOT FILE NAME:	DD096X02	PLOT DATE:	11-JUL-2001
PROJECT LEADER:	DELLA SANTA	DRAWN BY:	SQUAD B
DESIGN FILE NAME:	78D096/DESIGN/DD096CWRK.DGN		SHEET 340 OF 435