


END STONE FILL TYPE IV MOD SAME AS 116+50 = 132' ϕ
 END GEO UNDER S.F = 10 LF SAME AS 116+50

BUTT TYPE III MOD 116+52 USE STA 116+50 SECTION = 132' ϕ
 F.G. = 1645.98

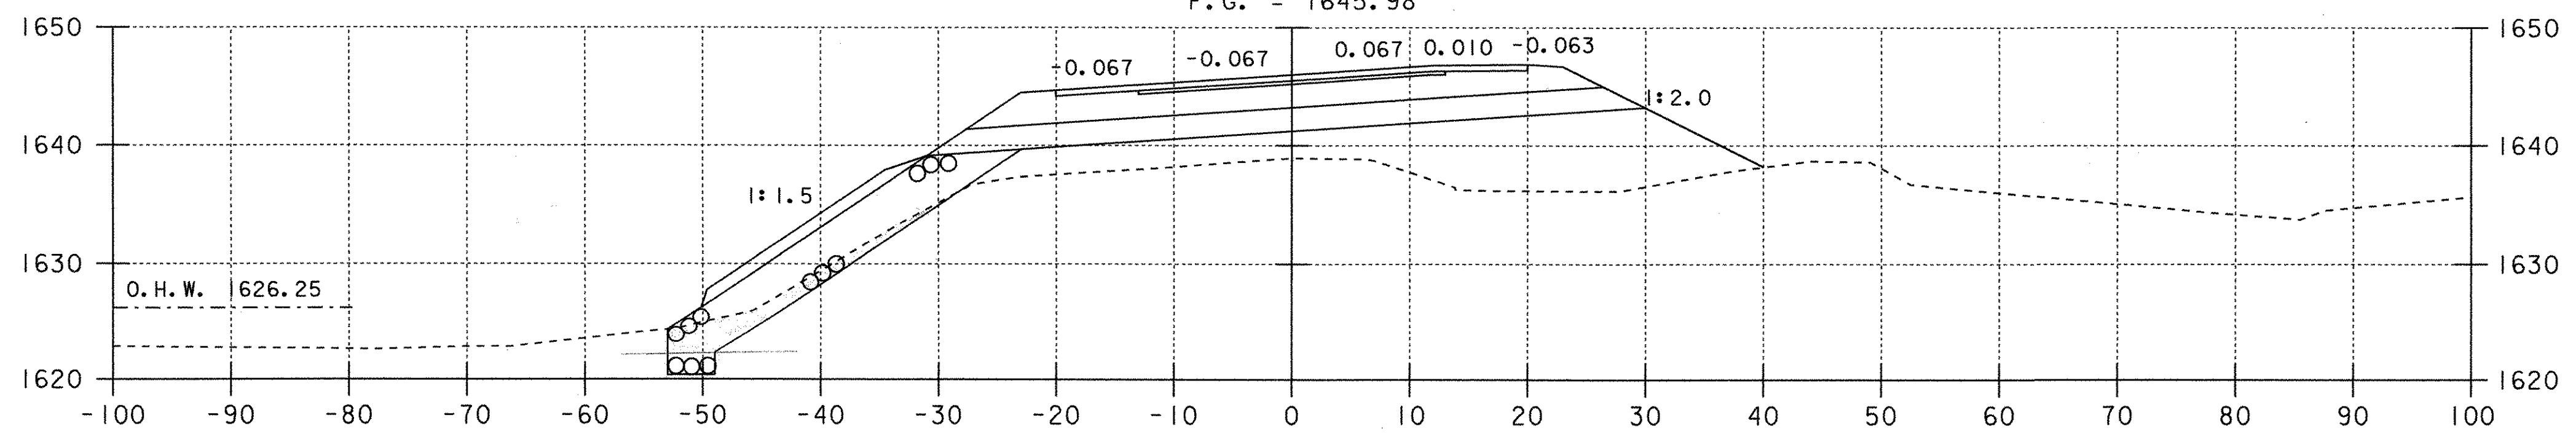


Keyway Exc PAID AS 203.27-UNCL CHAN Exc.
 SEE WRITTEN ORDER # 60
 Sta 116+50 ~ 117+0

Com Exc - 29 SF ✓

BUTT GEO UNDER S.F = 10 LF MATCH STA 116+50

1/27/05

12 4-7-05
 DC 3-16-05

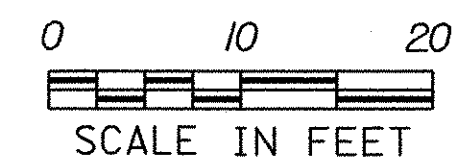

PROJECT NAME:	SEARSBURG - WILMINGTON	
PROJECT NUMBER:	NH 010-1(18)	
PLOT FILE NAME:	DD096X04	PLOT DATE: 27-NOV-20
PROJECT LEADER:	DELLA SANTA	DRAWN BY: SQUAD B
DESIGN FILE NAME:	78D096/DESIGN/DD096CWRK.DGN	SHEET 342 OF 435