




REV. 118+61.38
STOP ROADWAY BEGIN BRIDGE 25

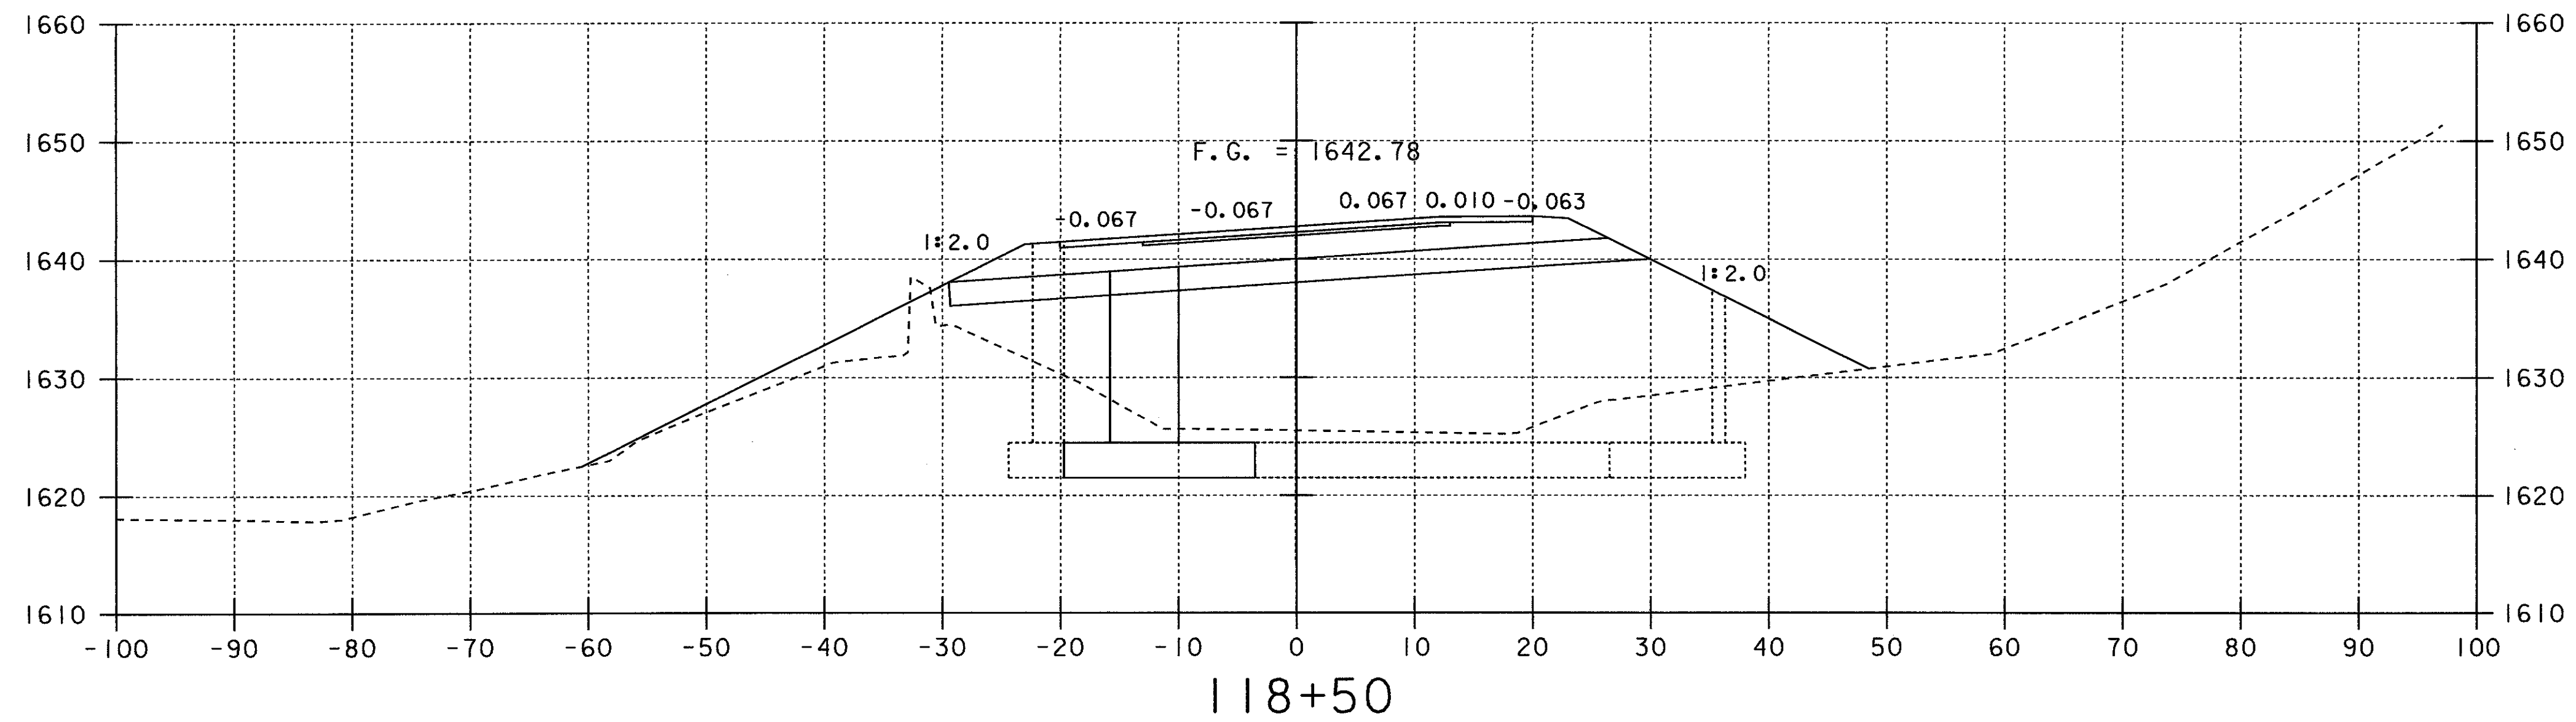

NOTE:
DASHED LINE INDICATES SUBSTRUCTURE
UPSTATION AND/OR DOWNSTATION OF
SECTION CUT LINE.

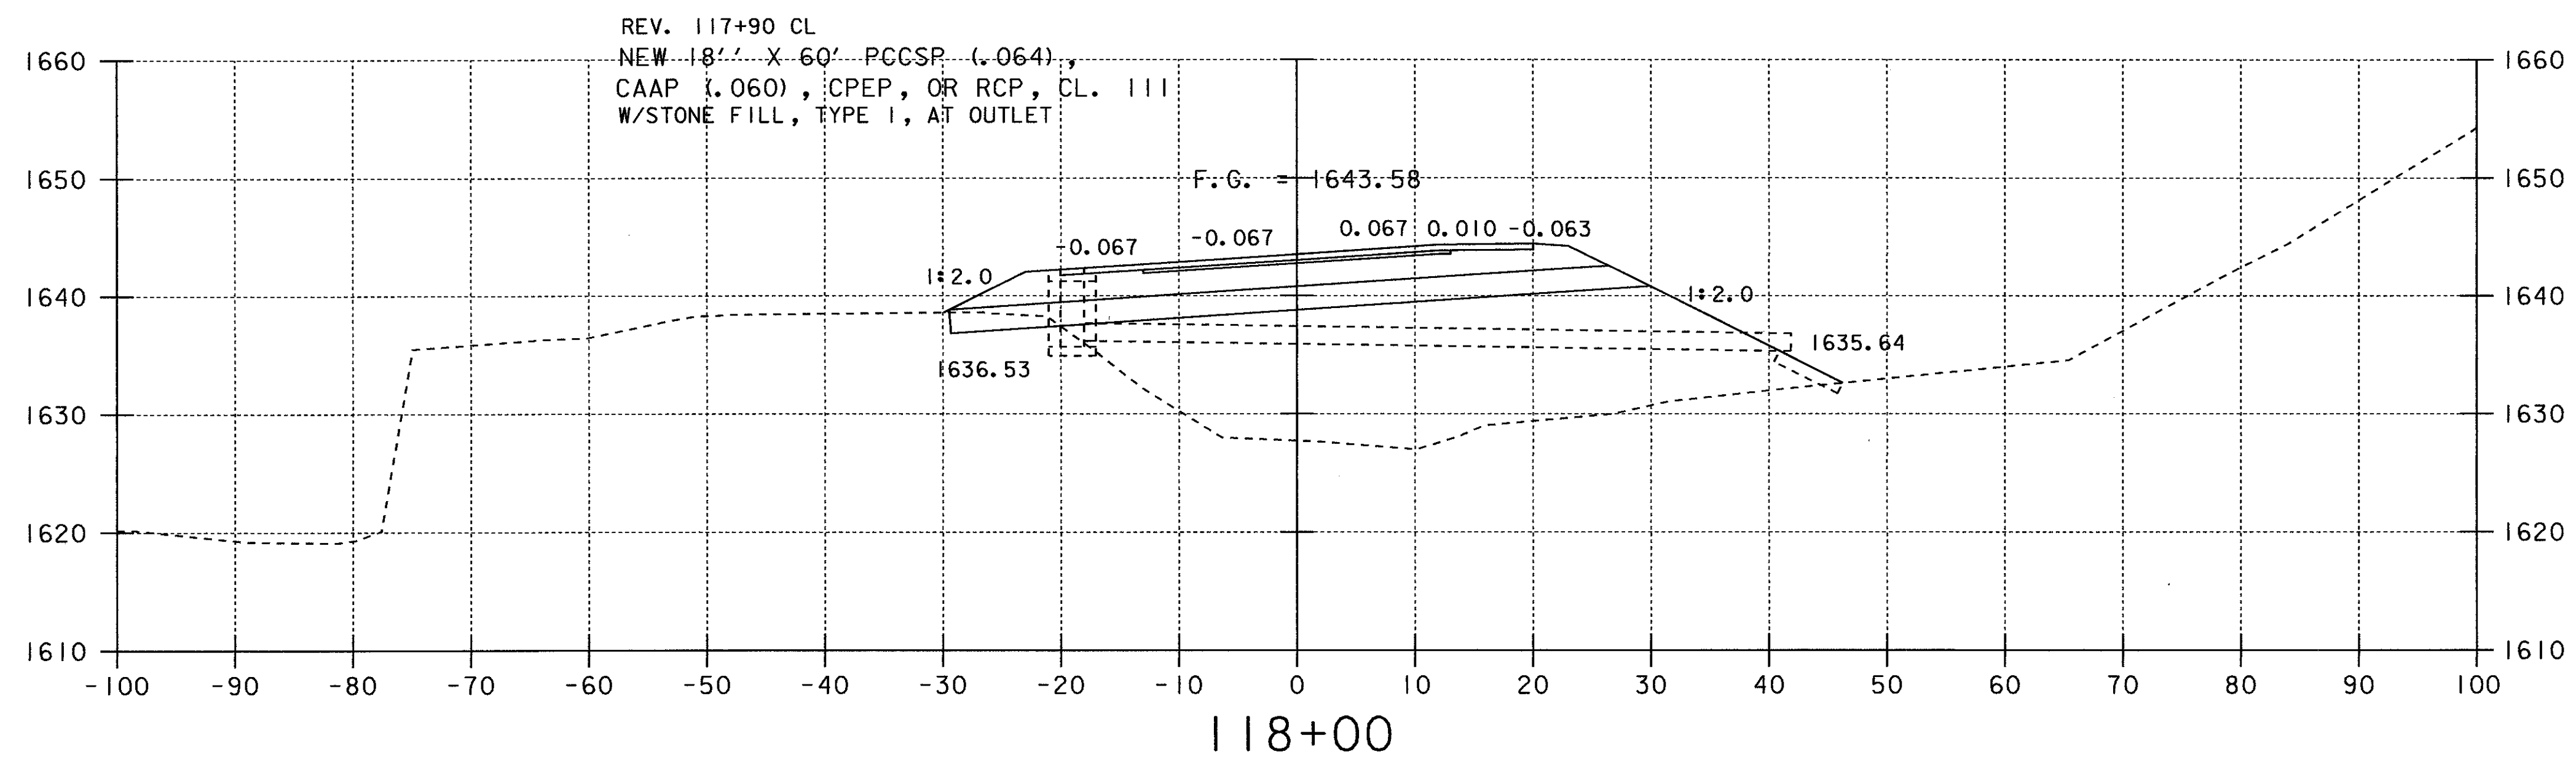

117+75 LT - 118+25 LT
GRUBBING MATERIAL

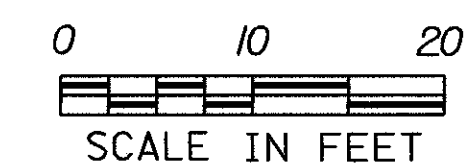

PROJECT NAME:	SEARSBURG - WILMINGTON
PROJECT NUMBER:	NHF 010-1(18)
PLOT FILE NAME:	DD096X05
PROJECT LEADER:	DELLA SANTA
DESIGN FILE NAME:	78D096/DESIGN/DD096CWRK.DGN
PLOT DATE:	28-FEB-2002
DRAWN BY:	SQUAD B
SHEET 343 OF 435	