


NOTE:
 DASHED LINE INDICATES SUBSTRUCTURE
 UPSTATION AND/OR DOWNSTATION OF
 SECTION CUT LINE.

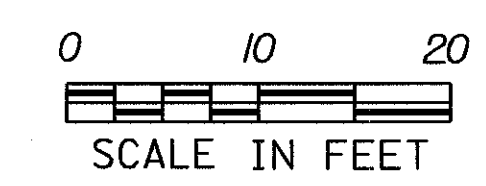

PROJECT NAME:	SEARSBURG - WILMINGTON	
PROJECT NUMBER:	NHF 010-(18)	
PROJECT FILE NAME:	DD096X06	PLOT DATE: 28-FEB-2002
PROJECT LEADER:	DELLA SANTA	DRAWN BY: SQUAD B
DESIGN FILE NAME:	78D096/DESIGN/DD096CWRK.DGN	SHEET 344 OF 435