


NOTE:
 DASHED LINE INDICATES SUBSTRUCTURE
 UPSTATION AND/OR DOWNSTATION OF
 SECTION CUT LINE.

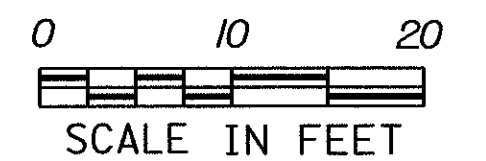

PROJECT NAME:	SEARSBURG - WILMINGTON
PROJECT NUMBER:	NHF 010-1(18)
PLOT FILE NAME:	DD096X07
PROJECT LEADER:	DELLA SANTA
DESIGN FILE NAME:	78D096/DESIGN/DD096CWRK.DGN
PLOT DATE:	28-FEB-2002
DRAWN BY:	SQUAD B
SHEET 345 OF 435	