
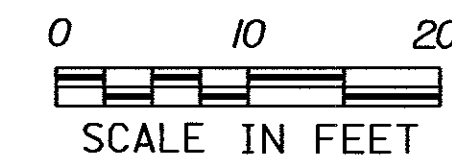
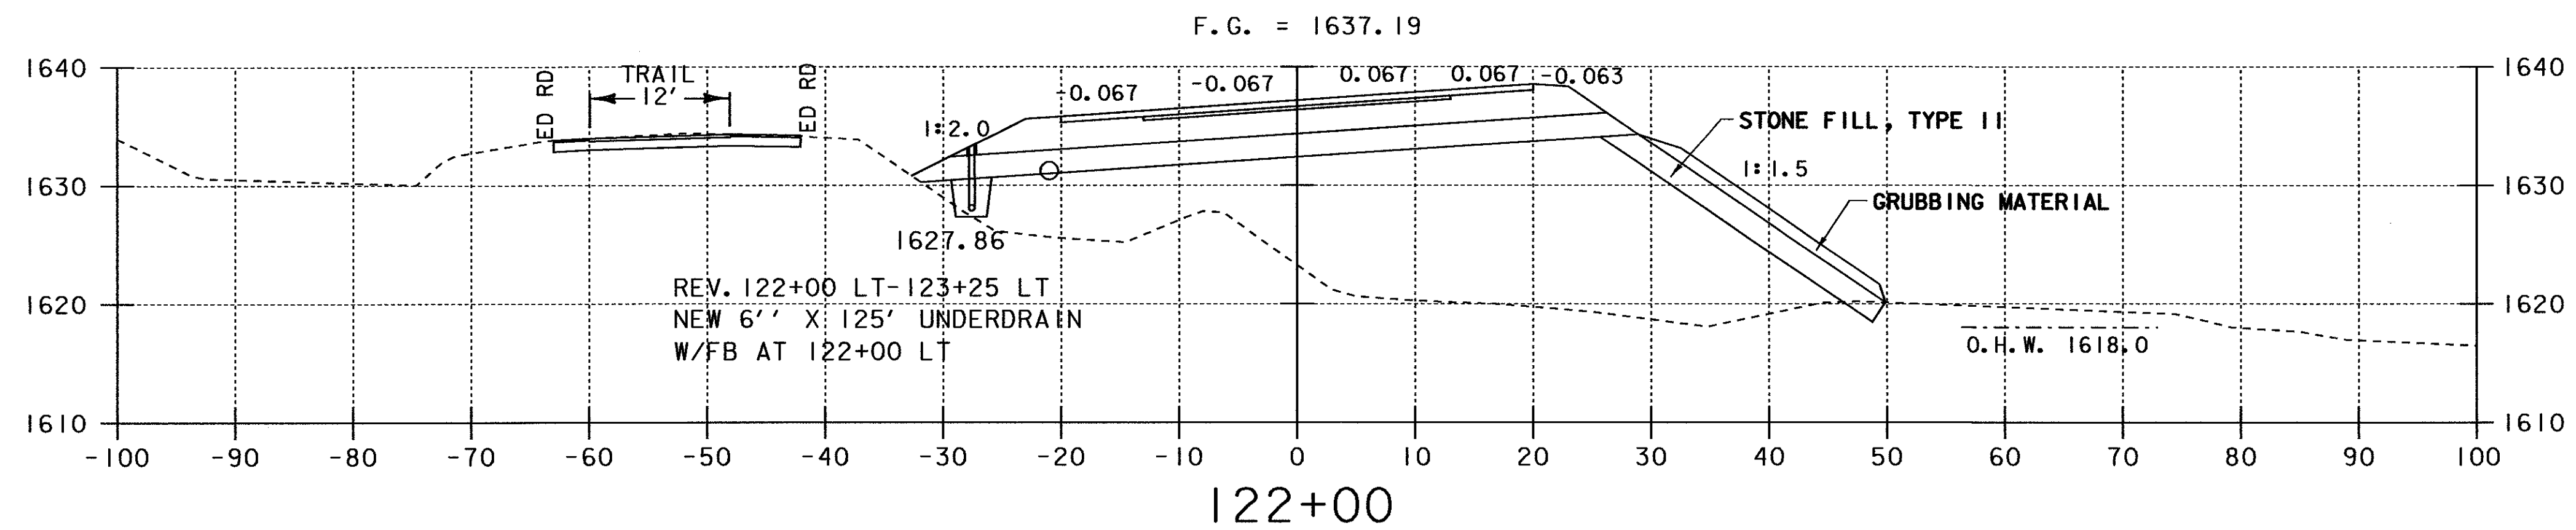
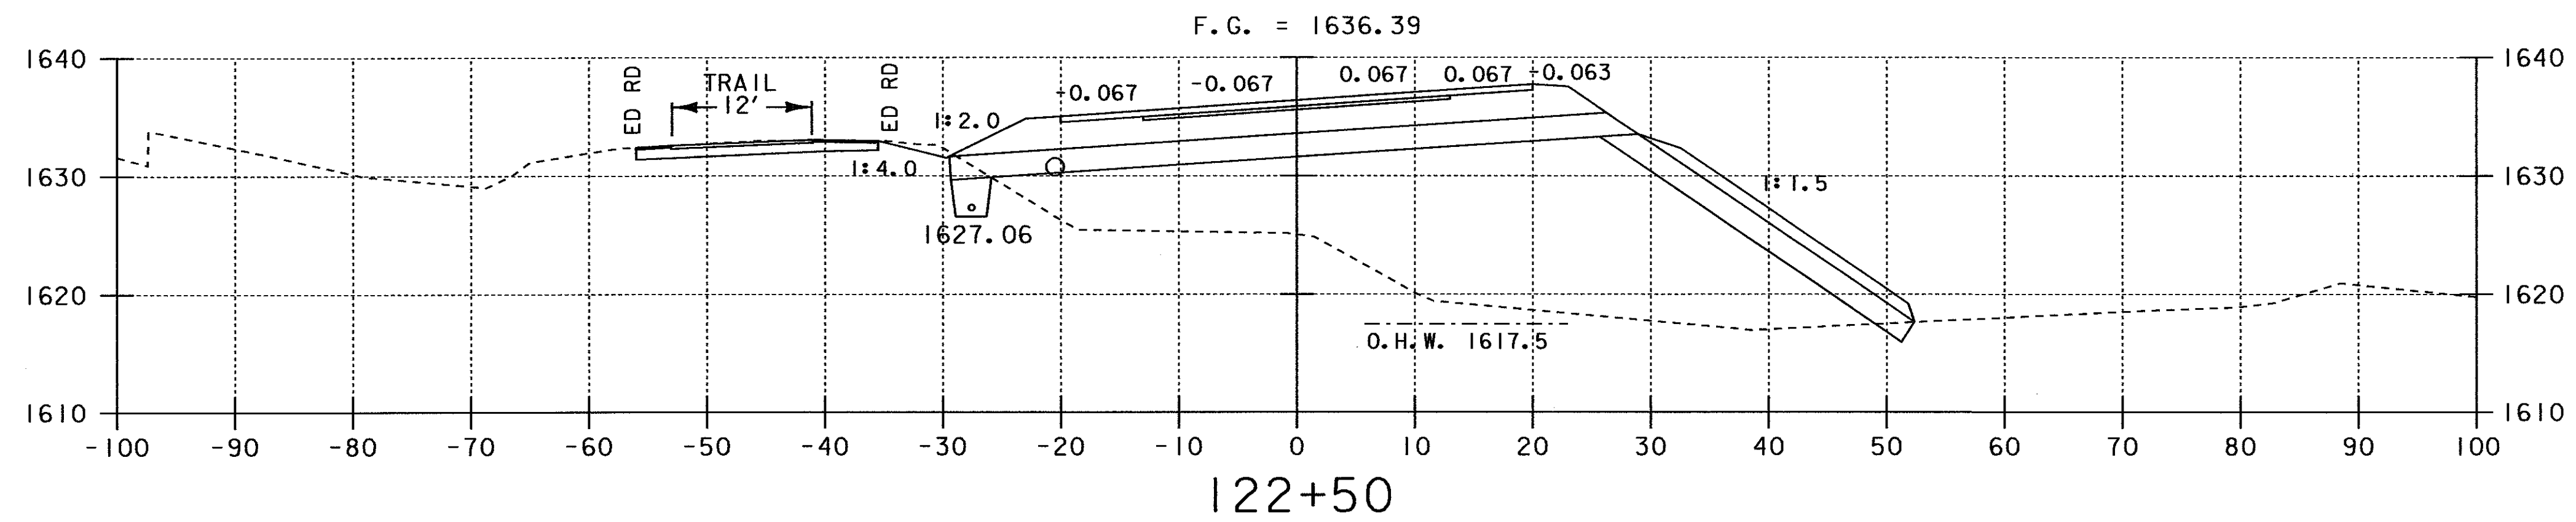


REV. 123+00 CL
 NEW 18' X 56' PCCSP (.064),
 CAAP (.060), CPEP, OR RCP,
 CL. III, WITH STONE FILL,
 TYPE I, @ OUTLET

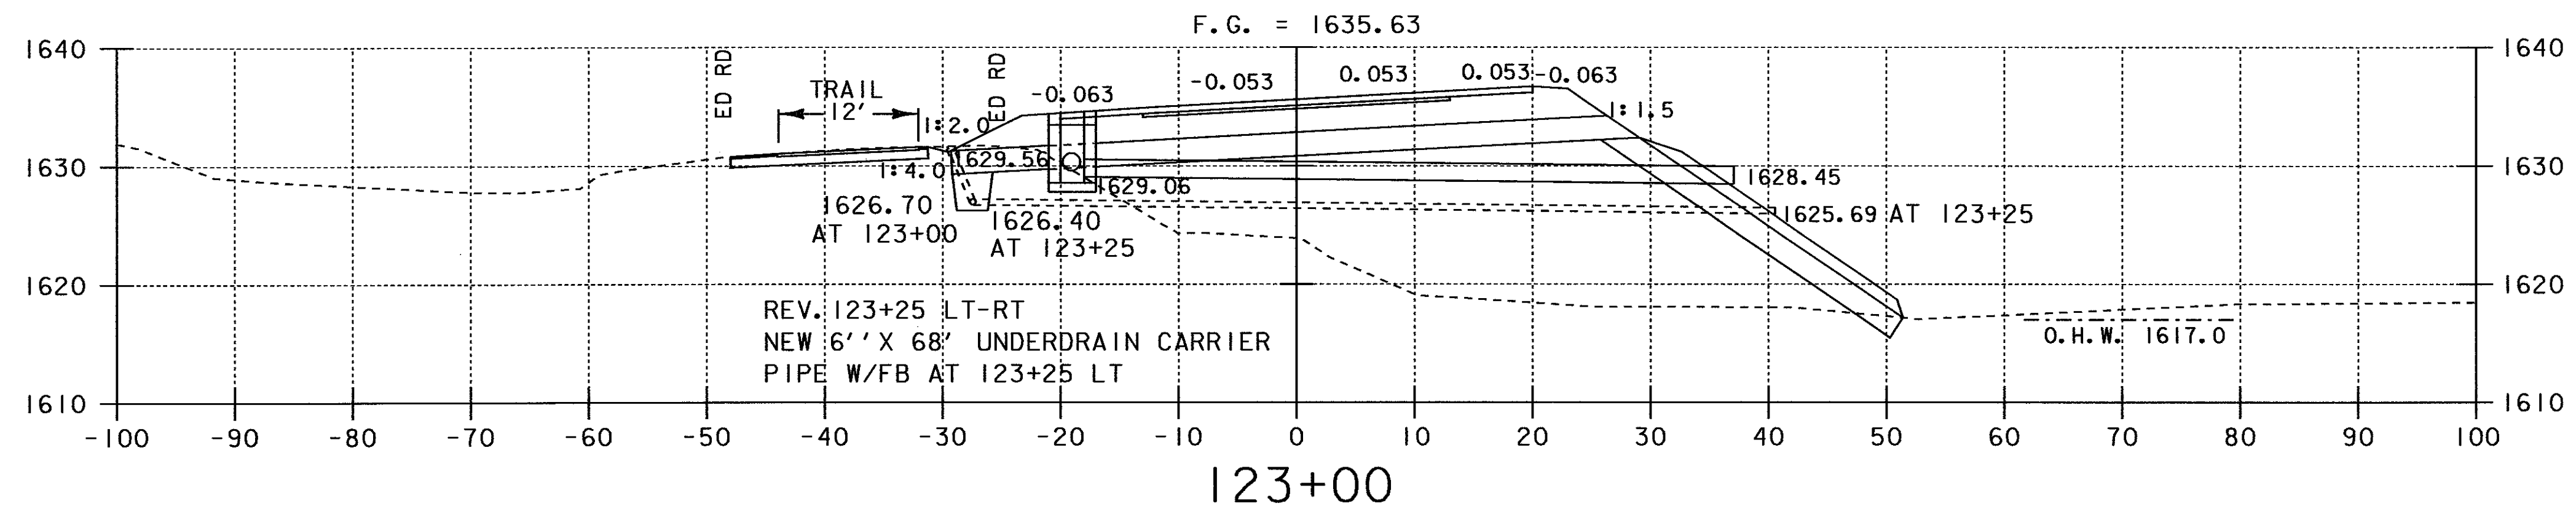

PROJECT NAME:	SEARSBURG - WILMINGTON	
PROJECT NUMBER:	NH 010-1(18)	
PLOT FILE NAME:	DD096X08	PLOT DATE: 01-FEB-2002
PROJECT LEADER:	DELLA SANTA	DRAWN BY: SQUAD B
DESIGN FILE NAME:	78D096/DESIGN/DD096CWRK.DGN	SHEET 346 OF 435