



130+50  
REV. 130+17.40  
STOP ROADWAY BEGIN BRIDGE 25A

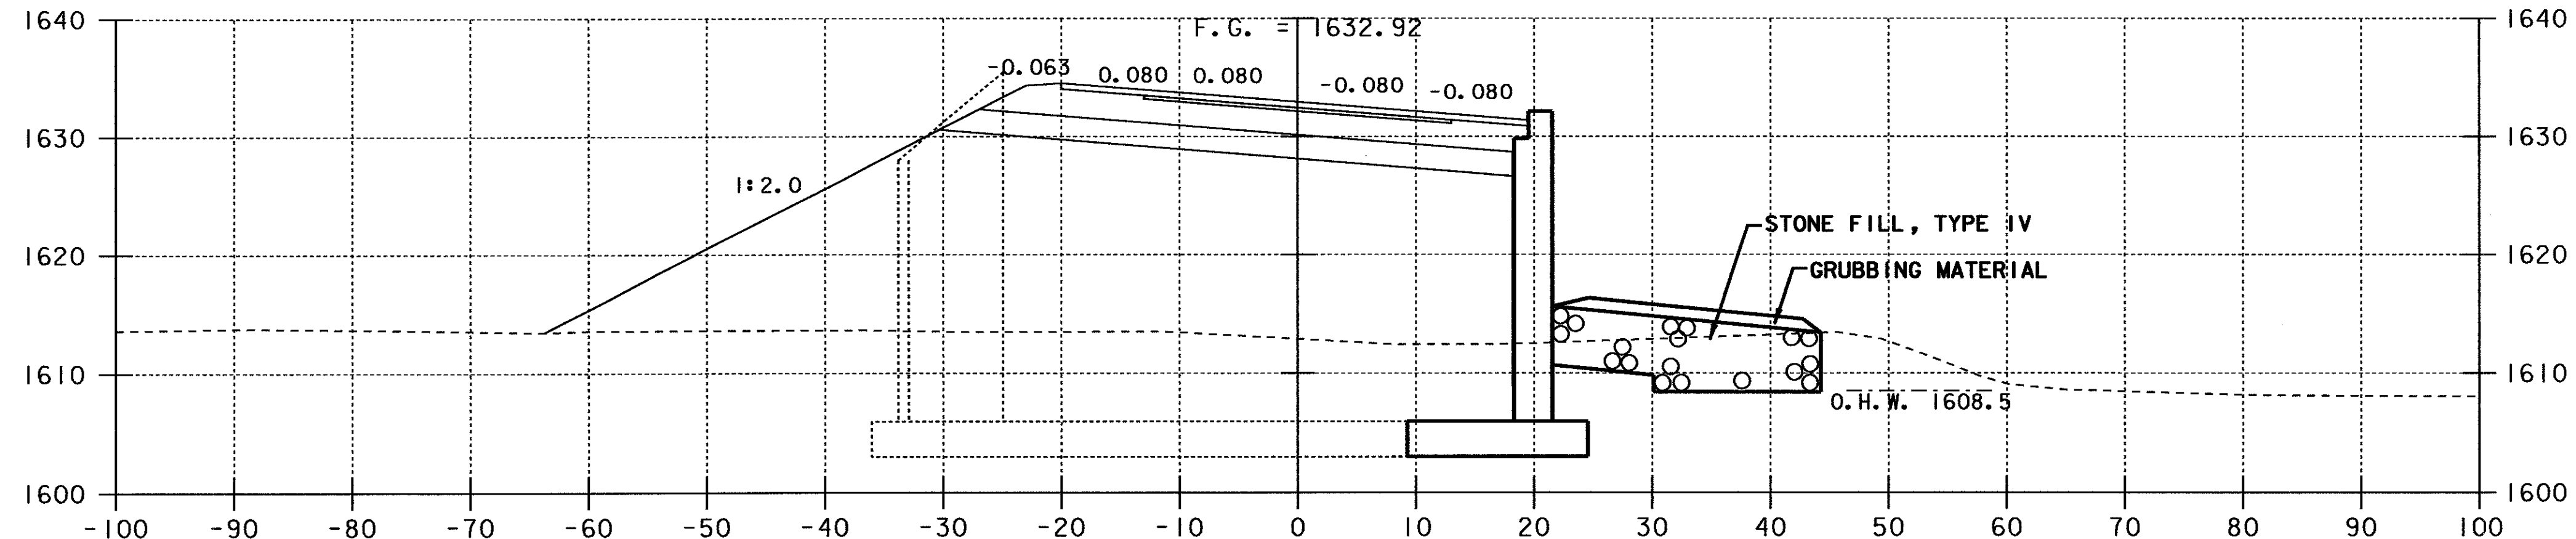


130+00

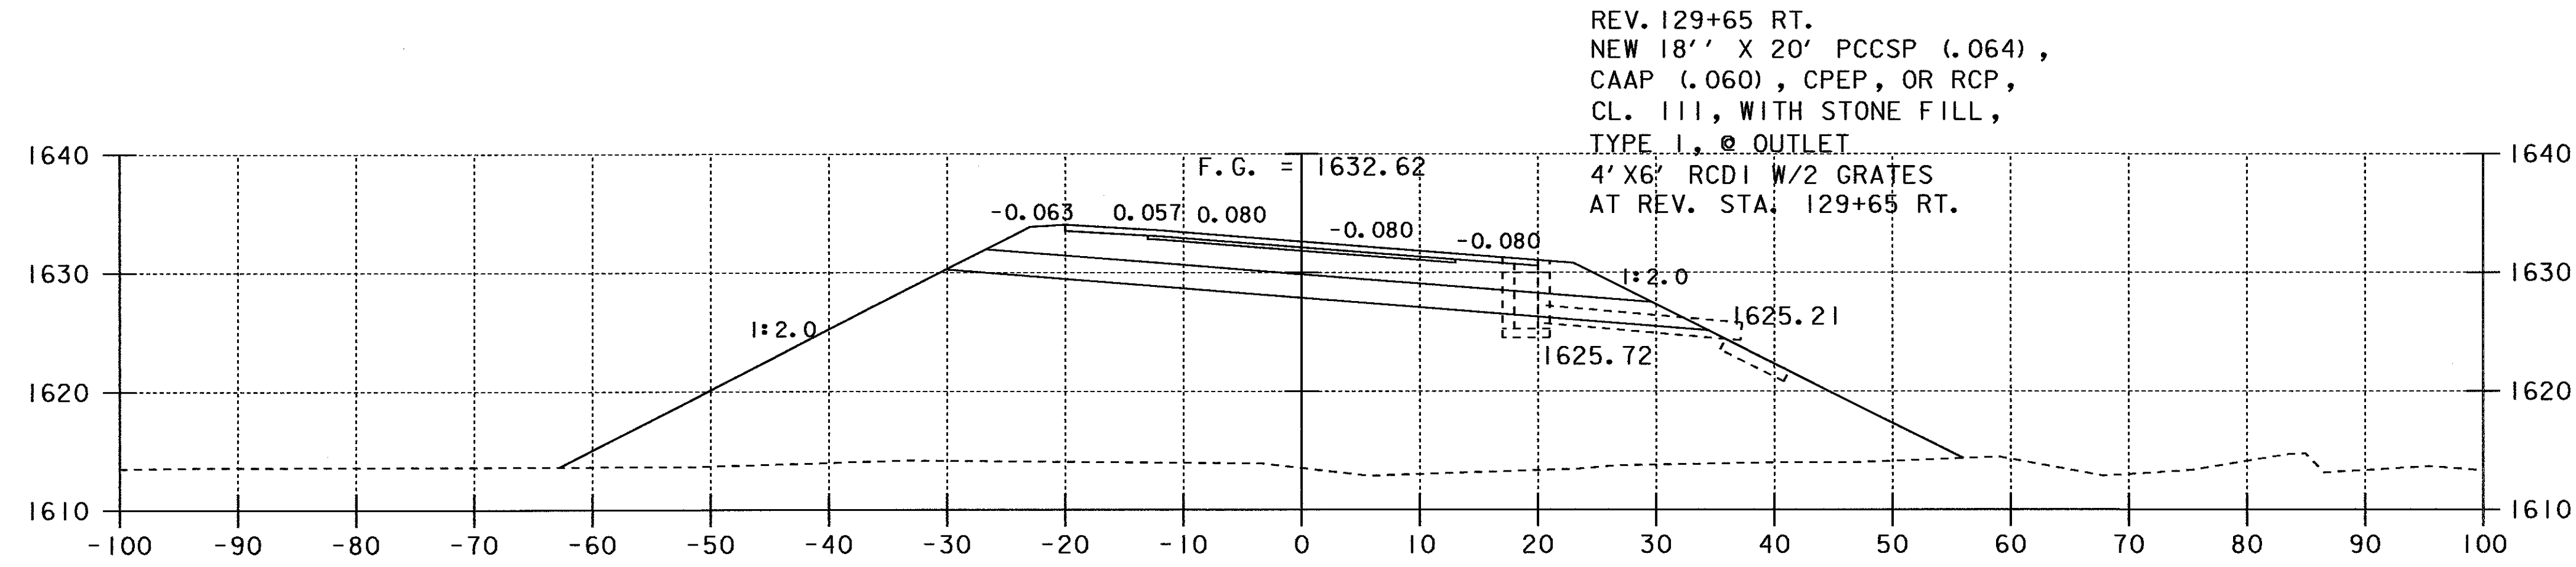

129+50

REV. 129+65 RT.  
NEW 18' X 20' PCCSP (.064),  
CAAP (.060), CPEP, OR RCP,  
CL. III, WITH STONE FILL,  
TYPE I, @ OUTLET  
4' X 6' RCD1 W/2 GRATES  
AT REV. STA. 129+65 RT.

NOTE:  
DASHED LINE INDICATES SUBSTRUCTURE  
UPSTATION AND/OR DOWNSTATION OF  
SECTION CUT LINE.

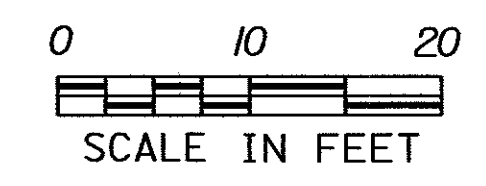

PROJECT NAME:	SEARSBURG - WILMINGTON
PROJECT NUMBER:	NHF 010-(18)
PLOT FILE NAME:	DD096X13
PROJECT LEADER:	DELLA SANTA
DESIGN FILE NAME:	78D096/DESIGN/DD096CWRK.DGN
PLOT DATE:	18-JAN-2002
DRAWN BY:	SQUAD B
SHEET 35/ OF 435	