

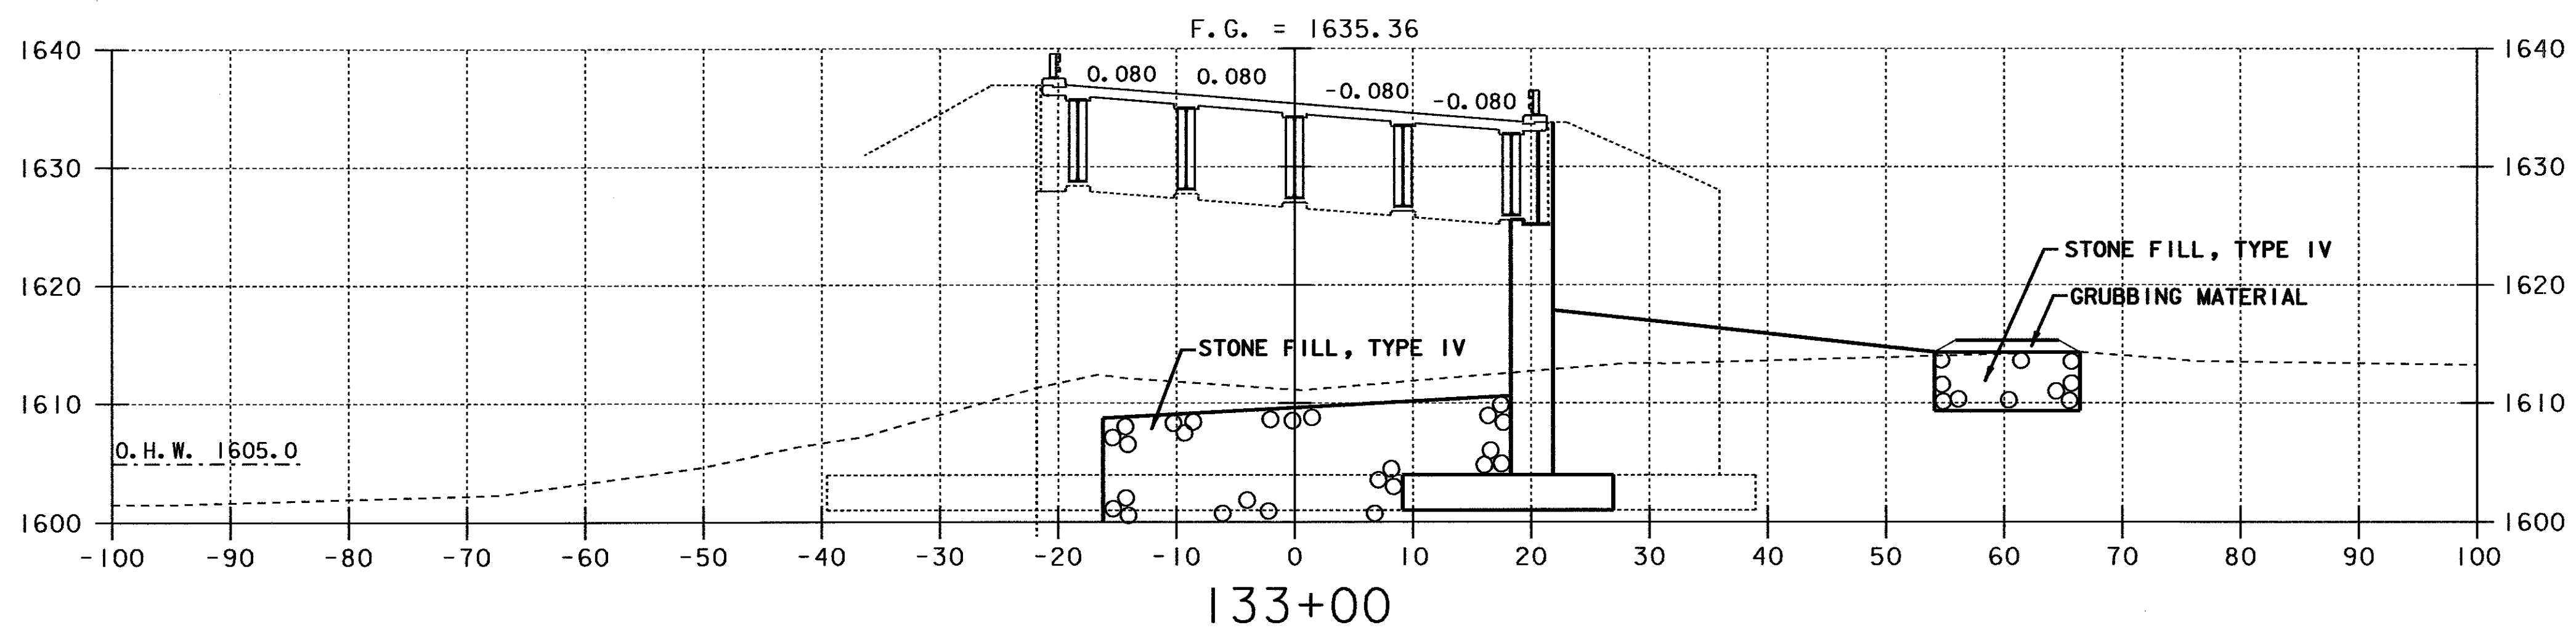


REV. 133+10.89  
END BRIDGE 25A RESUME ROADWAY

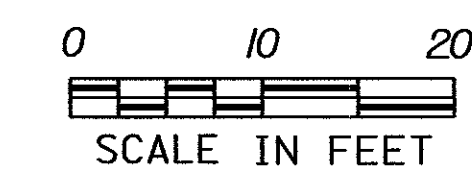

**NOTE:**  
DASHED LINE INDICATES SUBSTRUCTURE  
UPSTATION AND/OR DOWNSTATION OF  
SECTION CUT LINE.

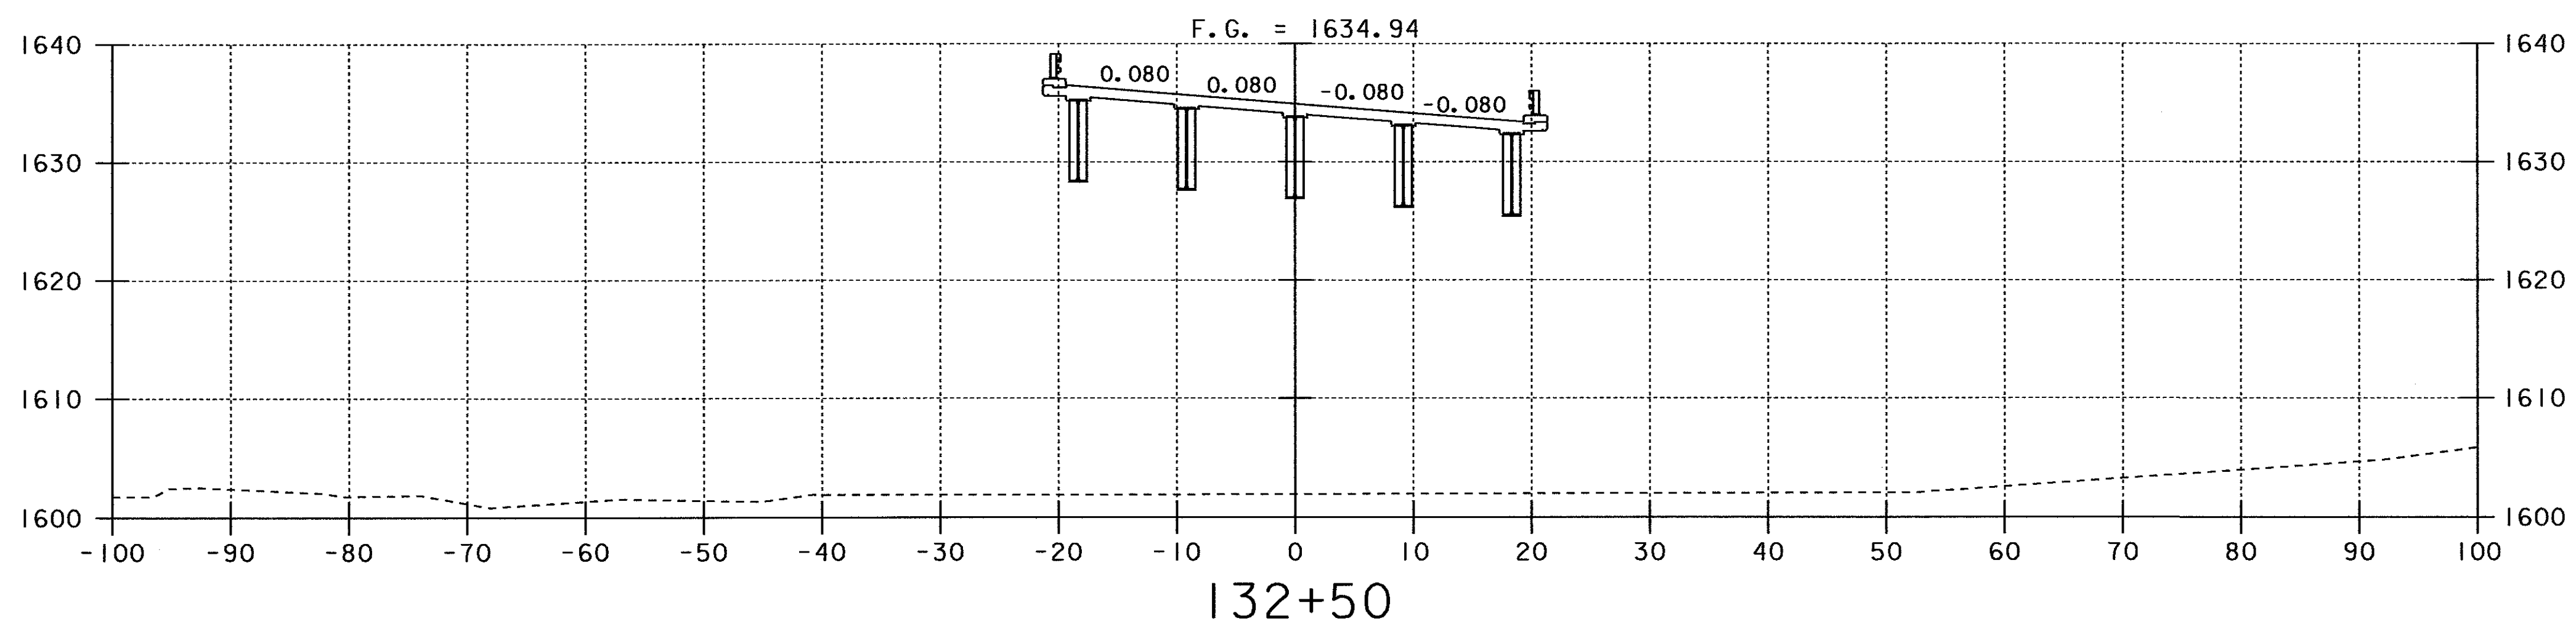

PROJECT NAME:	SEARSBURG - WILMINGTON	
PROJECT NUMBER:	NH 010-1(18)	
PLOT FILE NAME:	DD096X15	PLOT DATE: 18-JAN-2002
PROJECT LEADER:	DELLA SANTA	DRAWN BY: SQUAD B
DESIGN FILE NAME:	78D096/DESIGN/DD096CWRK.DGN	SHEET 353 OF 435