


DC 2-24-05  
BB 1-24-05

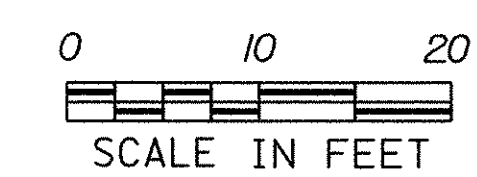

PROJECT NAME:	SEARSBURG - WILMINGTON	
PROJECT NUMBER:	NH 010-1(18)	
PLOT FILE NAME:	DD096X17	PLOT DATE: 29-NOV-2001
PROJECT LEADER:	DELLA SANTA	DRAWN BY: SQUAD B
DESIGN FILE NAME:	78D096/DESIGN/DD096CWRK.DGN	SHEET 355 OF 435