

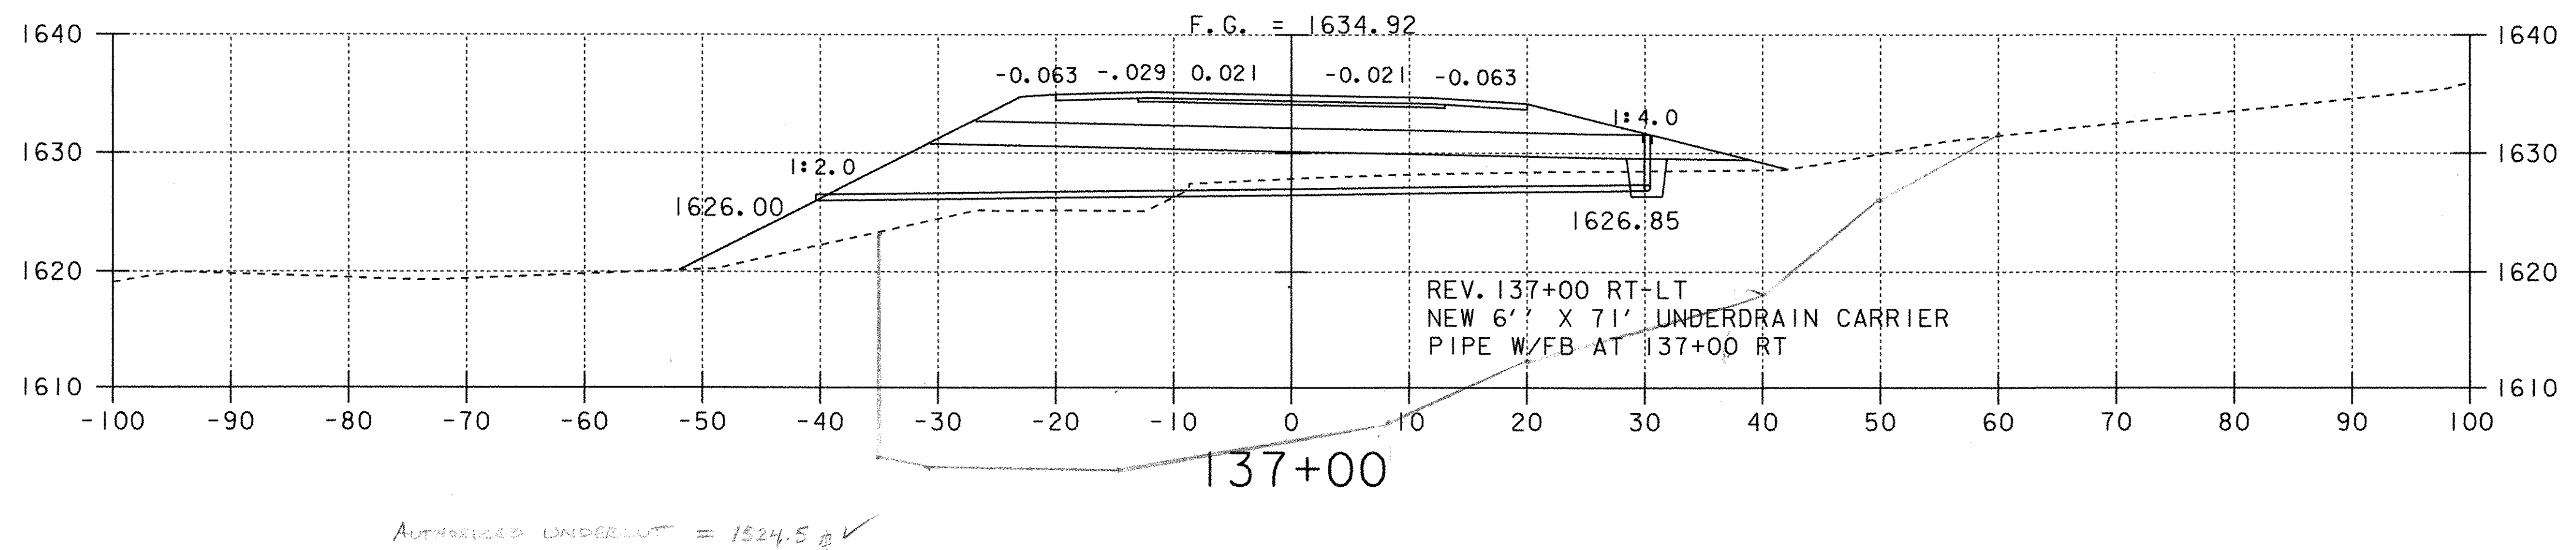
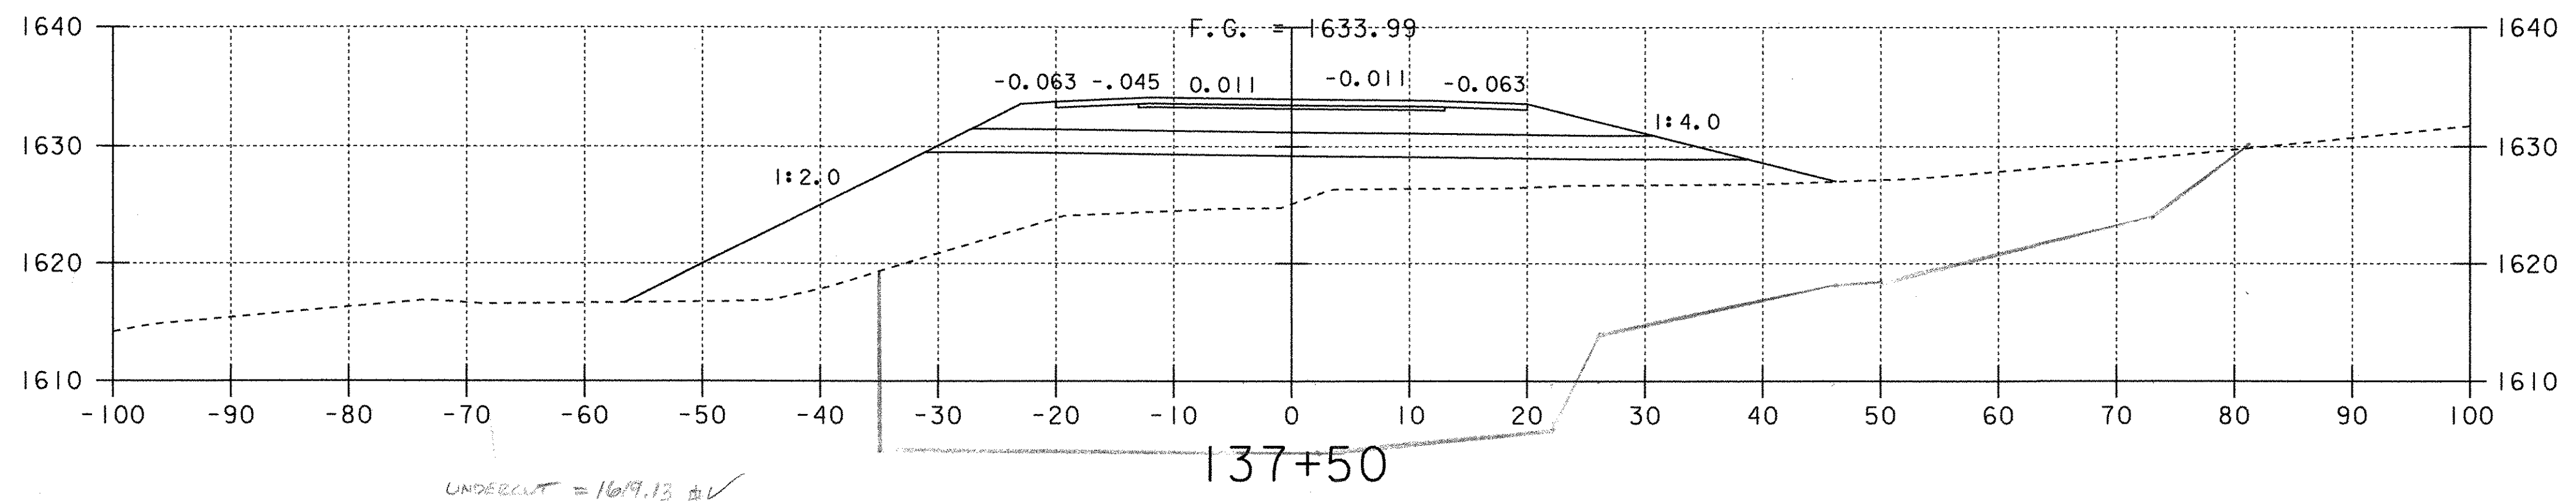


REV. POT 138+46.29 =
 SURV. PT 137+61.97
 EQ. = +84.32'

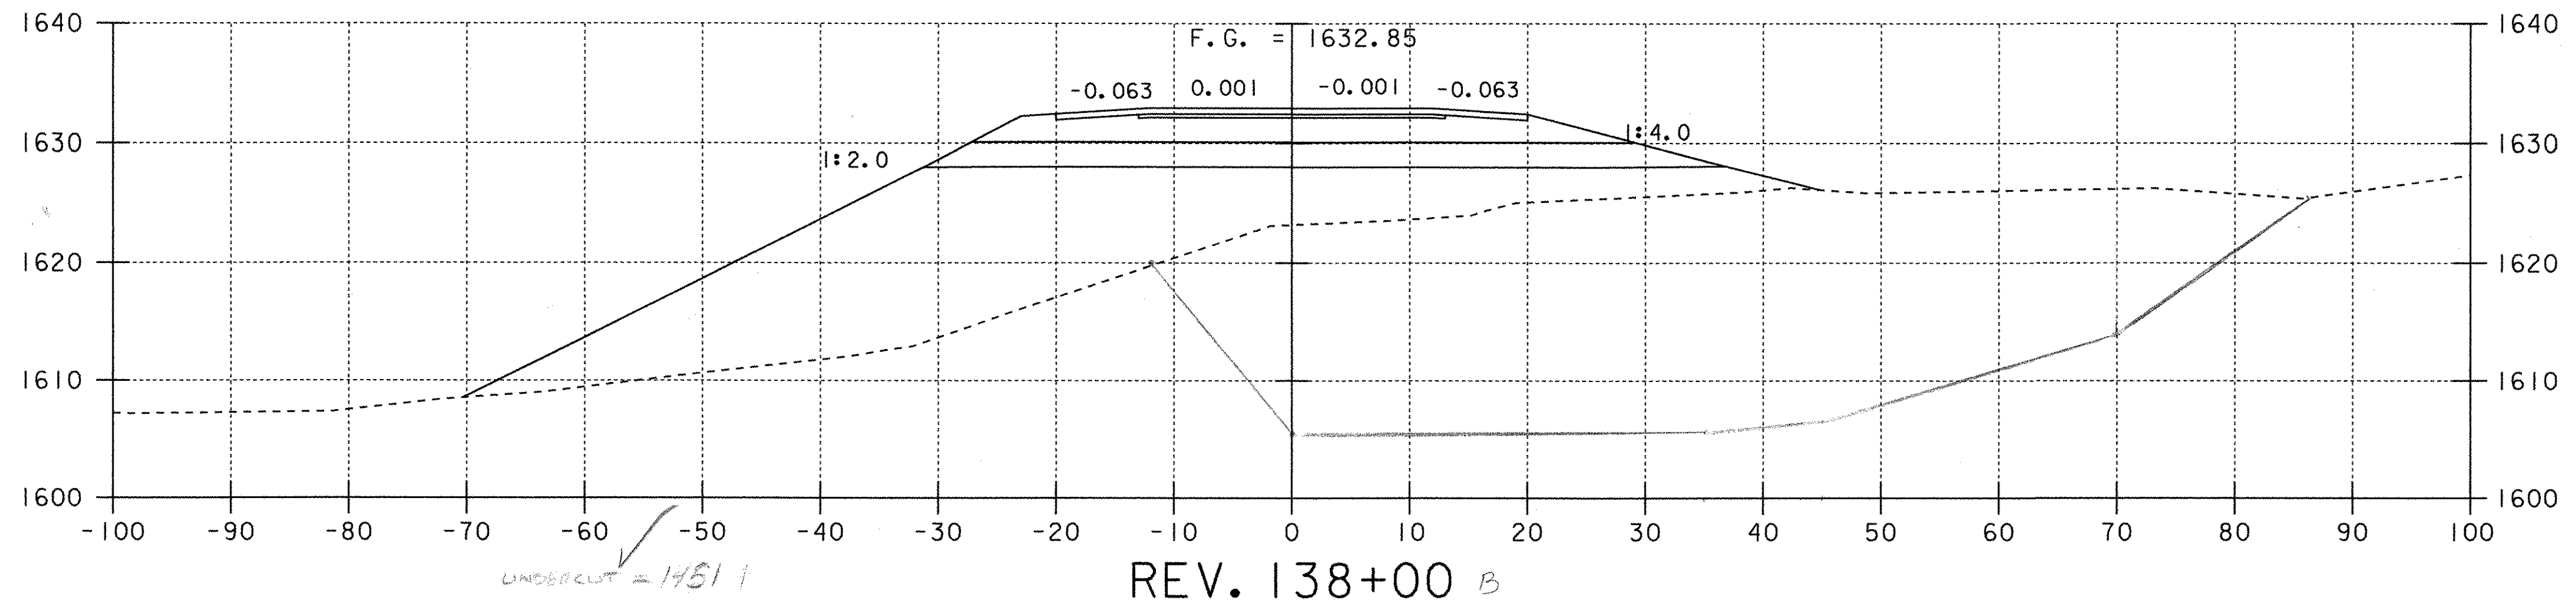

DC 2-24-05
 BB 2-24-05

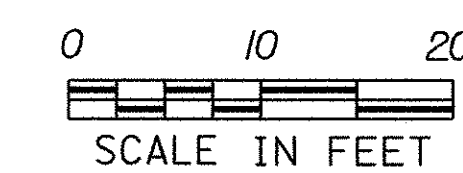

PROJECT NAME:	SEARSBURG - WILMINGTON	
PROJECT NUMBER:	NH 010-1(18)	
PLOT FILE NAME:	DD096X18	PLOT DATE: 28-NOV-2001
PROJECT LEADER:	DELLA SANTA	DRAWN BY: SQUAD B
DESIGN FILE NAME:	78D096/DESIGN/DD096CWRK.DGN	SHEET 356 OF 435