

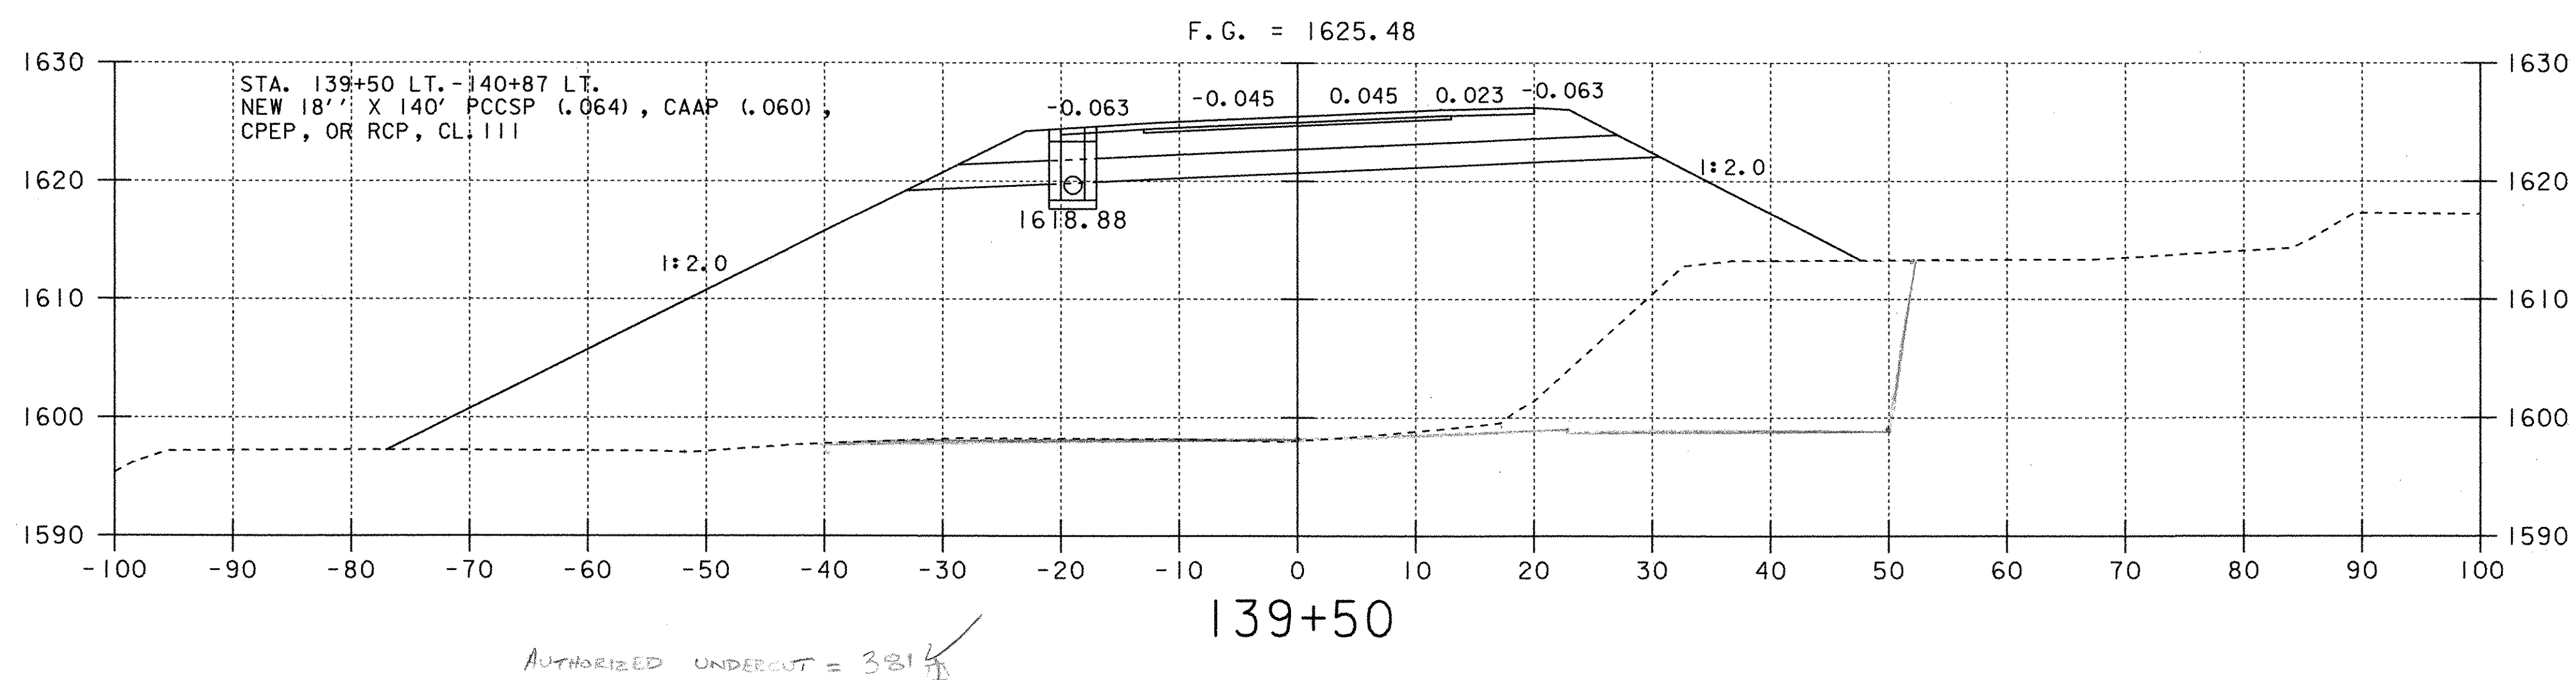


RIGHT SHOULDER BANKING TRANSITION FROM BRIDGE

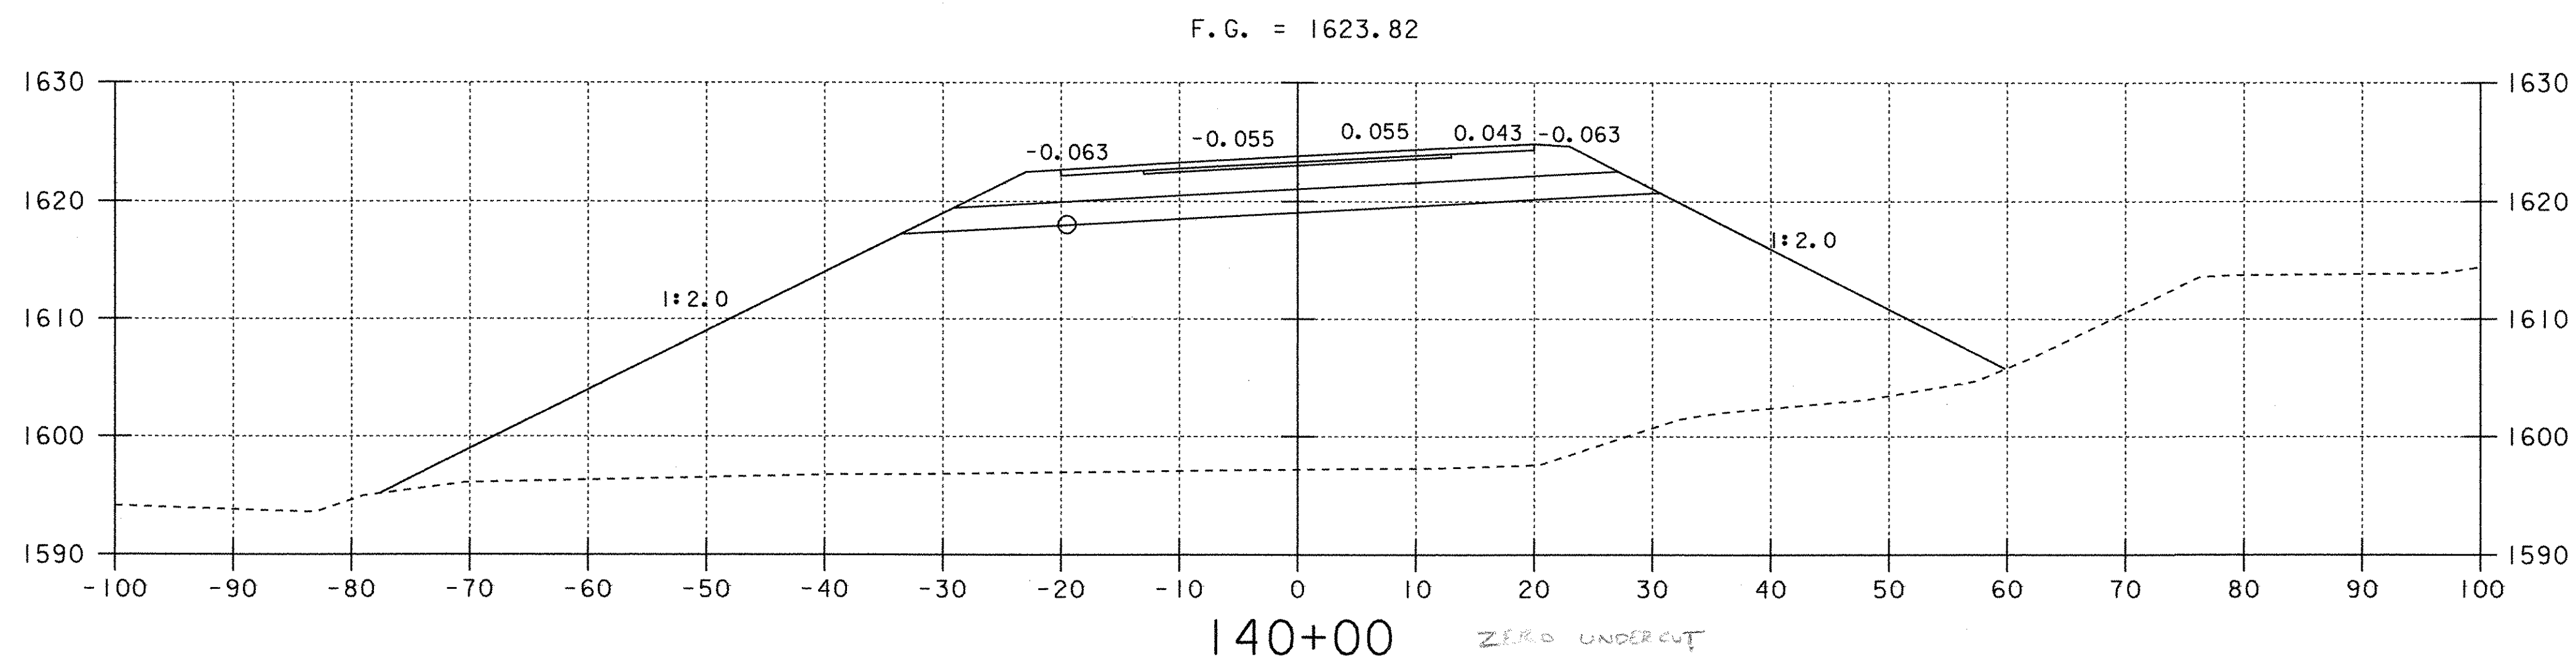

DC 2-24-05

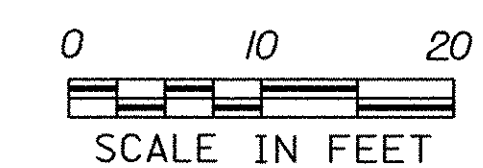

PROJECT NAME:	SEARSBURG - WILMINGTON		
PROJECT NUMBER:	NH 010-1(18)		
PLOT FILE NAME:	DD096X20	PLOT DATE:	18-JAN-2002
PROJECT LEADER:	DELLA SANTA	DRAWN BY:	SQUAD B
DESIGN FILE NAME:	780096/DESIGN/DD096CWRK.DGN		
		SHEET	358 OF 435