
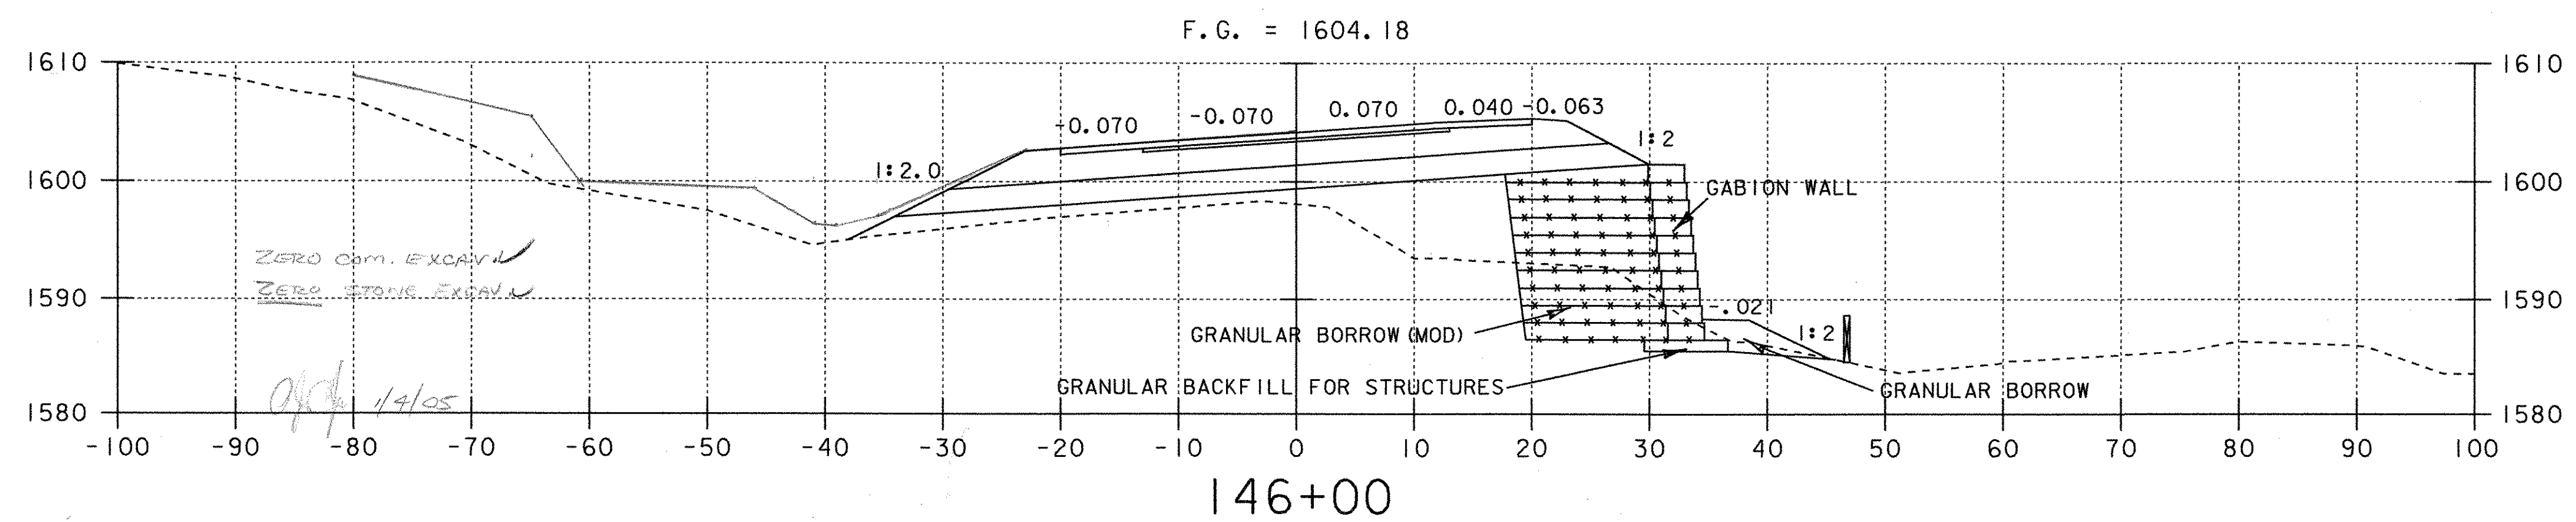



203.16
SOLID ROCK EXC 146+0 - 150+0 (LEFT)

STA	DIST	AREA	CY
146+0	50	0	29.1
146+50	50	26	173.1
147+0	50	161	408.3
147+50	50	280	641.7
148+0	50	413	597.2
148+50	50	232	324.1
149+0	50	118	128.7
149+50	50	21	19.4
150+0	50	0	

2316.6 ✓ ey DC
1-20-05
MHM
1-20-05
TO MISC. ITEM BINDER,
PAGE 203.16-1

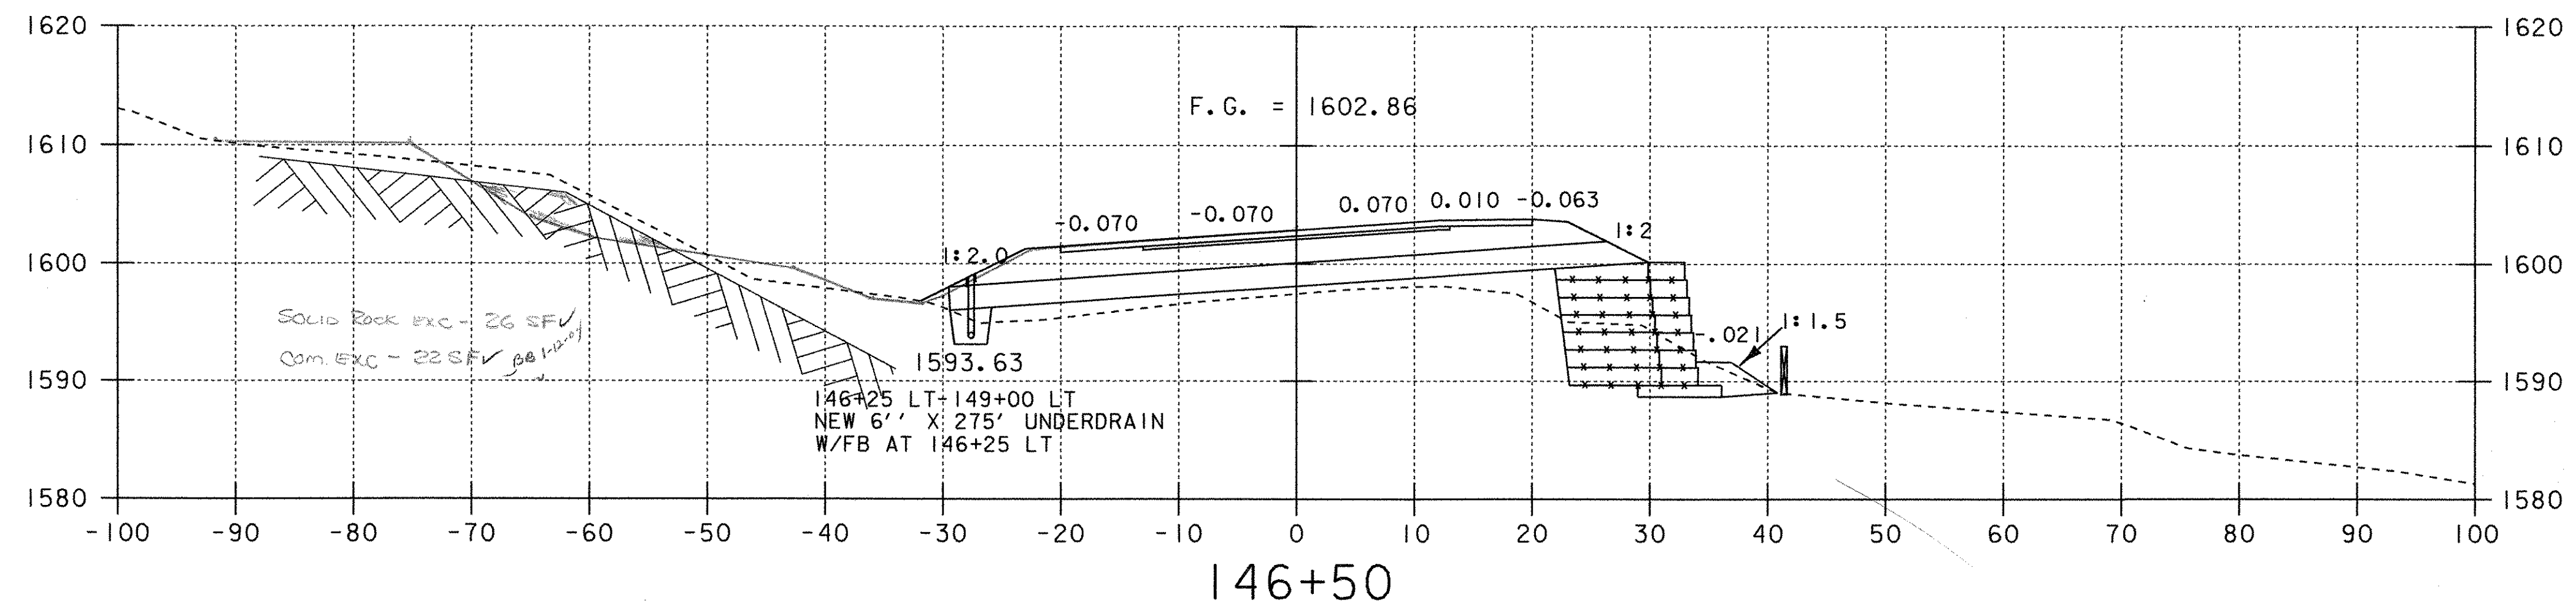

STA. 145+68 RT ~ 147+28 RT
CONSTRUCT GABION WALL

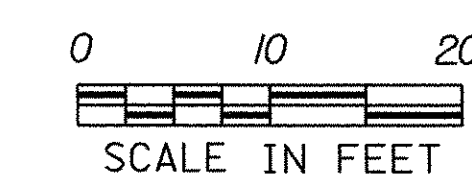

PROJECT NAME: SEARSBURG - WILMINGTON
PROJECT NUMBER: NHF 010-1(18)
PLOT FILE NAME: DD096X25 PLOT DATE: 29-NOV-2001
PROJECT LEADER: DELLA SANTA DRAWN BY: SQUAD B
DESIGN FILE NAME: 78D096/DESIGN/DD096CWRK.DGN
SHEET 363 OF 435