


SURVEY  
 PLAN  
 DATE: 10/10/16

SURVEY  
 PLAN  
 DATE: 10/10/16

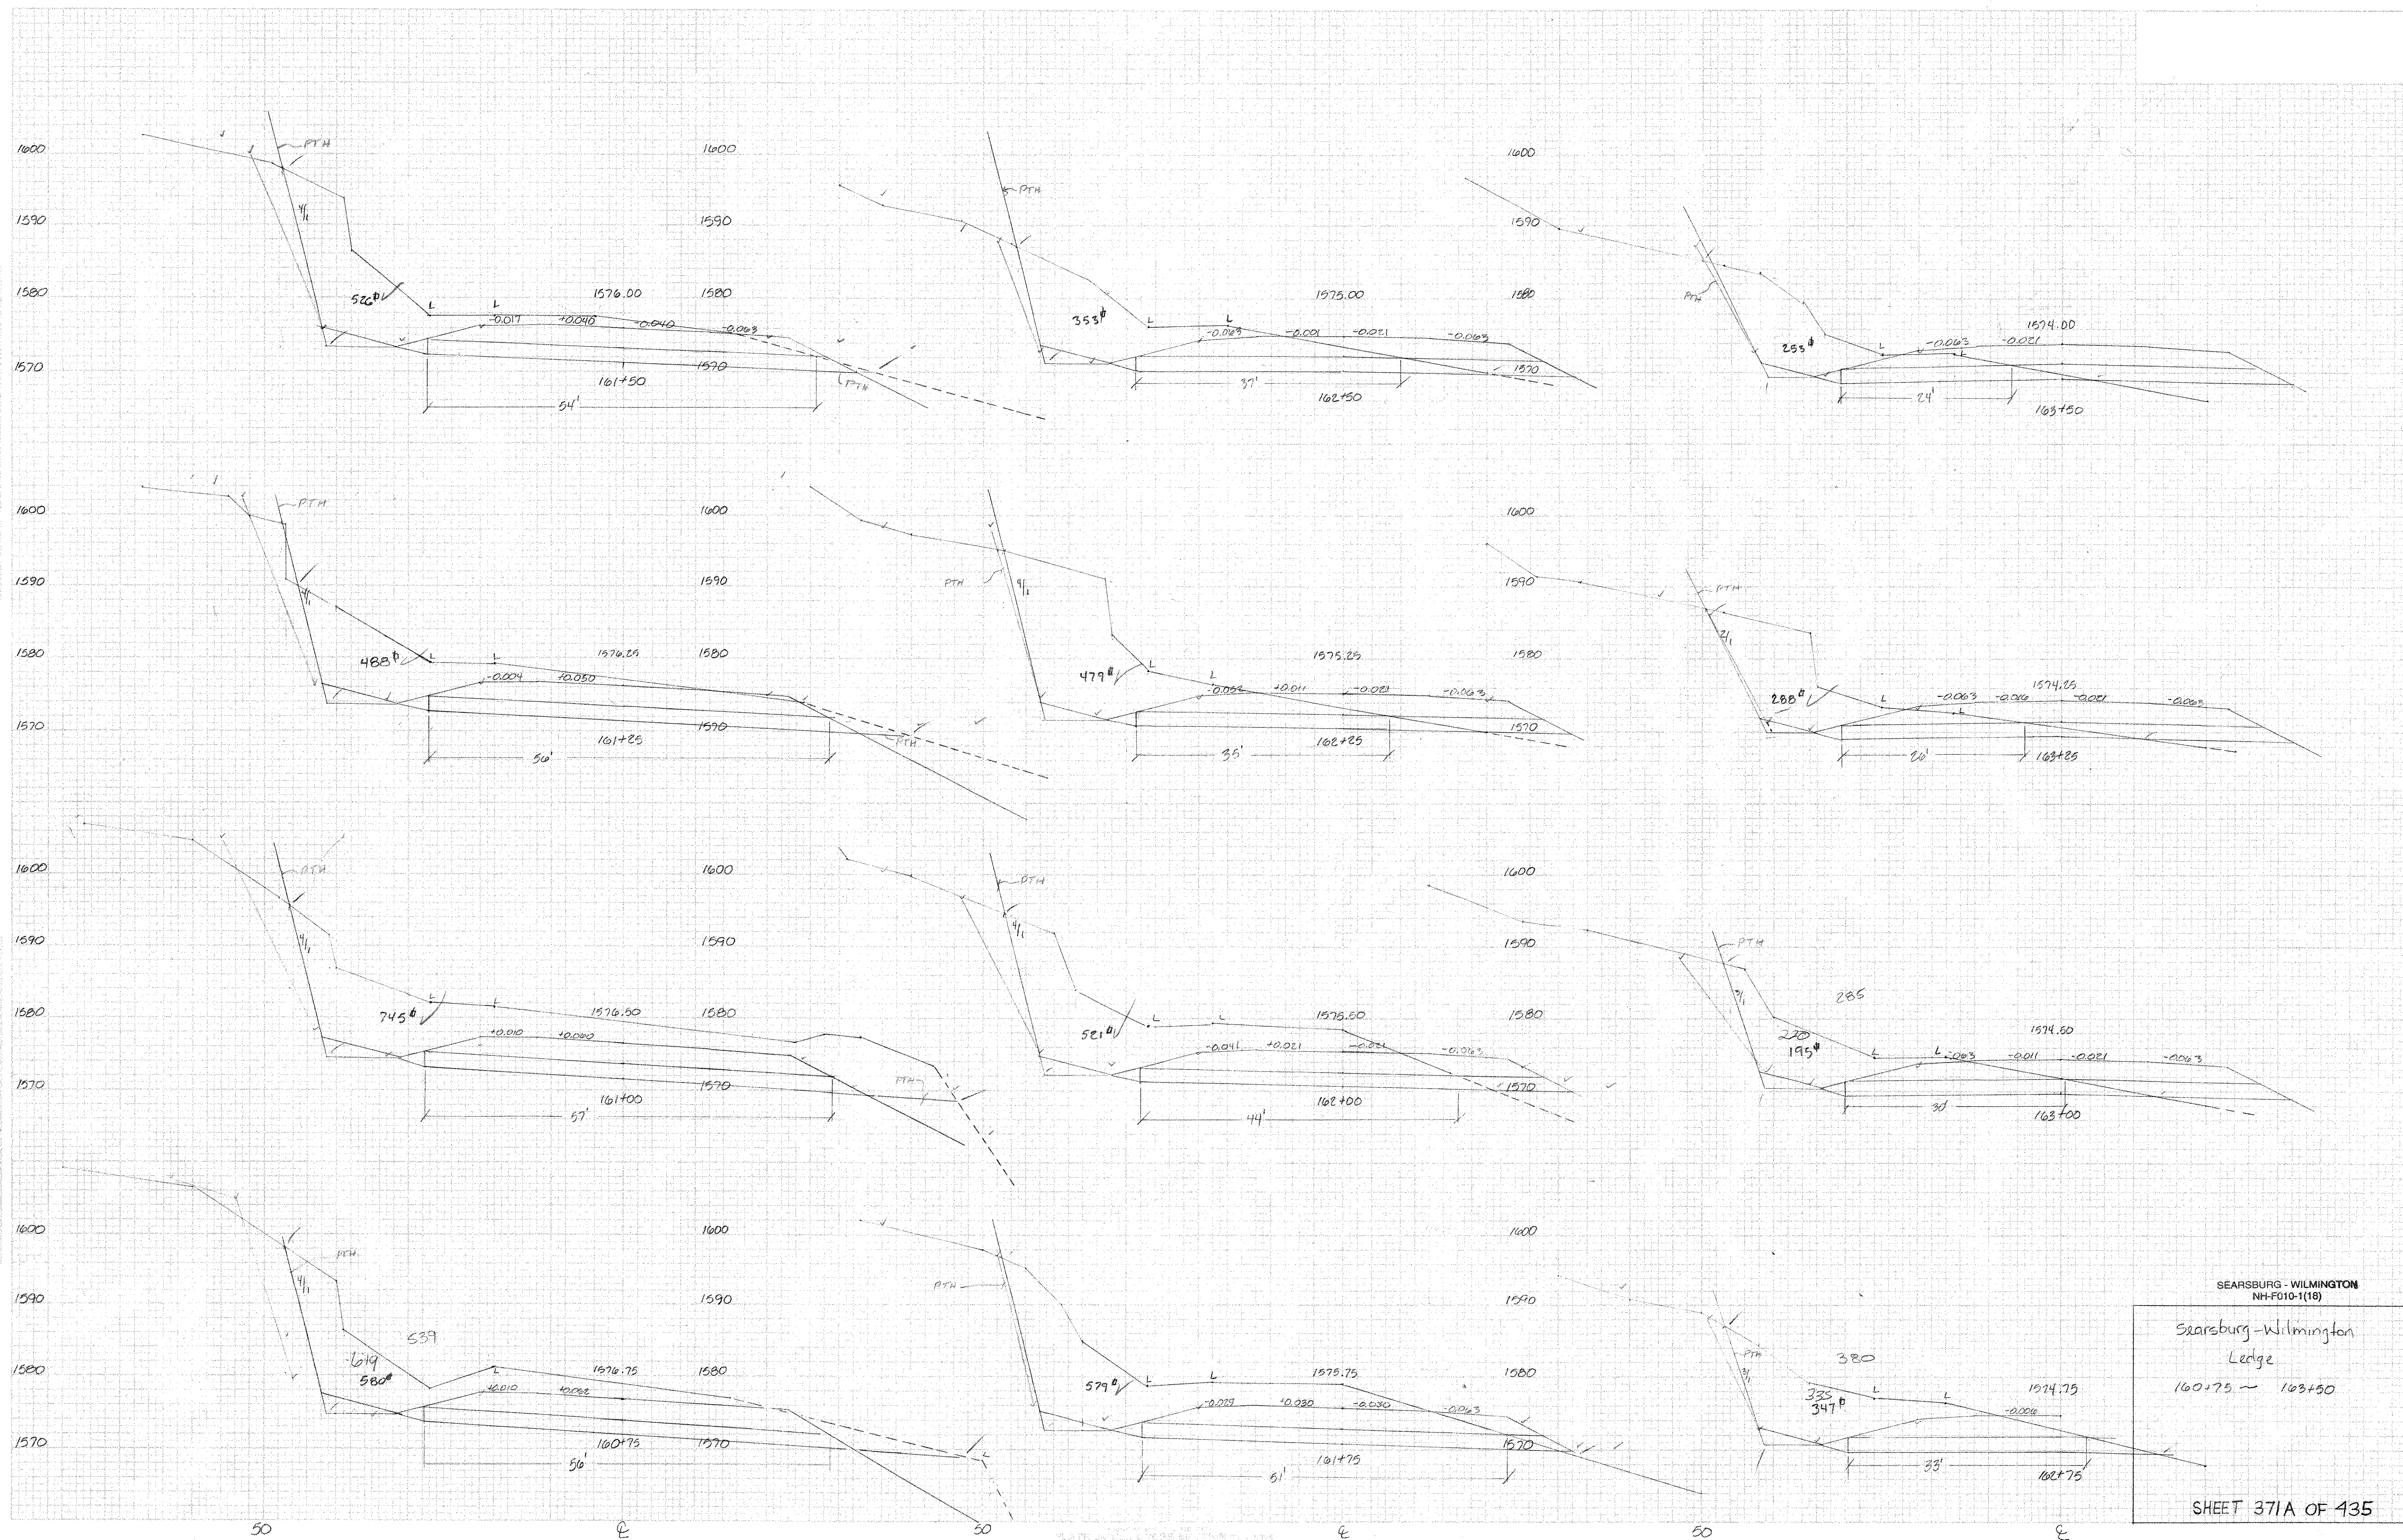

SEARSBURG - WILMINGTON  
 NH-F010-1(16)  
 Searsburg-Wilmington  
 Ledge  
 160+75 ~ 163+50  
 SHEET 371A OF 435