


MW 28 JUN 04

FINAL SURVEY	UNRECORDED
DATE	NO. OF SHEETS
BY	DATE
FOR	BY
APPROVED	DATE

ORIGINAL SURVEY	RECORDED
DATE	NO. OF SHEETS
BY	DATE
FOR	BY
APPROVED	DATE

Typical Rock Fill - Grubbing Waste Cover

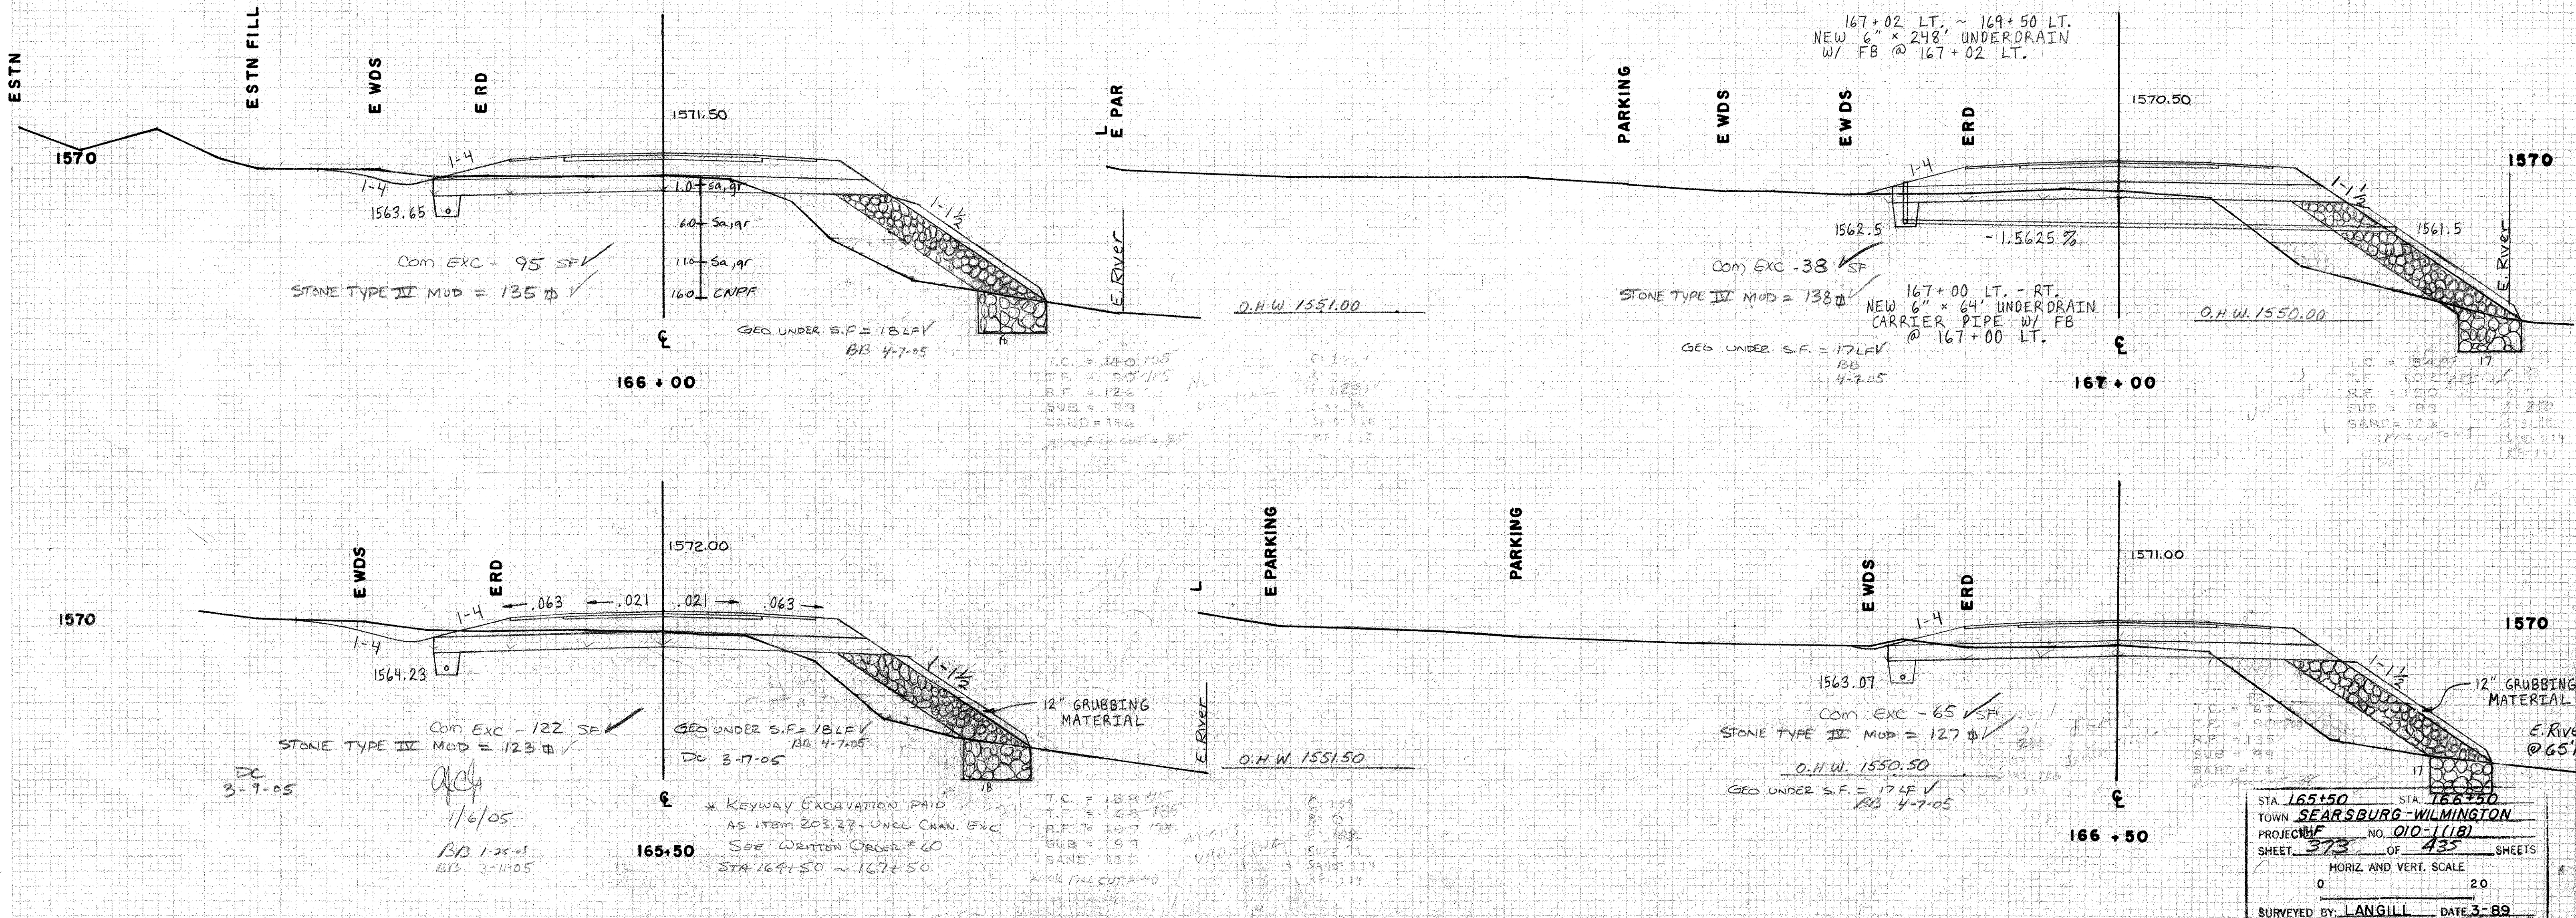

STA. 165+50	STA. 166+50
TOWN SEARSBURG - WILMINGTON	
PROJECT NO. 010-1(18)	
SHEET 373	OF 435 SHEETS
HORIZ. AND VERT. SCALE	
0	20
SURVEYED BY: LANGILL DATE: 3-89	