


DATE 1/11/05
BY RAL



DATE	
BY	
FINAL SURVEY	
NOTED	
TEMPLATE	
AREAS	
CHECKED	

DATE	1/11/05
BY	RAL
ORIGINAL SURVEY	
NOTED	
TEMPLATE	
AREAS	
CHECKED	

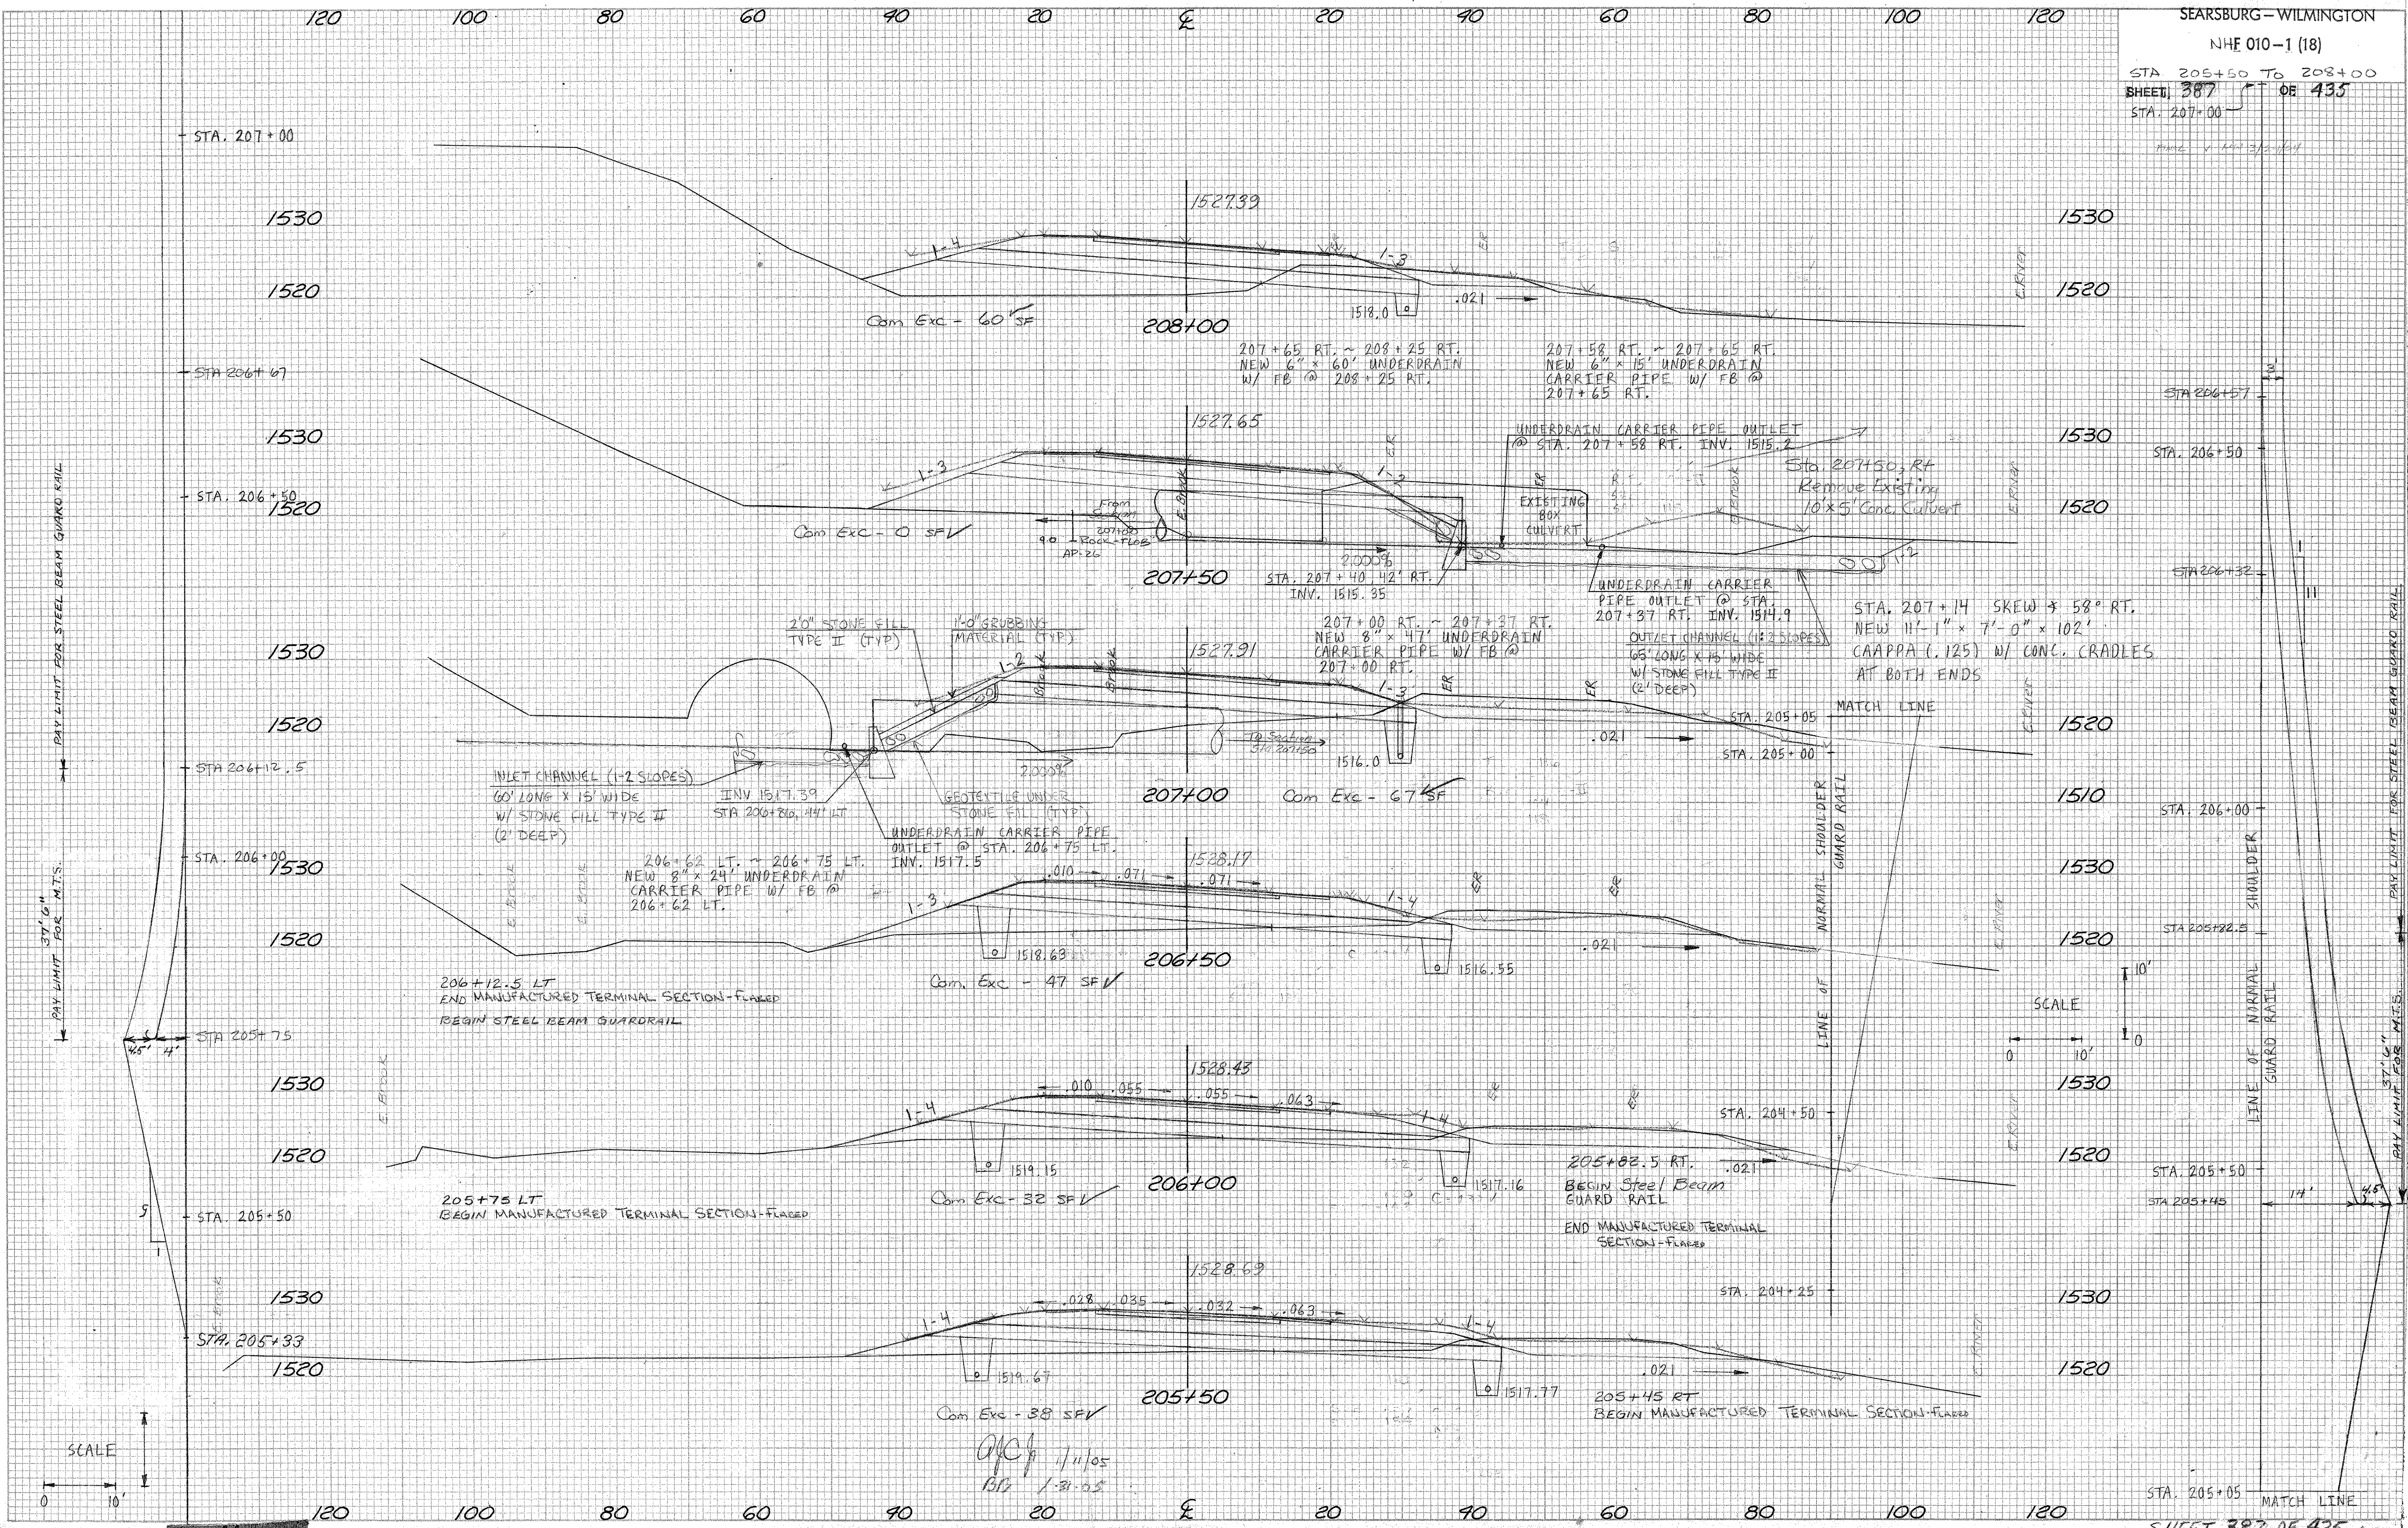

PAY LIMIT FOR STEEL BEAM GUARD RAIL

PAY LIMIT FOR STEEL BEAM GUARD RAIL

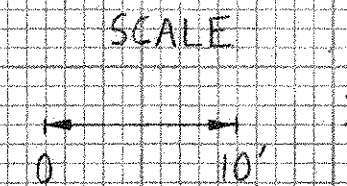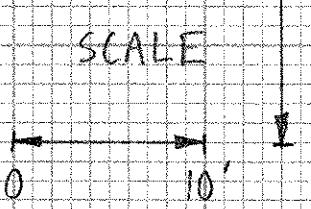

1/11/05
1/31/05