


DESIGNED BY: J. J. JOHNSON
 DRAWN BY: M. J. JOHNSON


DATE	
BY	
FINAL SURVEY	
PLANNED	
NOTE BOOK	
AREAS CHECKED	
NO.	

DATE	
BY	
ORIGINAL SURVEY	
PLANNED	
NOTE BOOK	
AREAS CHECKED	
NO.	

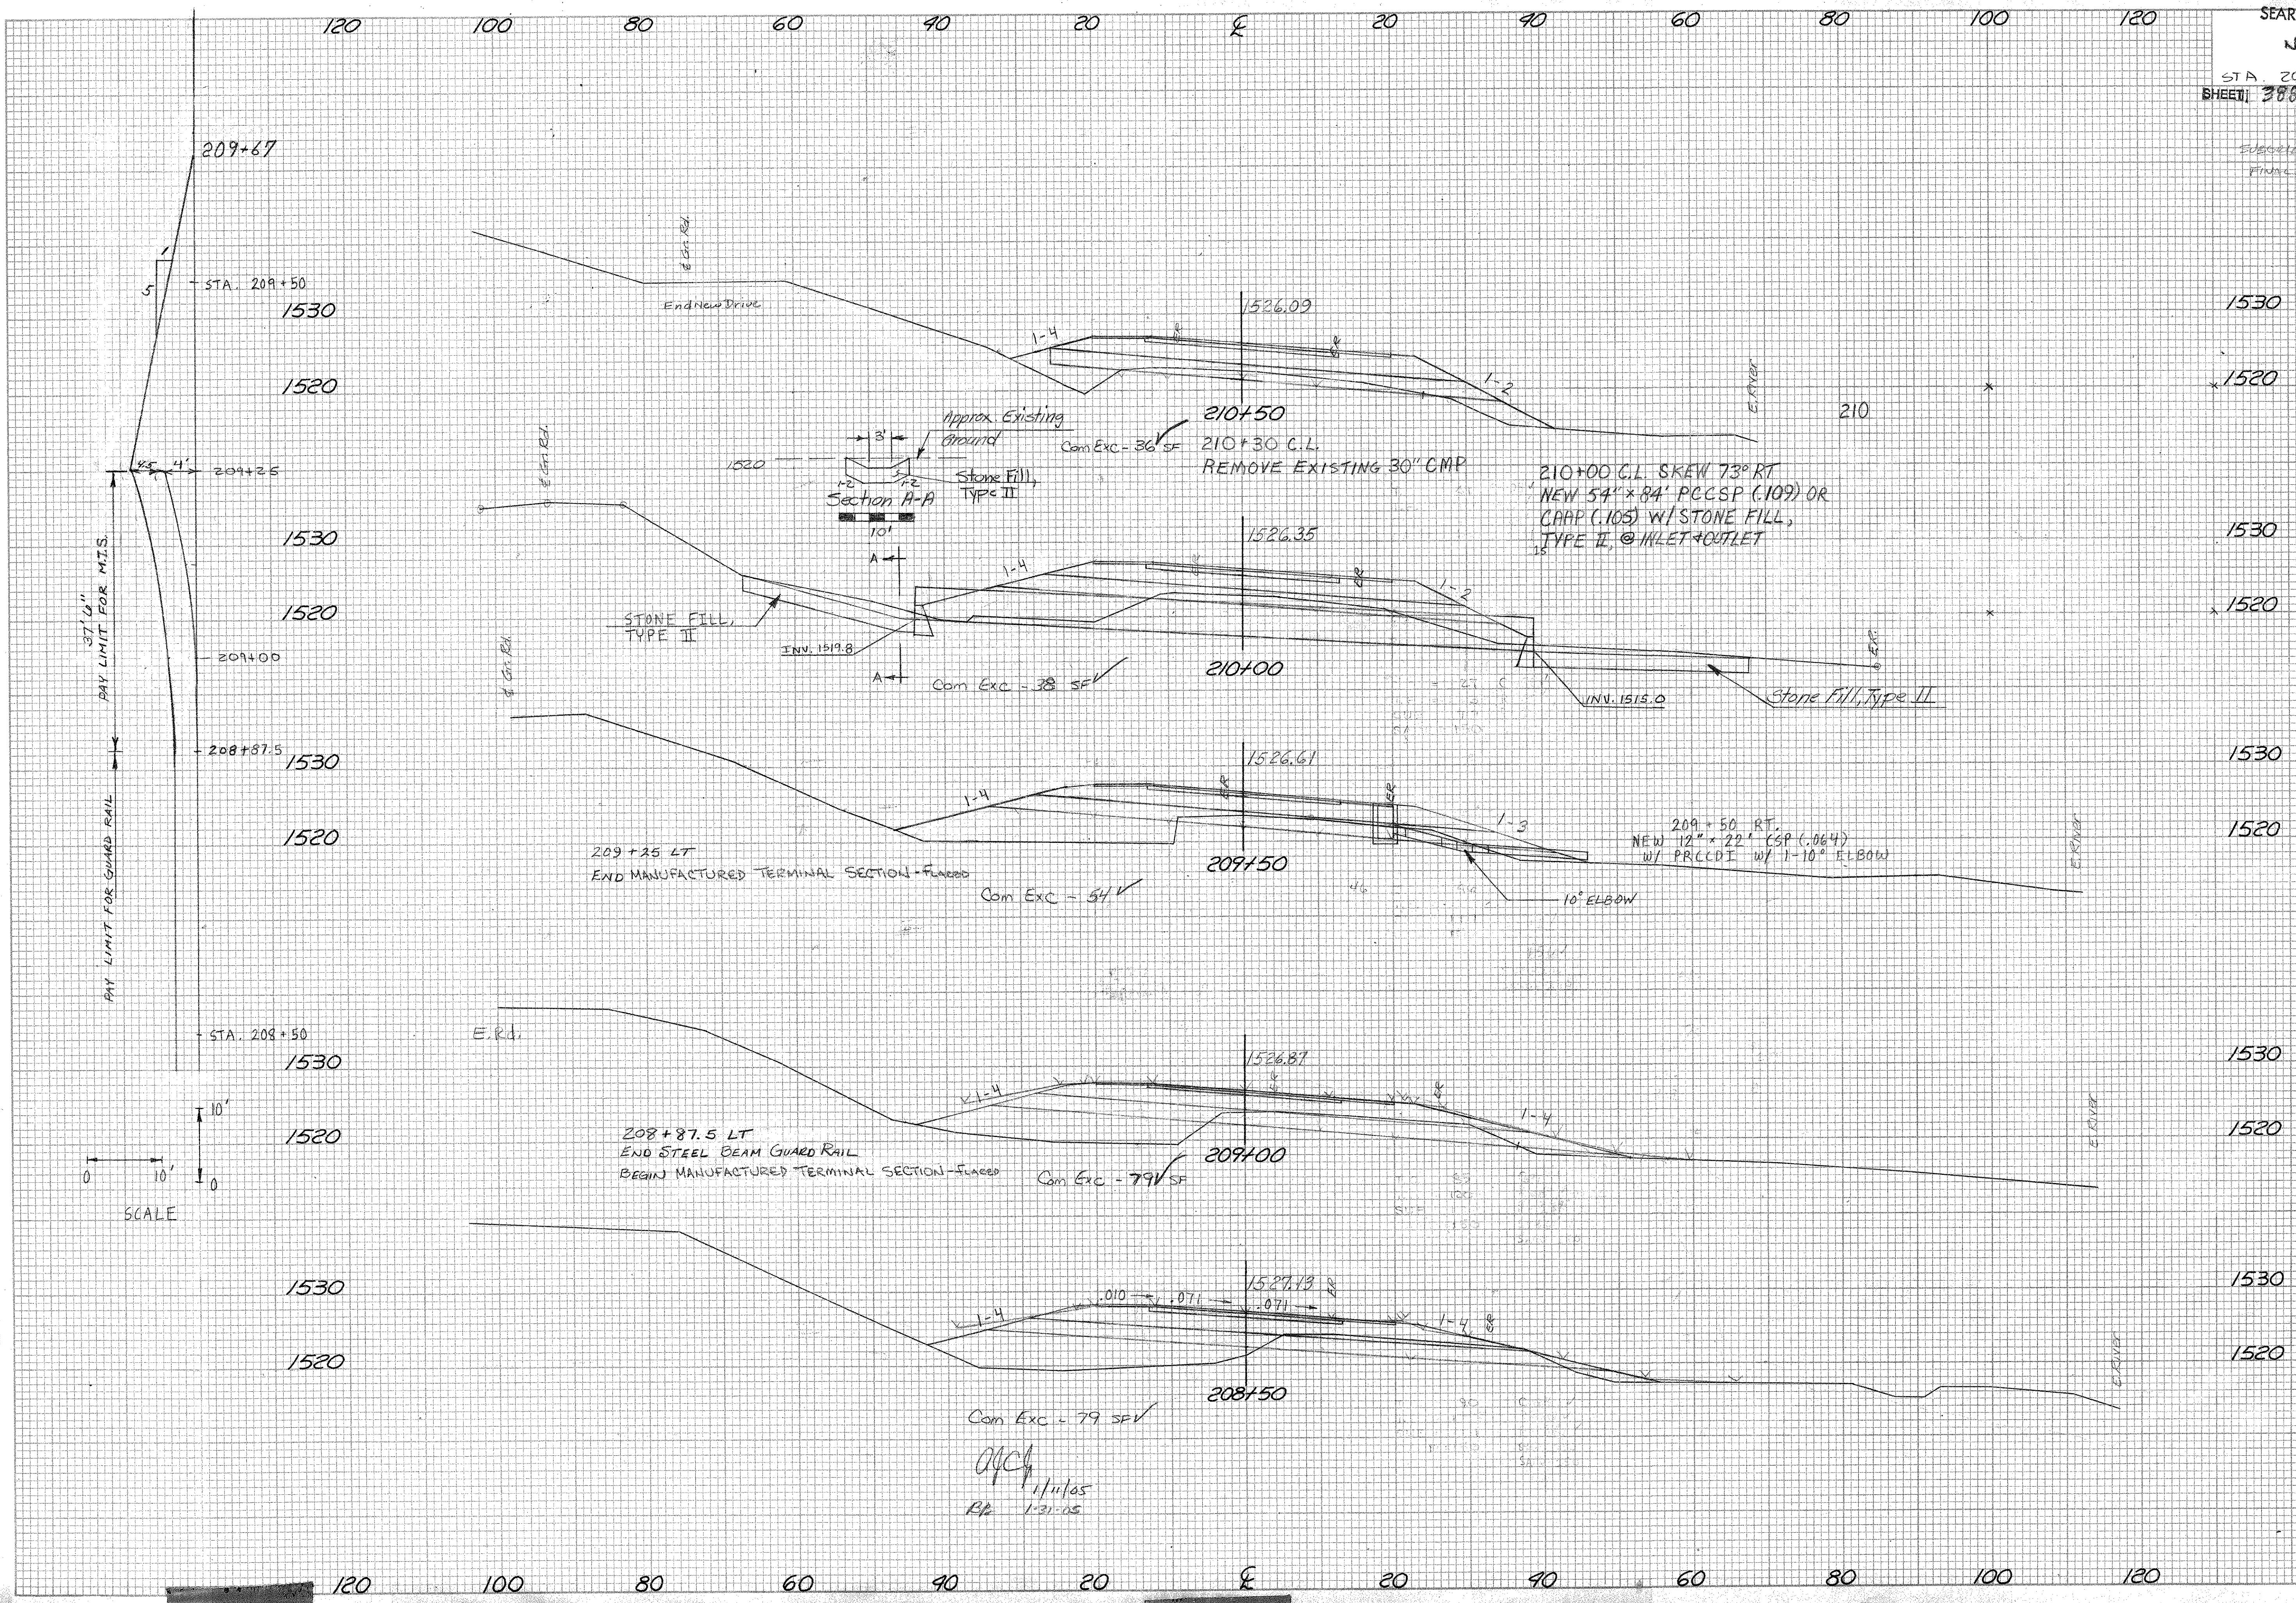

PAY LIMIT FOR M.T.S.

PAY LIMIT FOR GUARD RAIL

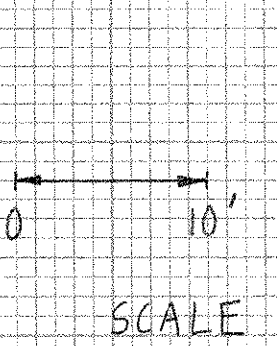

11/11/05
 BP 1-31-05