


V. MANN 29 JAN 04  
2016 CORRECTED BY M.W. 11 APR 04

DATE	
BY	
DESIGNED	
PLOTTED	
TEMPLATE	
ROUTE BOOK	
AREAS CHECKED	
NO.	

DATE	1/12/05
BY	W.R.C.
DESIGNED	
PLOTTED	
TEMPLATE	
ROUTE BOOK	
AREAS CHECKED	
NO.	

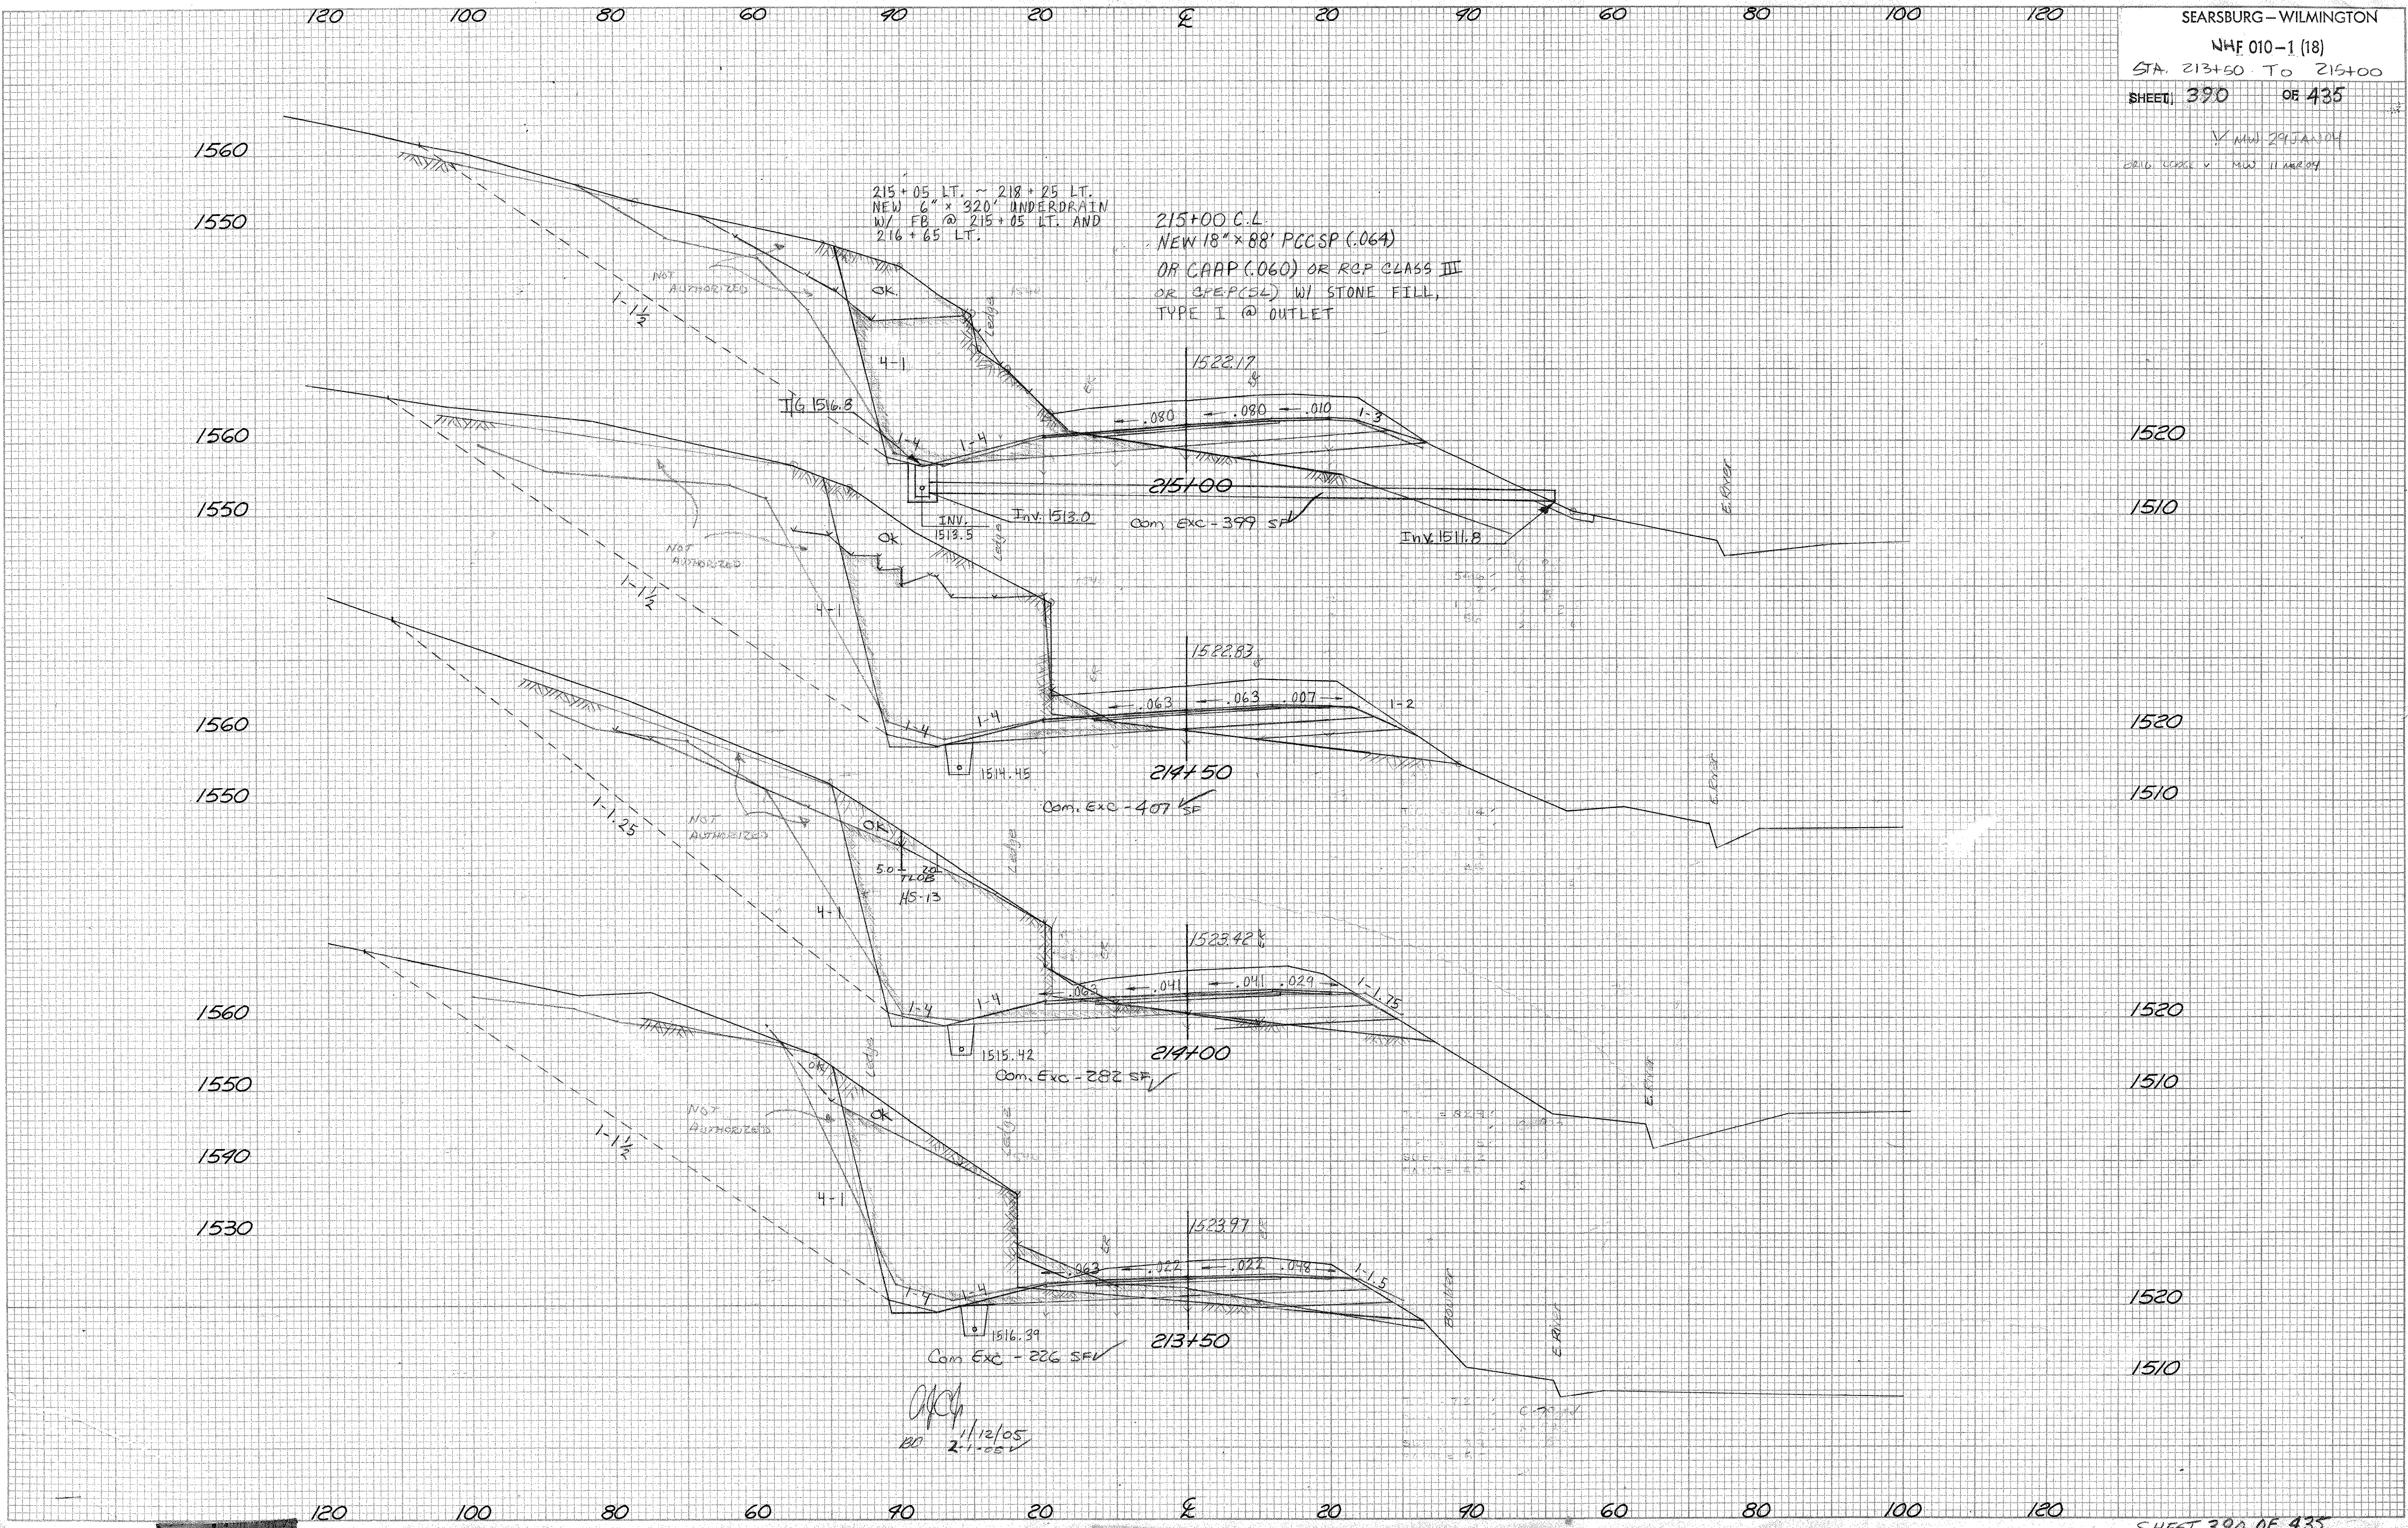

215+05 LT. ~ 218+25 LT.  
NEW 6" x 320" UNDERDRAIN  
W/ FB @ 215+05 LT. AND  
216+65 LT.

215+00 C.L.  
NEW 18" x 88" PCCSP (.064)  
OR CAAP (.060) OR RCP CLASS III  
OR SPEP (34) W/ STONE FILL,  
TYPE I @ OUTLET

W.R.C.  
1/12/05  
2-1-05