


DATE	
BY	
FINAL SURVEY	
EXHIBIT	
PLOTTED	
TEMPLATE	
AREAS	
CHECKED	
NO.	

DATE	
BY	
ORIGINAL SURVEY	
EXHIBIT	
PLOTTED	
TEMPLATE	
AREAS	
CHECKED	
NO.	

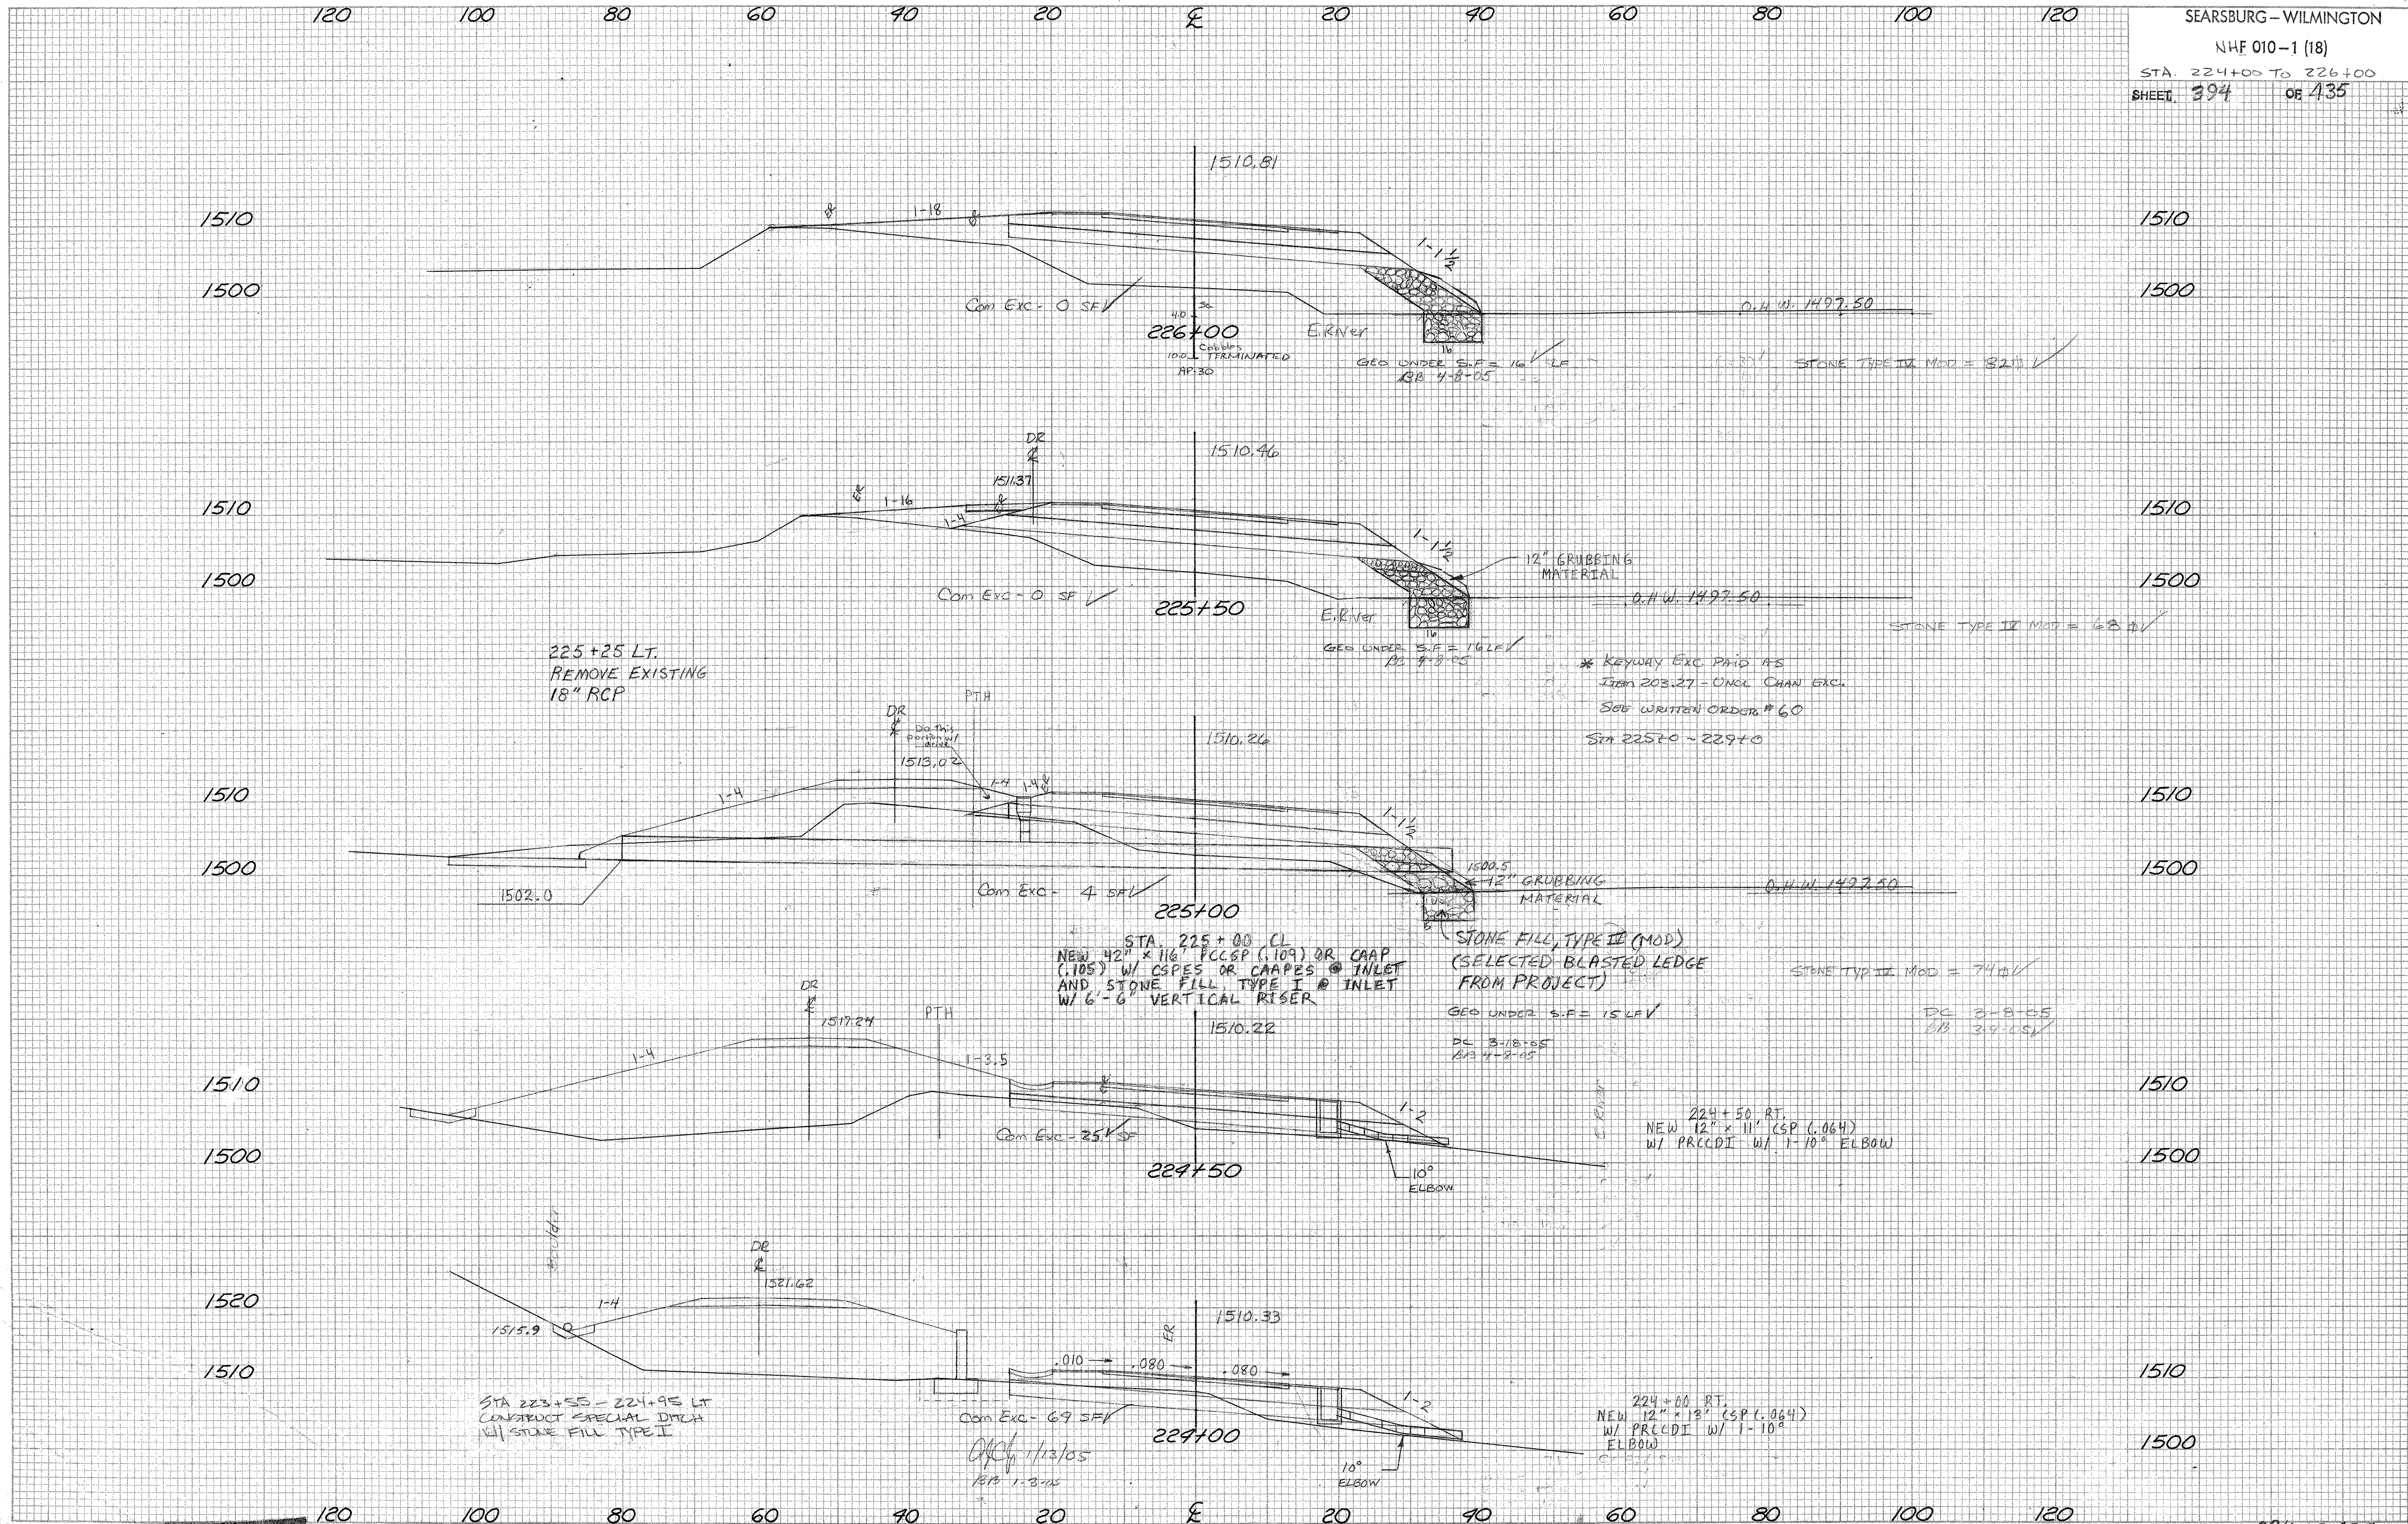

* KEYWAY EXC PAID AS
ITEM 203.27 - UNCL CHAN EXC.
SEE WRITTEN ORDER # 60
Sta 22520 - 22910

STA. 225+00 (L)
NEW 42" x 116" RCCSP (.109) OR CAPP
(.105) W/ CSSES OR CAPPES @ INLET
AND STONE FILL, TYPE I @ INLET
W/ 6'-6" VERTICAL RISER

STONE FILL, TYPE II (MOD)
(SELECTED BLASTED LEDGE
FROM PROJECT)

GEO UNDER S.F. = 15.4 LF
DL 3-18-05
RB 4-8-05

STONE TYPE II MOD = 74.41

DL 3-18-05
RB 3-9-05

224+50 RT.
NEW 12" x 11" (CSP (.064))
W/ PRECEDI W/ 1-10° ELBOW

224+00 RT.
NEW 12" x 13" (CSP (.064))
W/ PRECEDI W/ 1-10° ELBOW

STA 223+55 - 224+95 LT
CONSTRUCT SPECIAL DITCH
W/ STONE FILL TYPE I

Com Exc - 69 SF
1/2" 1/10" 105
1/2" 1-3-105