


REVISED 1590 V JAN 29 2004
 REVISED 1580
 REVISED 1570
 REVISED 1560
 REVISED 1550
 REVISED 1540

DATE	
BY	
FINAL SURVEY	
SUBMITTED	
NOTE BOOK	
NO.	

DATE	
BY	
ORIGINAL SURVEY	
SUBMITTED	
NOTE BOOK	
NO.	

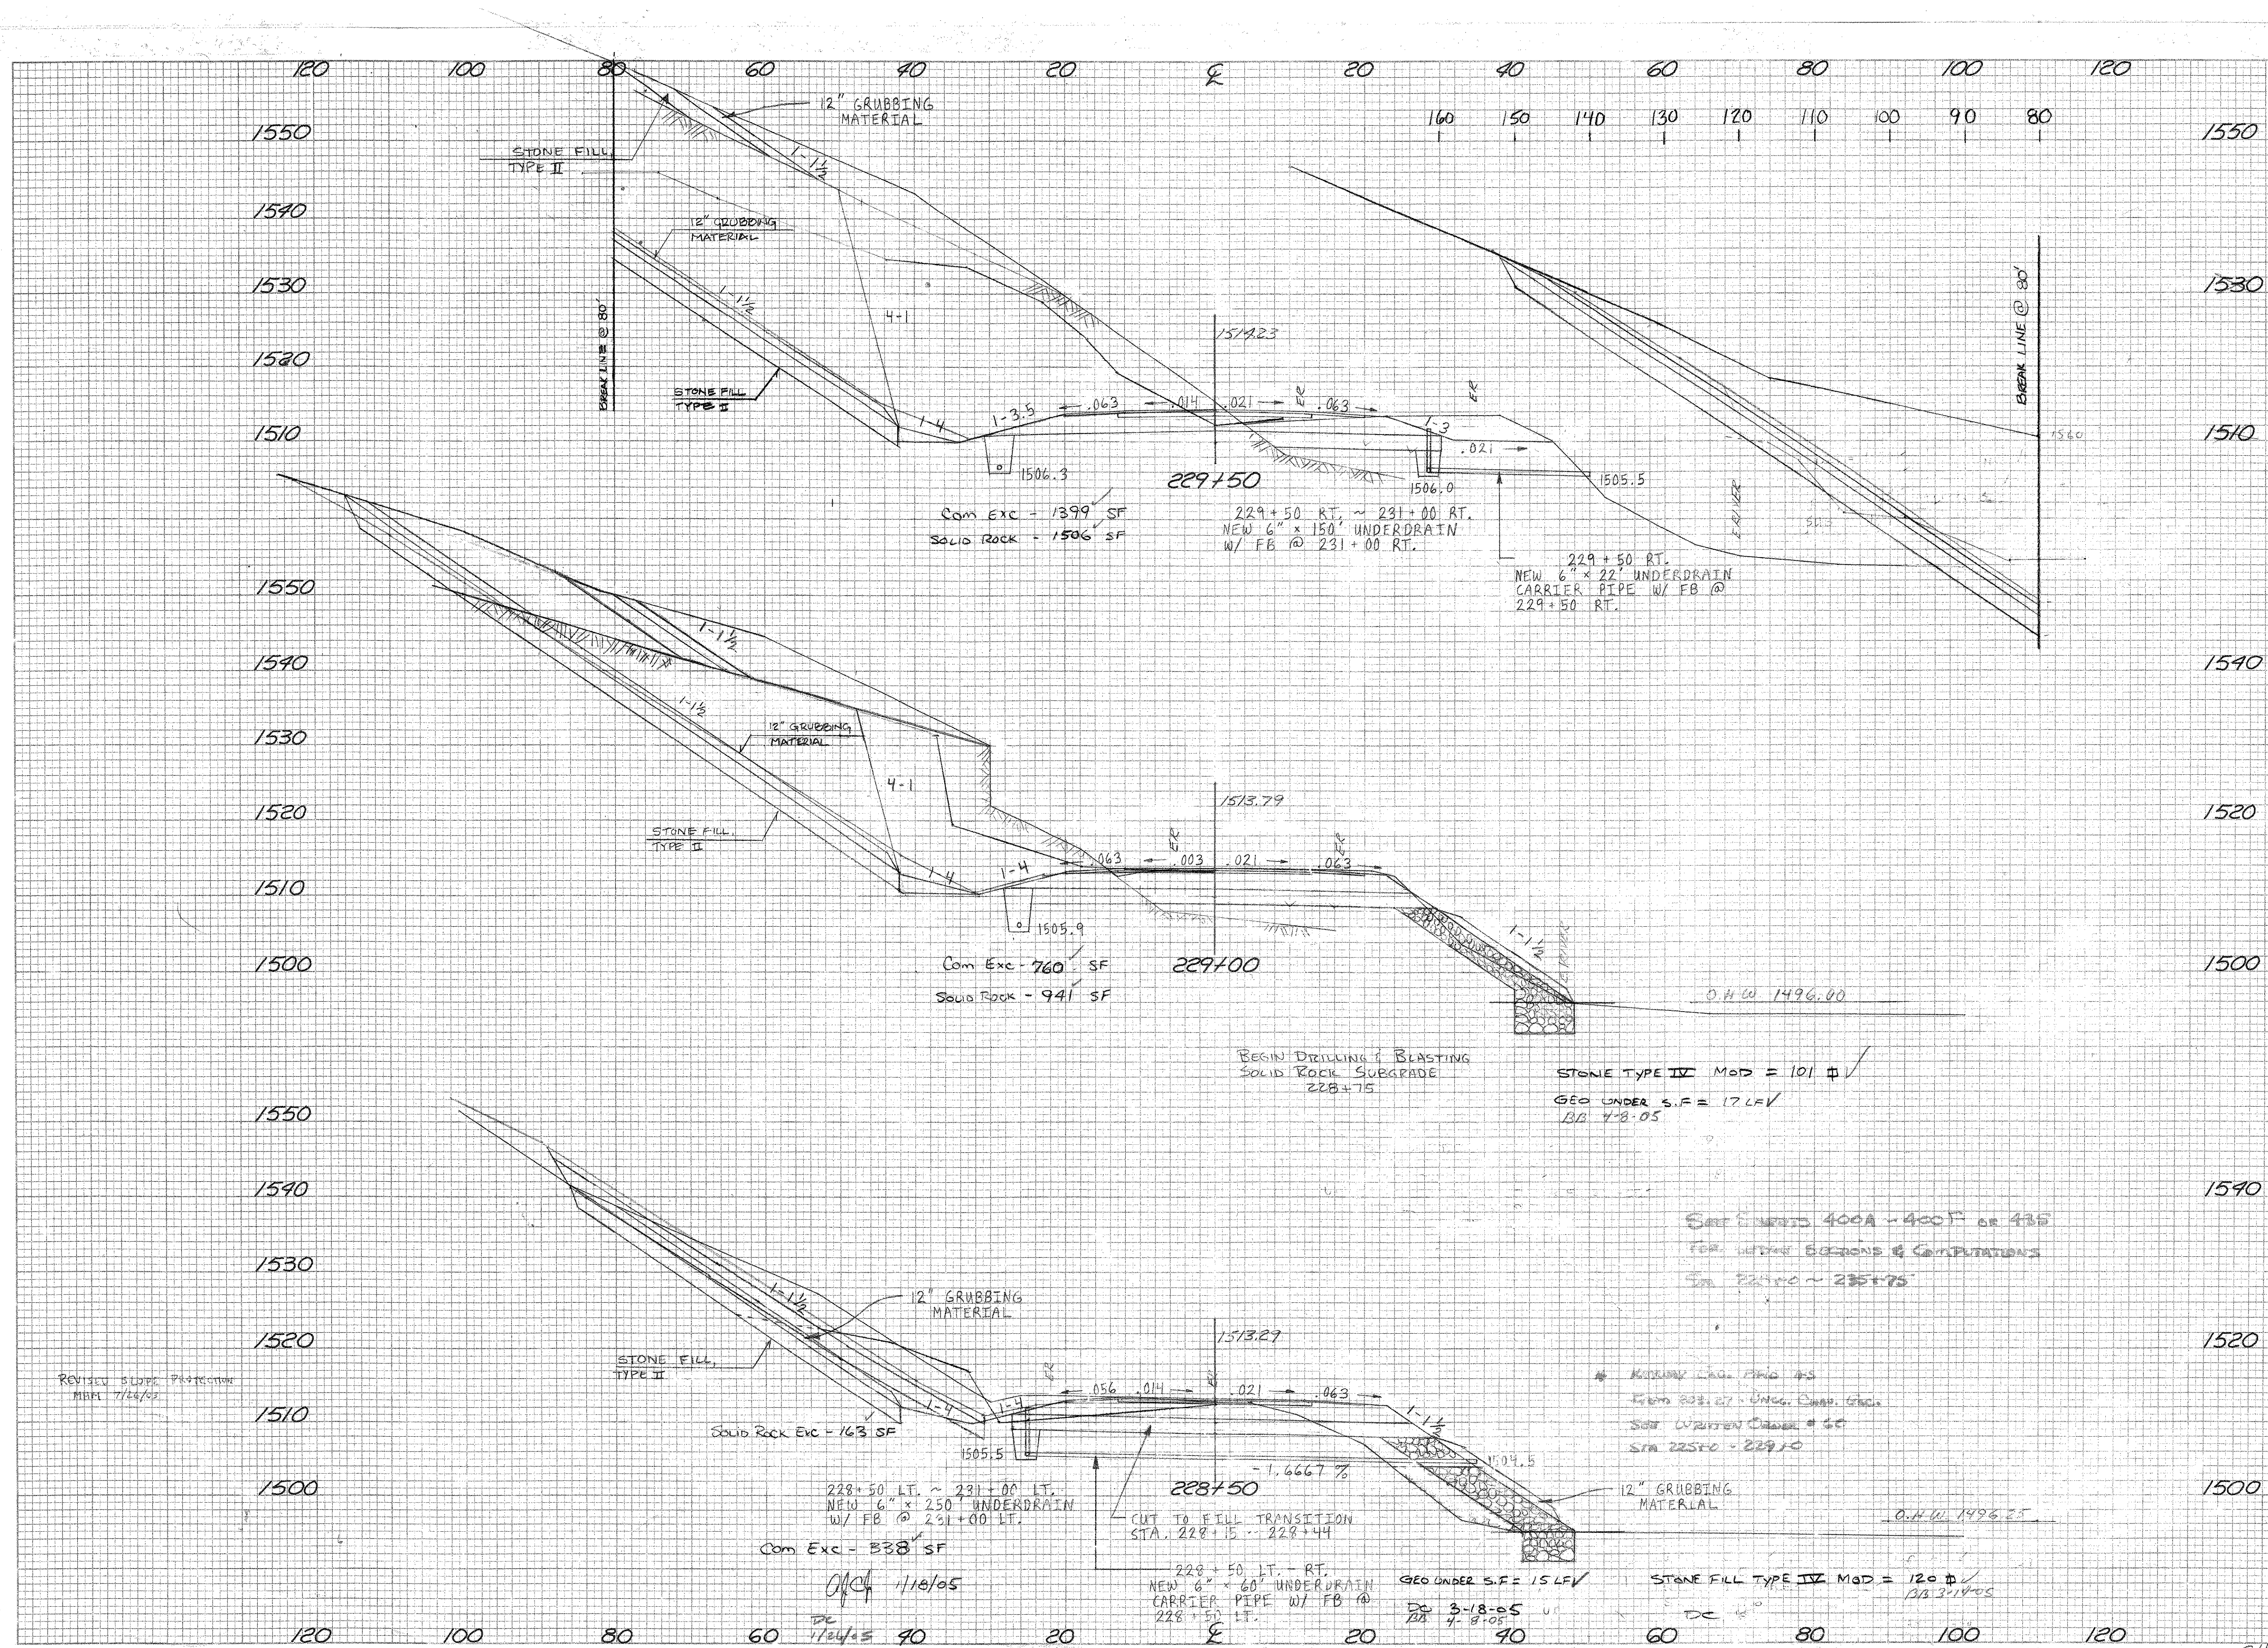

REVISED SLOPE PROTECTION
 APRIL 7/14/05

SEE SHEETS 400A - 400F OR 435
 FOR UTILITY ELEVATIONS & COMPUTATIONS
 STA 228+00 - 229+75

* MATERIAL LOG AND ASS
 FROM 2021 27 - UNCL. COND. GROUND
 SOIL WRITTEN ORDER # 60
 STA 228+00 - 229+50

DC 11/10/05

DC 3-18-05
 DB 4-8-05

STONE FILL TYPE IV MOD = 120 #
 1313-1405