
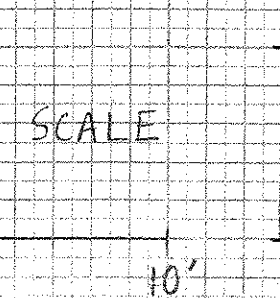


DATE	
BY	
FINAL SURVEY	
SURVEYED	
PLOTTED	
NOTE BOOK	
AREAS	
CHECKED	
NO.	

DATE	
BY	
ORIGINAL SURVEY	
SURVEYED	
PLOTTED	
NOTE BOOK	
AREAS	
CHECKED	
NO.	

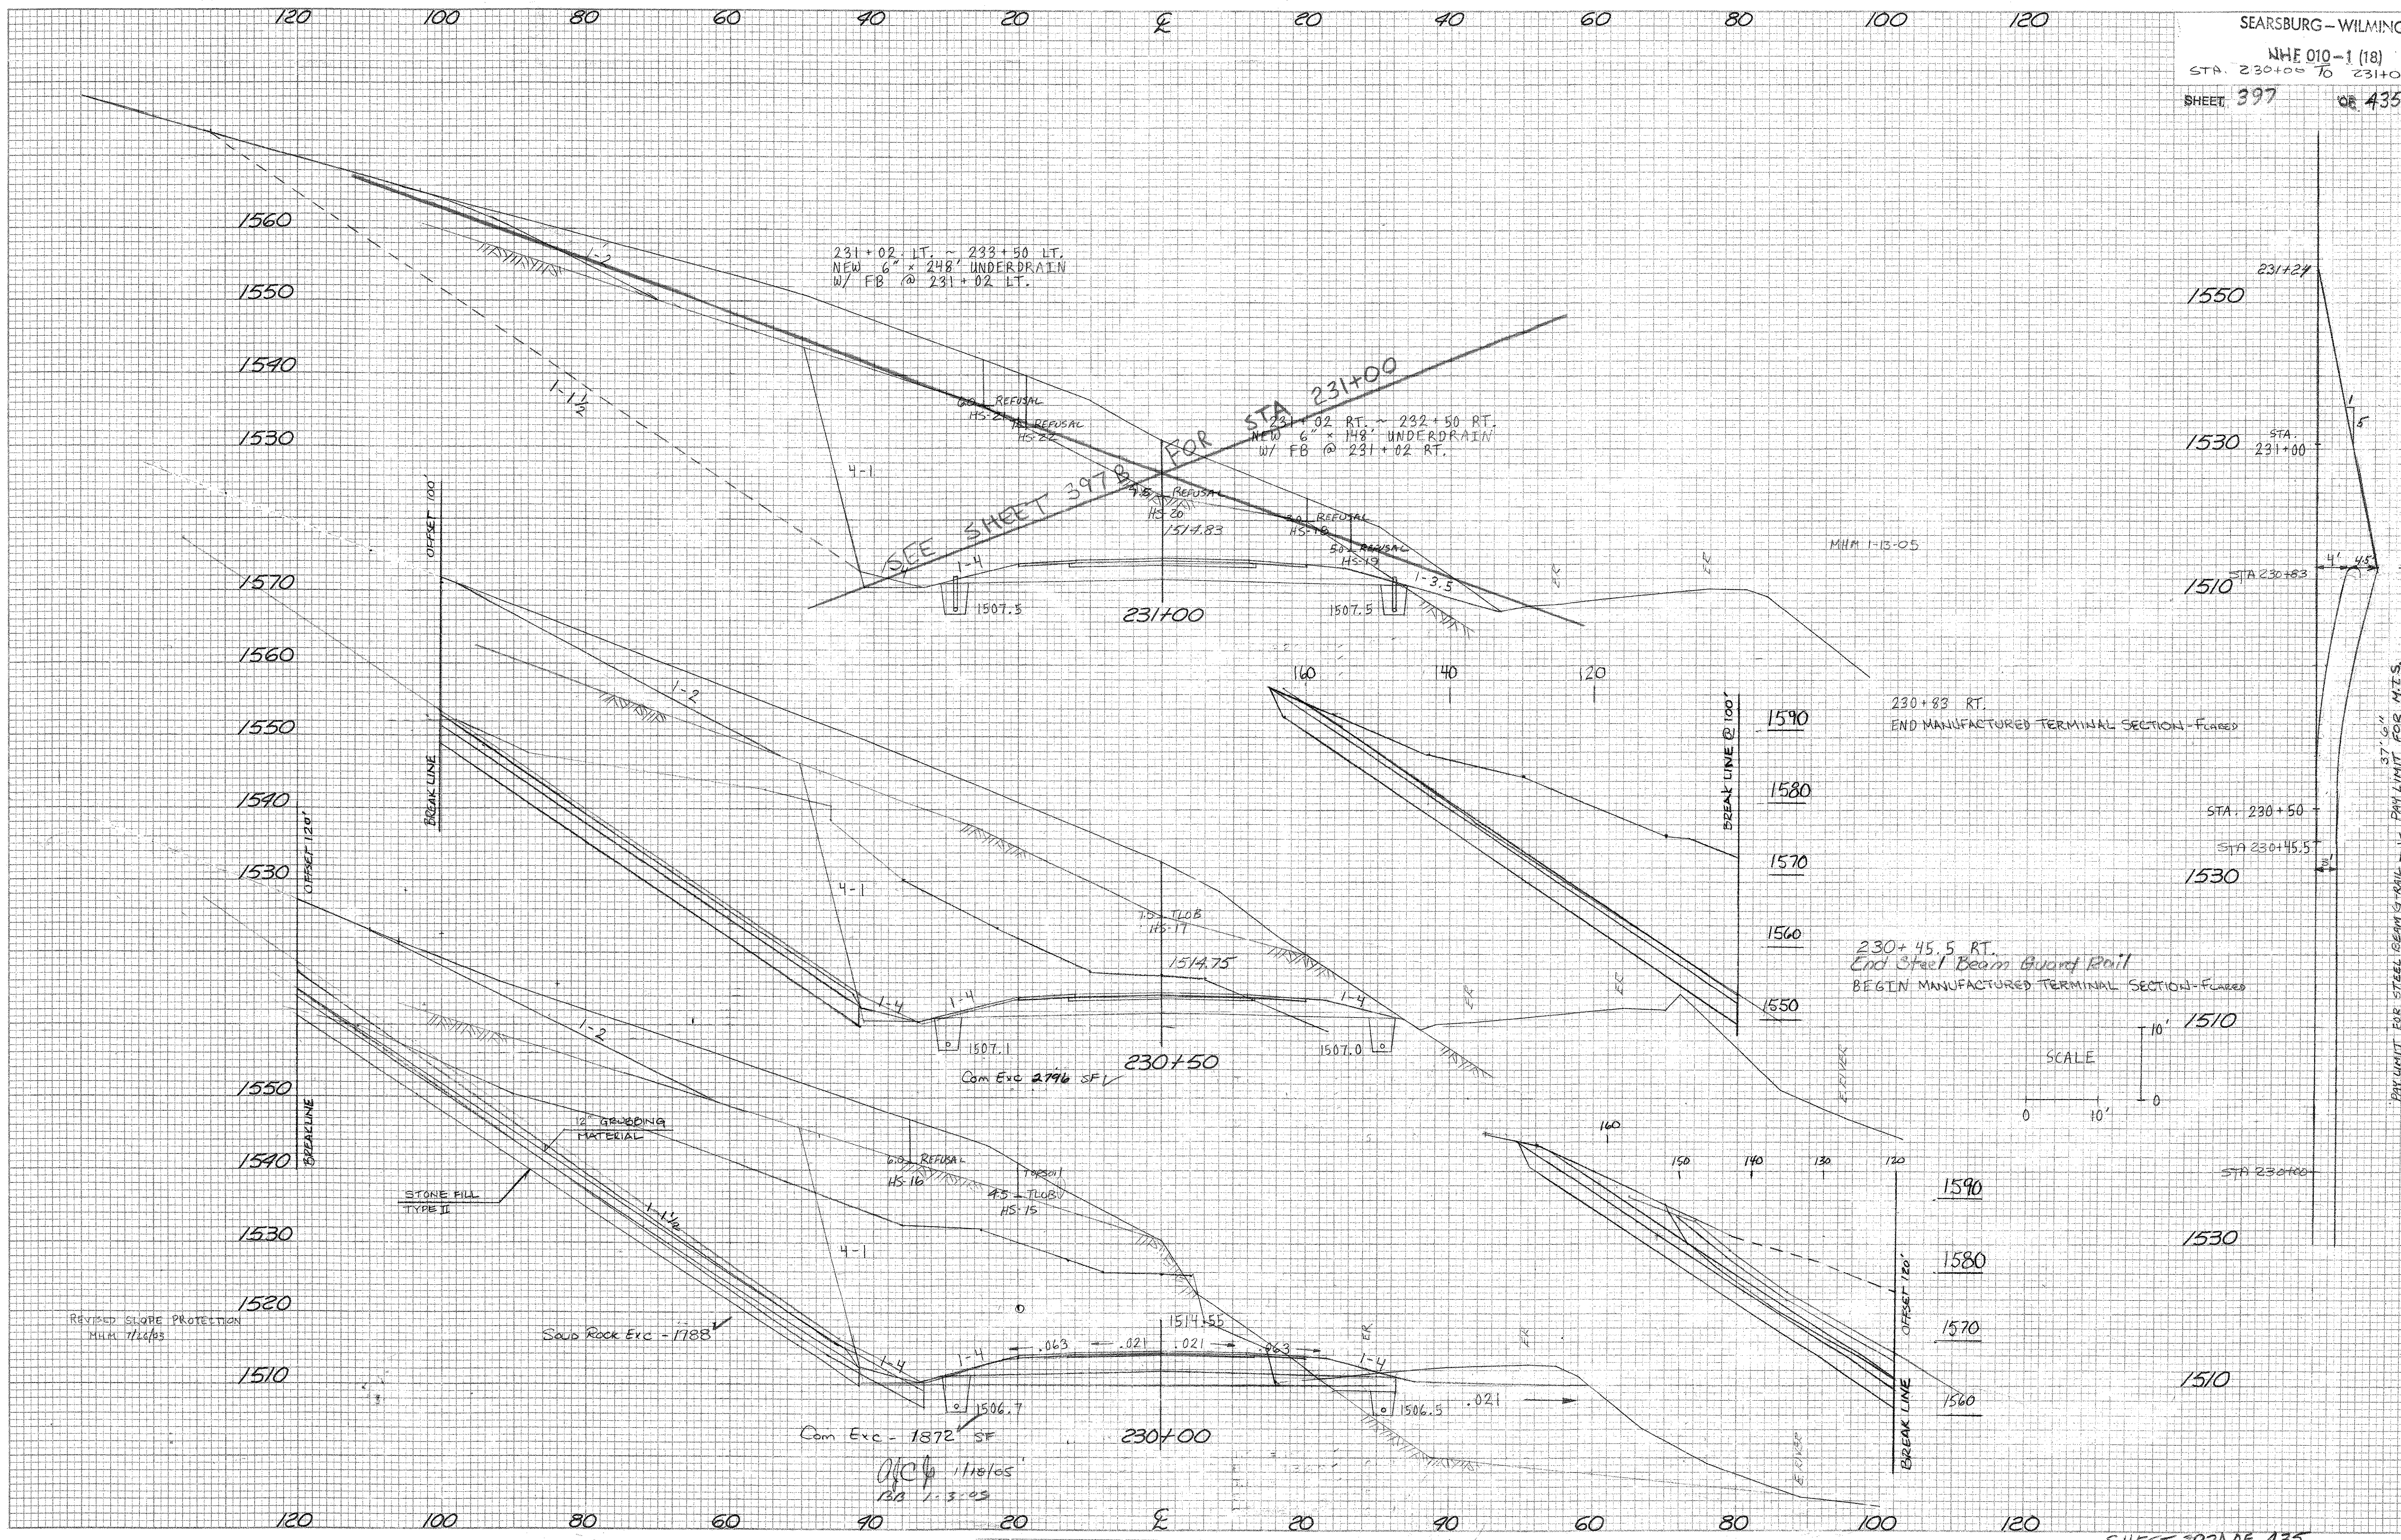

REVISED SLOPE PROTECTION
MUM 11/2/03

STONE FILL
TYPE II

2\"/>

Com Exc - 1872 SF
1118/03
13/1.3.03