


DATE  
 BY  
 SURVEYED  
 TEMPLATE  
 AREAS CHECKED

DATE  
 BY

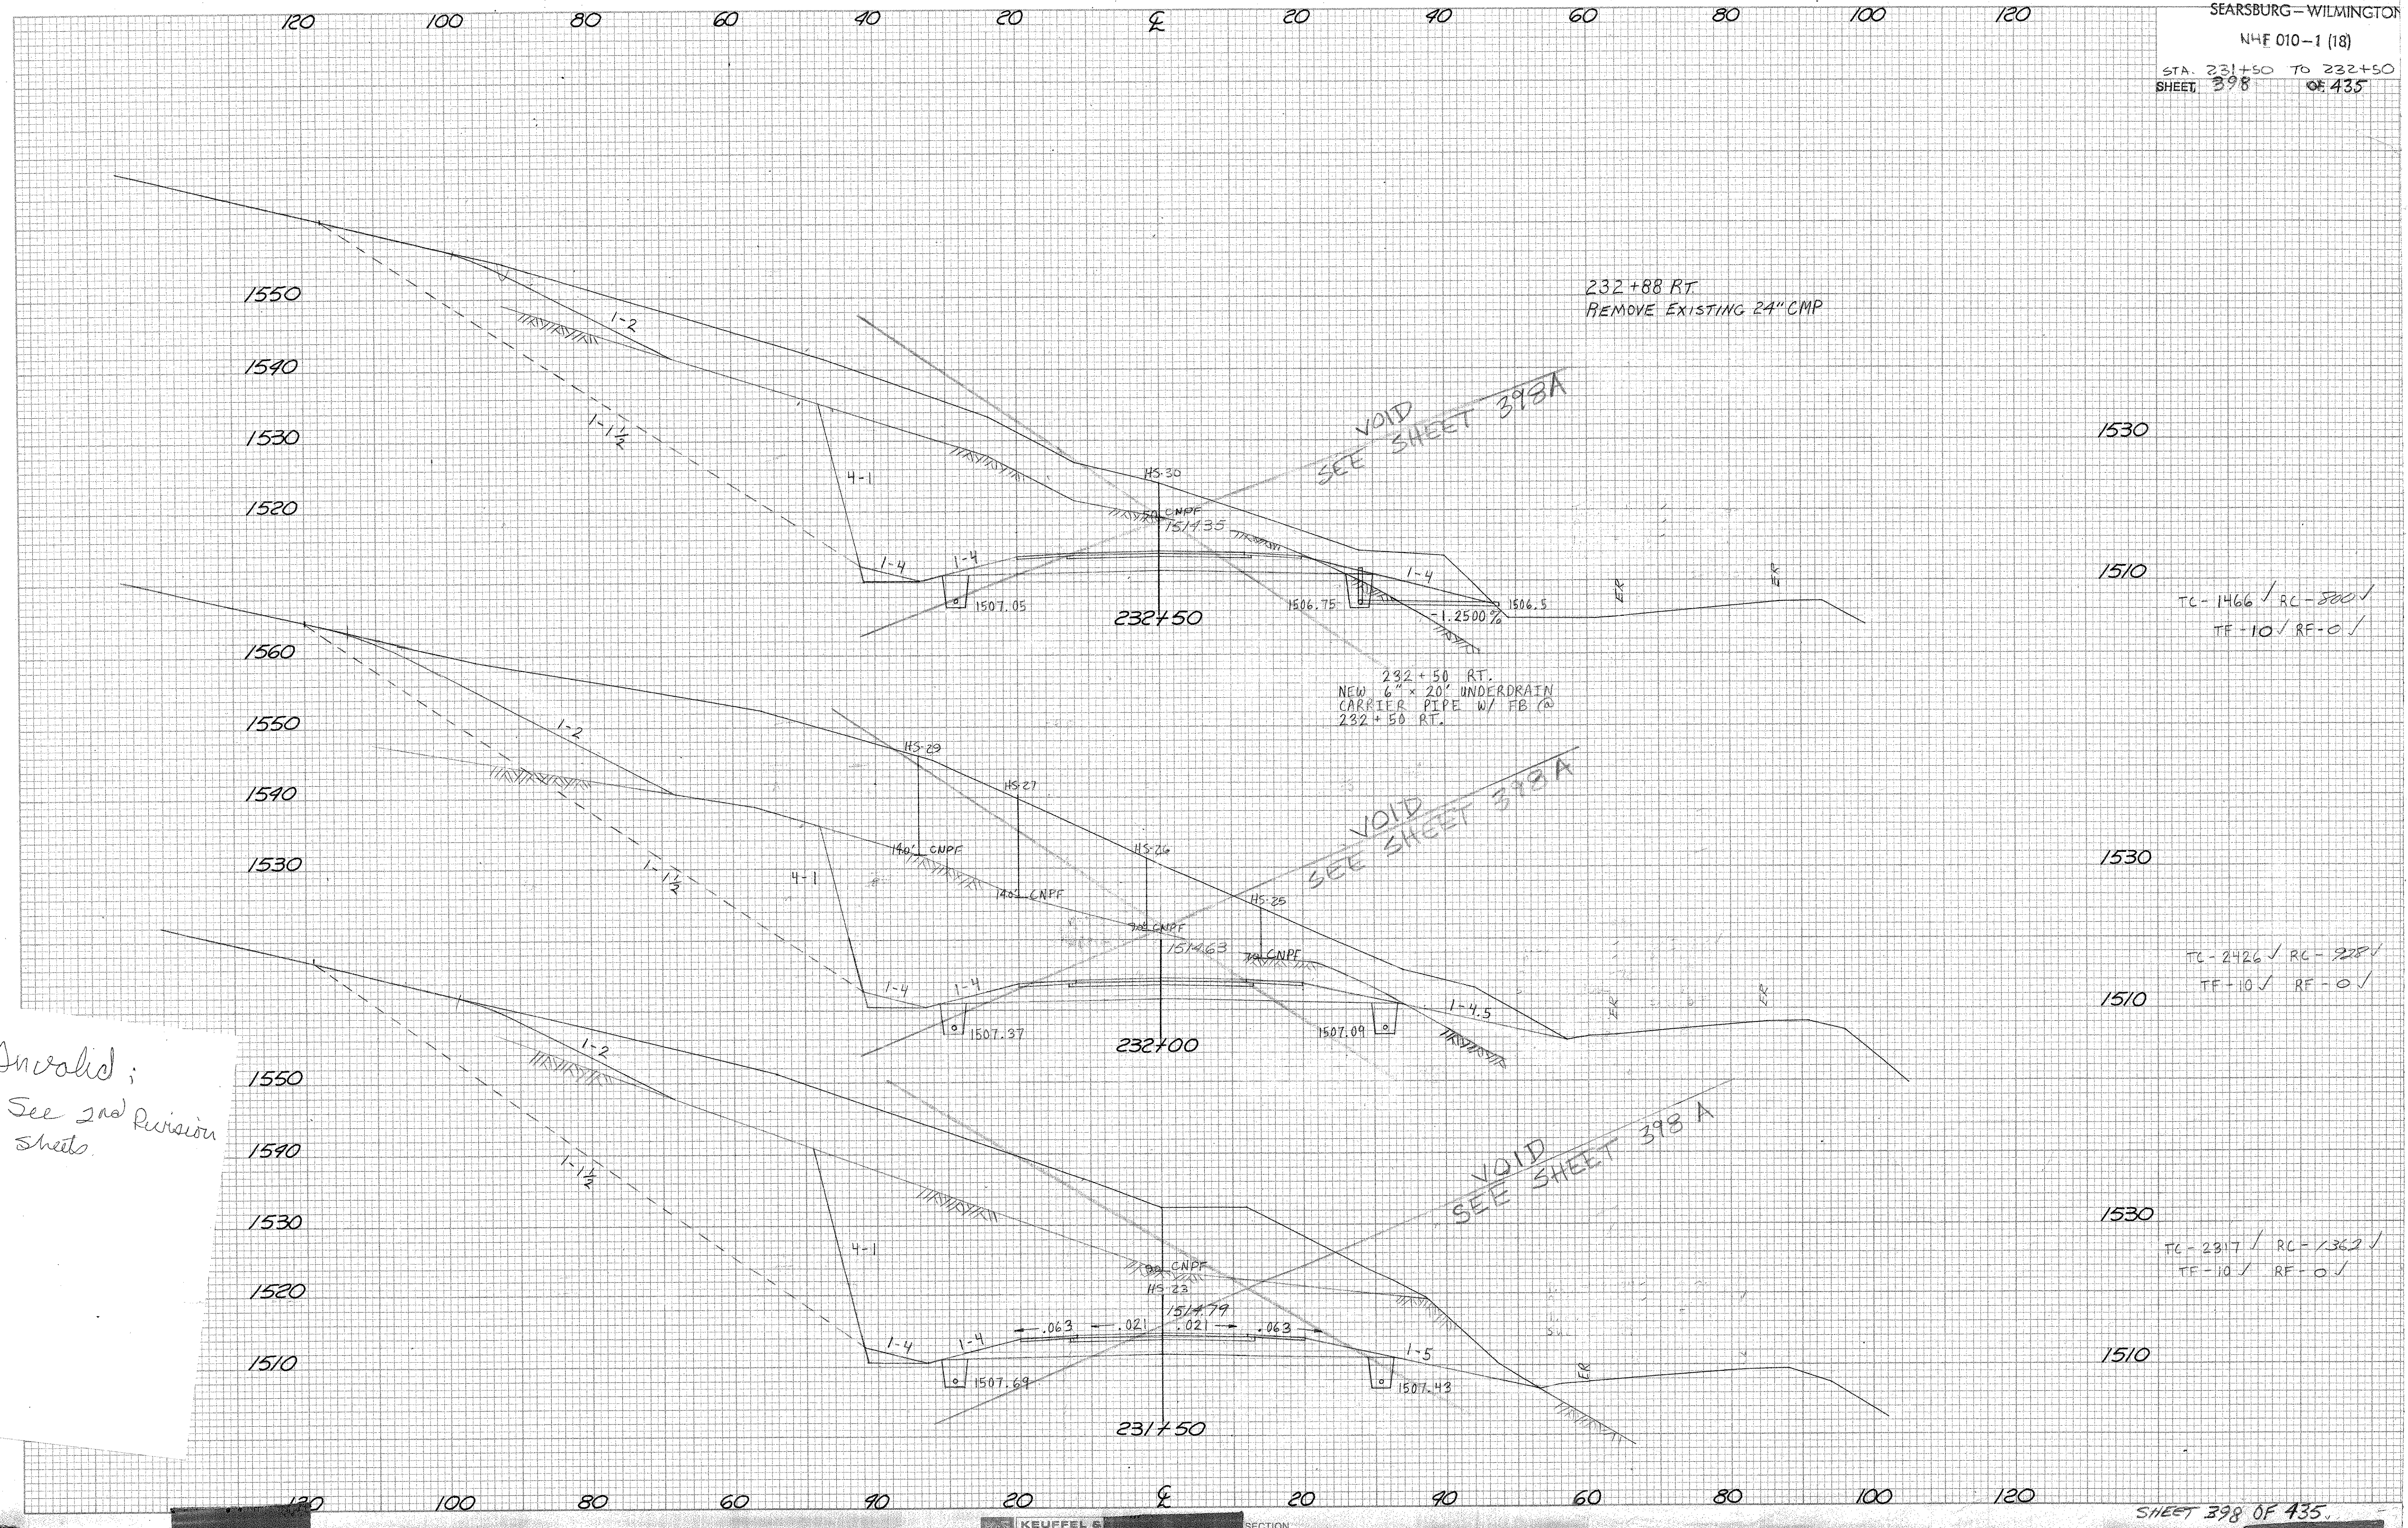

Invalid;  
 See 2nd Revision  
 sheets.