


FINAL SURVEY PLANTION
 DATE 02/27/2014
 DRAWN BY: J. L. GARDNER

ORIGINAL SURVEY PLANTION
 DATE 02/27/2014
 DRAWN BY: J. L. GARDNER

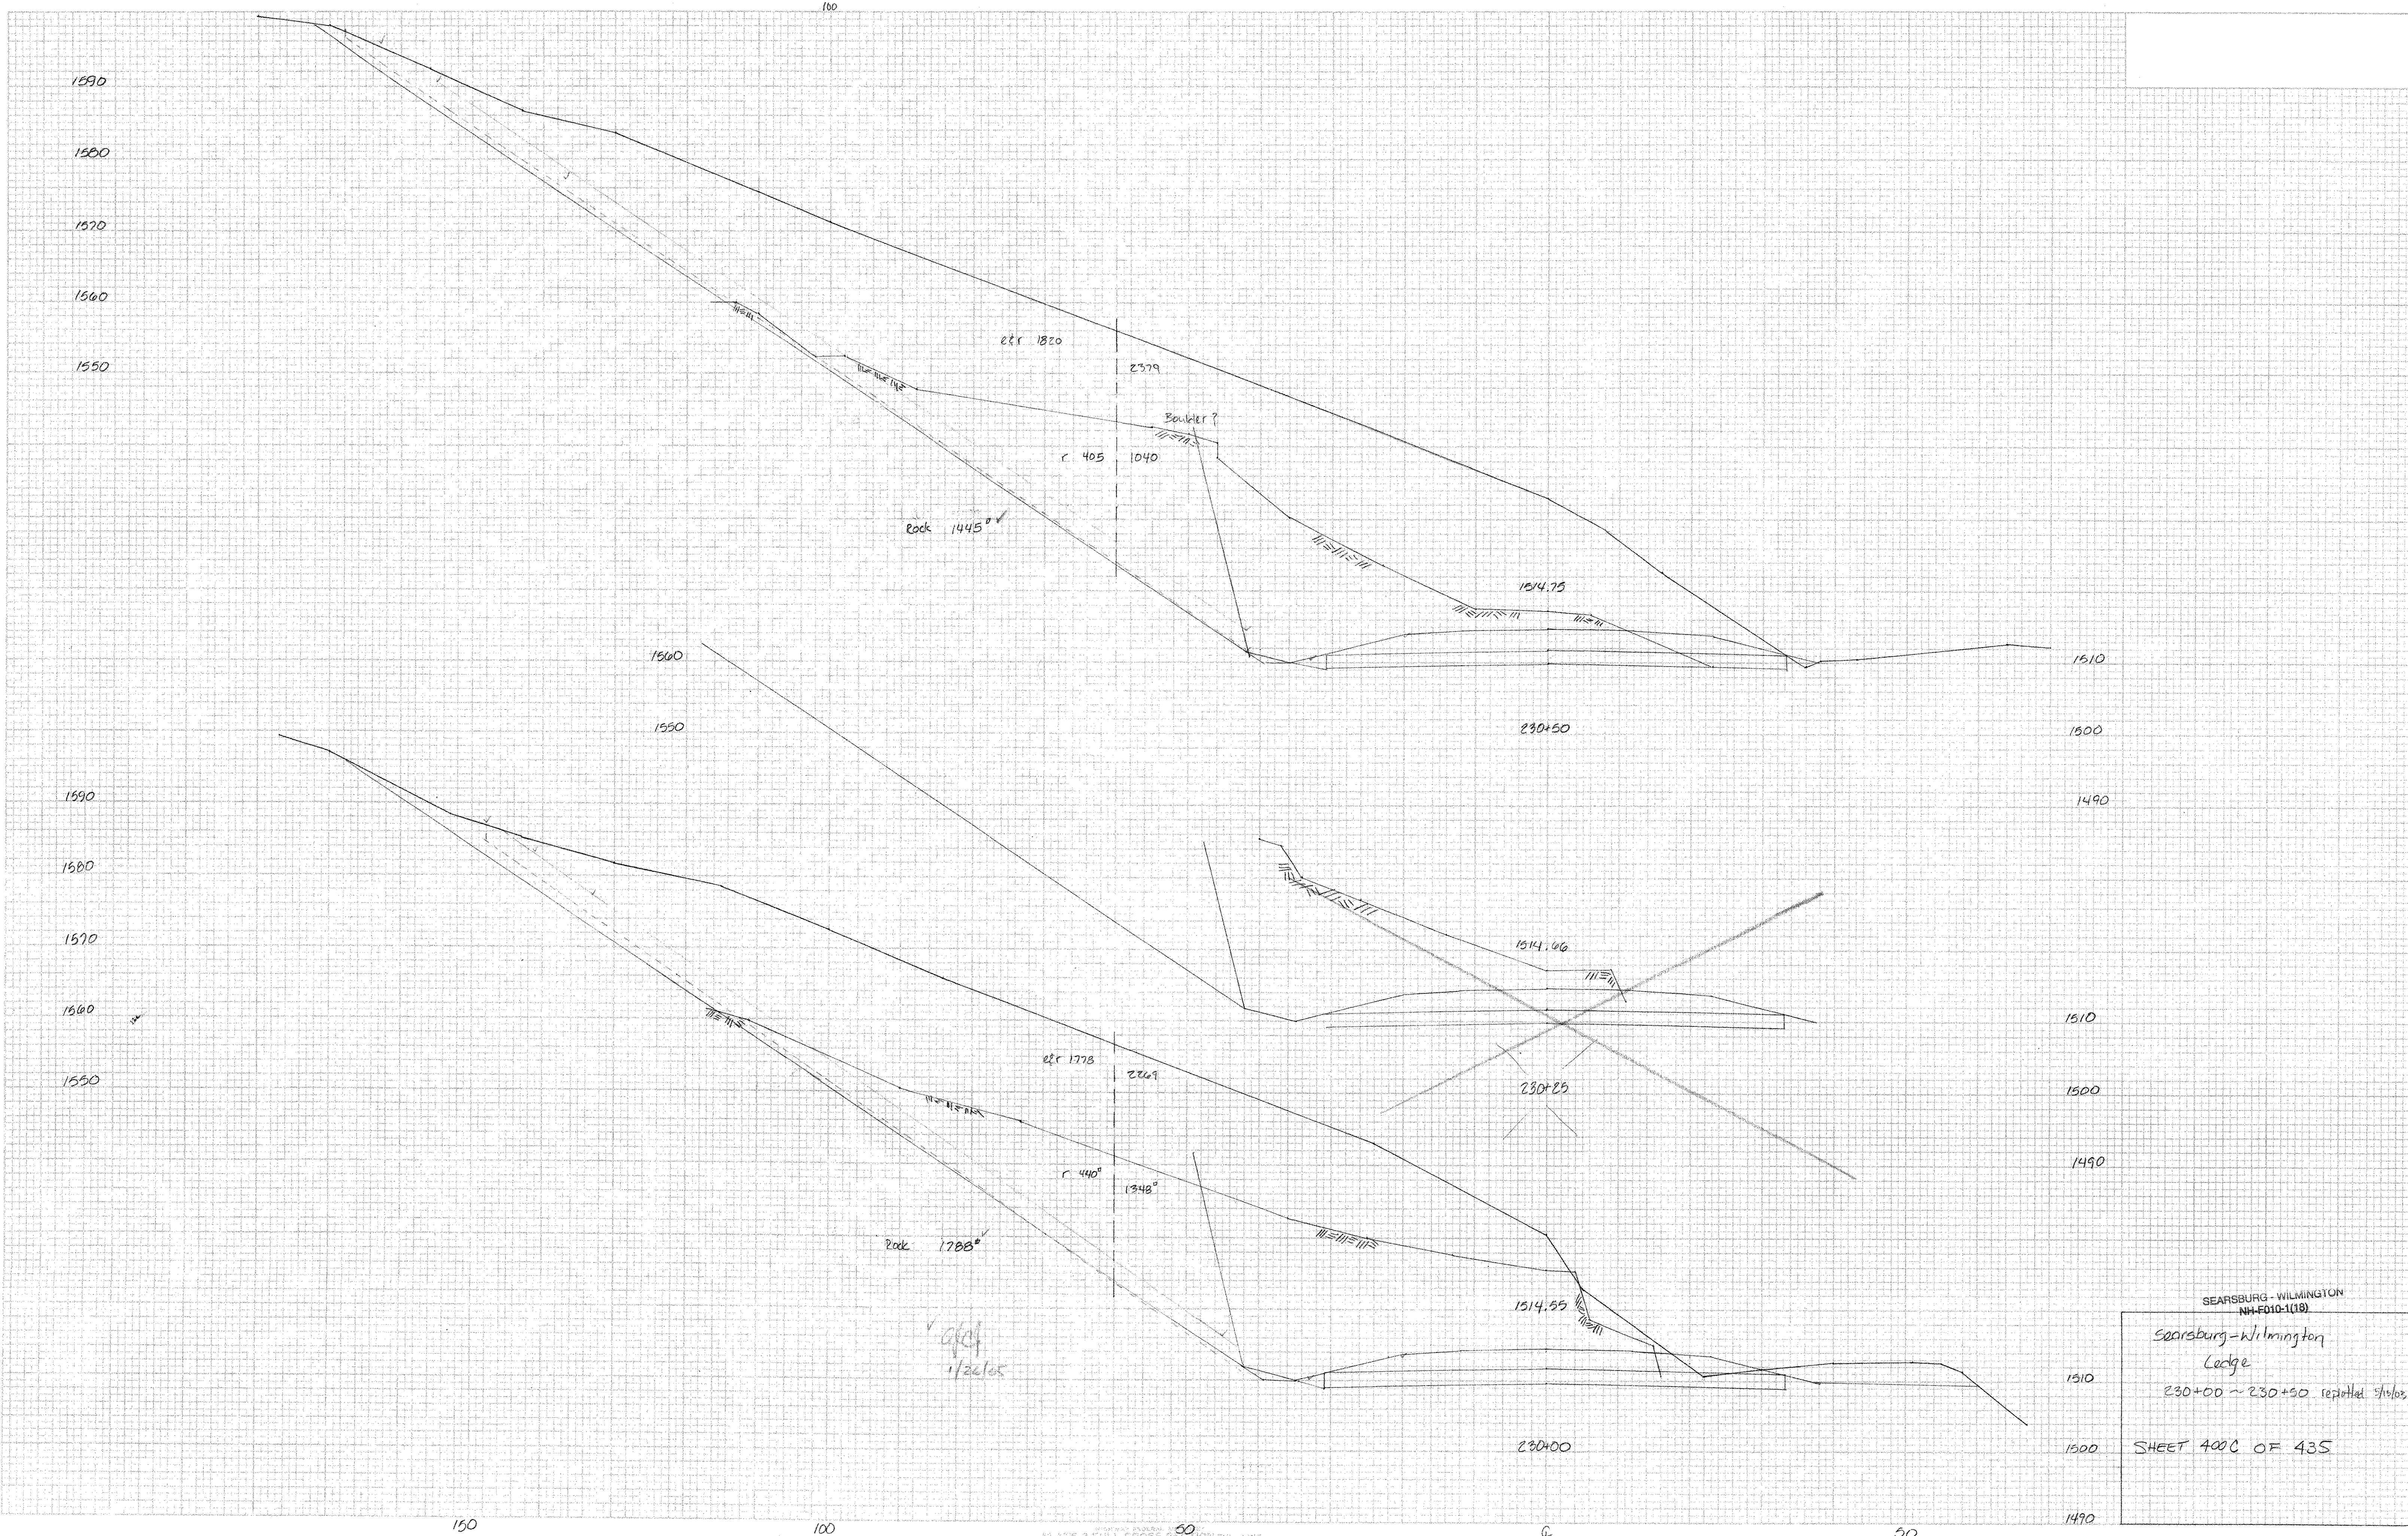

SEARSBURG - WILMINGTON
 NH-FO10-1(18)
 Searsburg-Wilmington
 Ledge
 230+00 ~ 230+50 reploted 9/16/03
 SHEET 400C OF 435