


FINAL SURVEY
 DATE: 11/21/05
 BY: JAMES C. GIBSON

CONSTRUCTION SURVEY
 DATE: 11/21/05
 BY: JAMES C. GIBSON

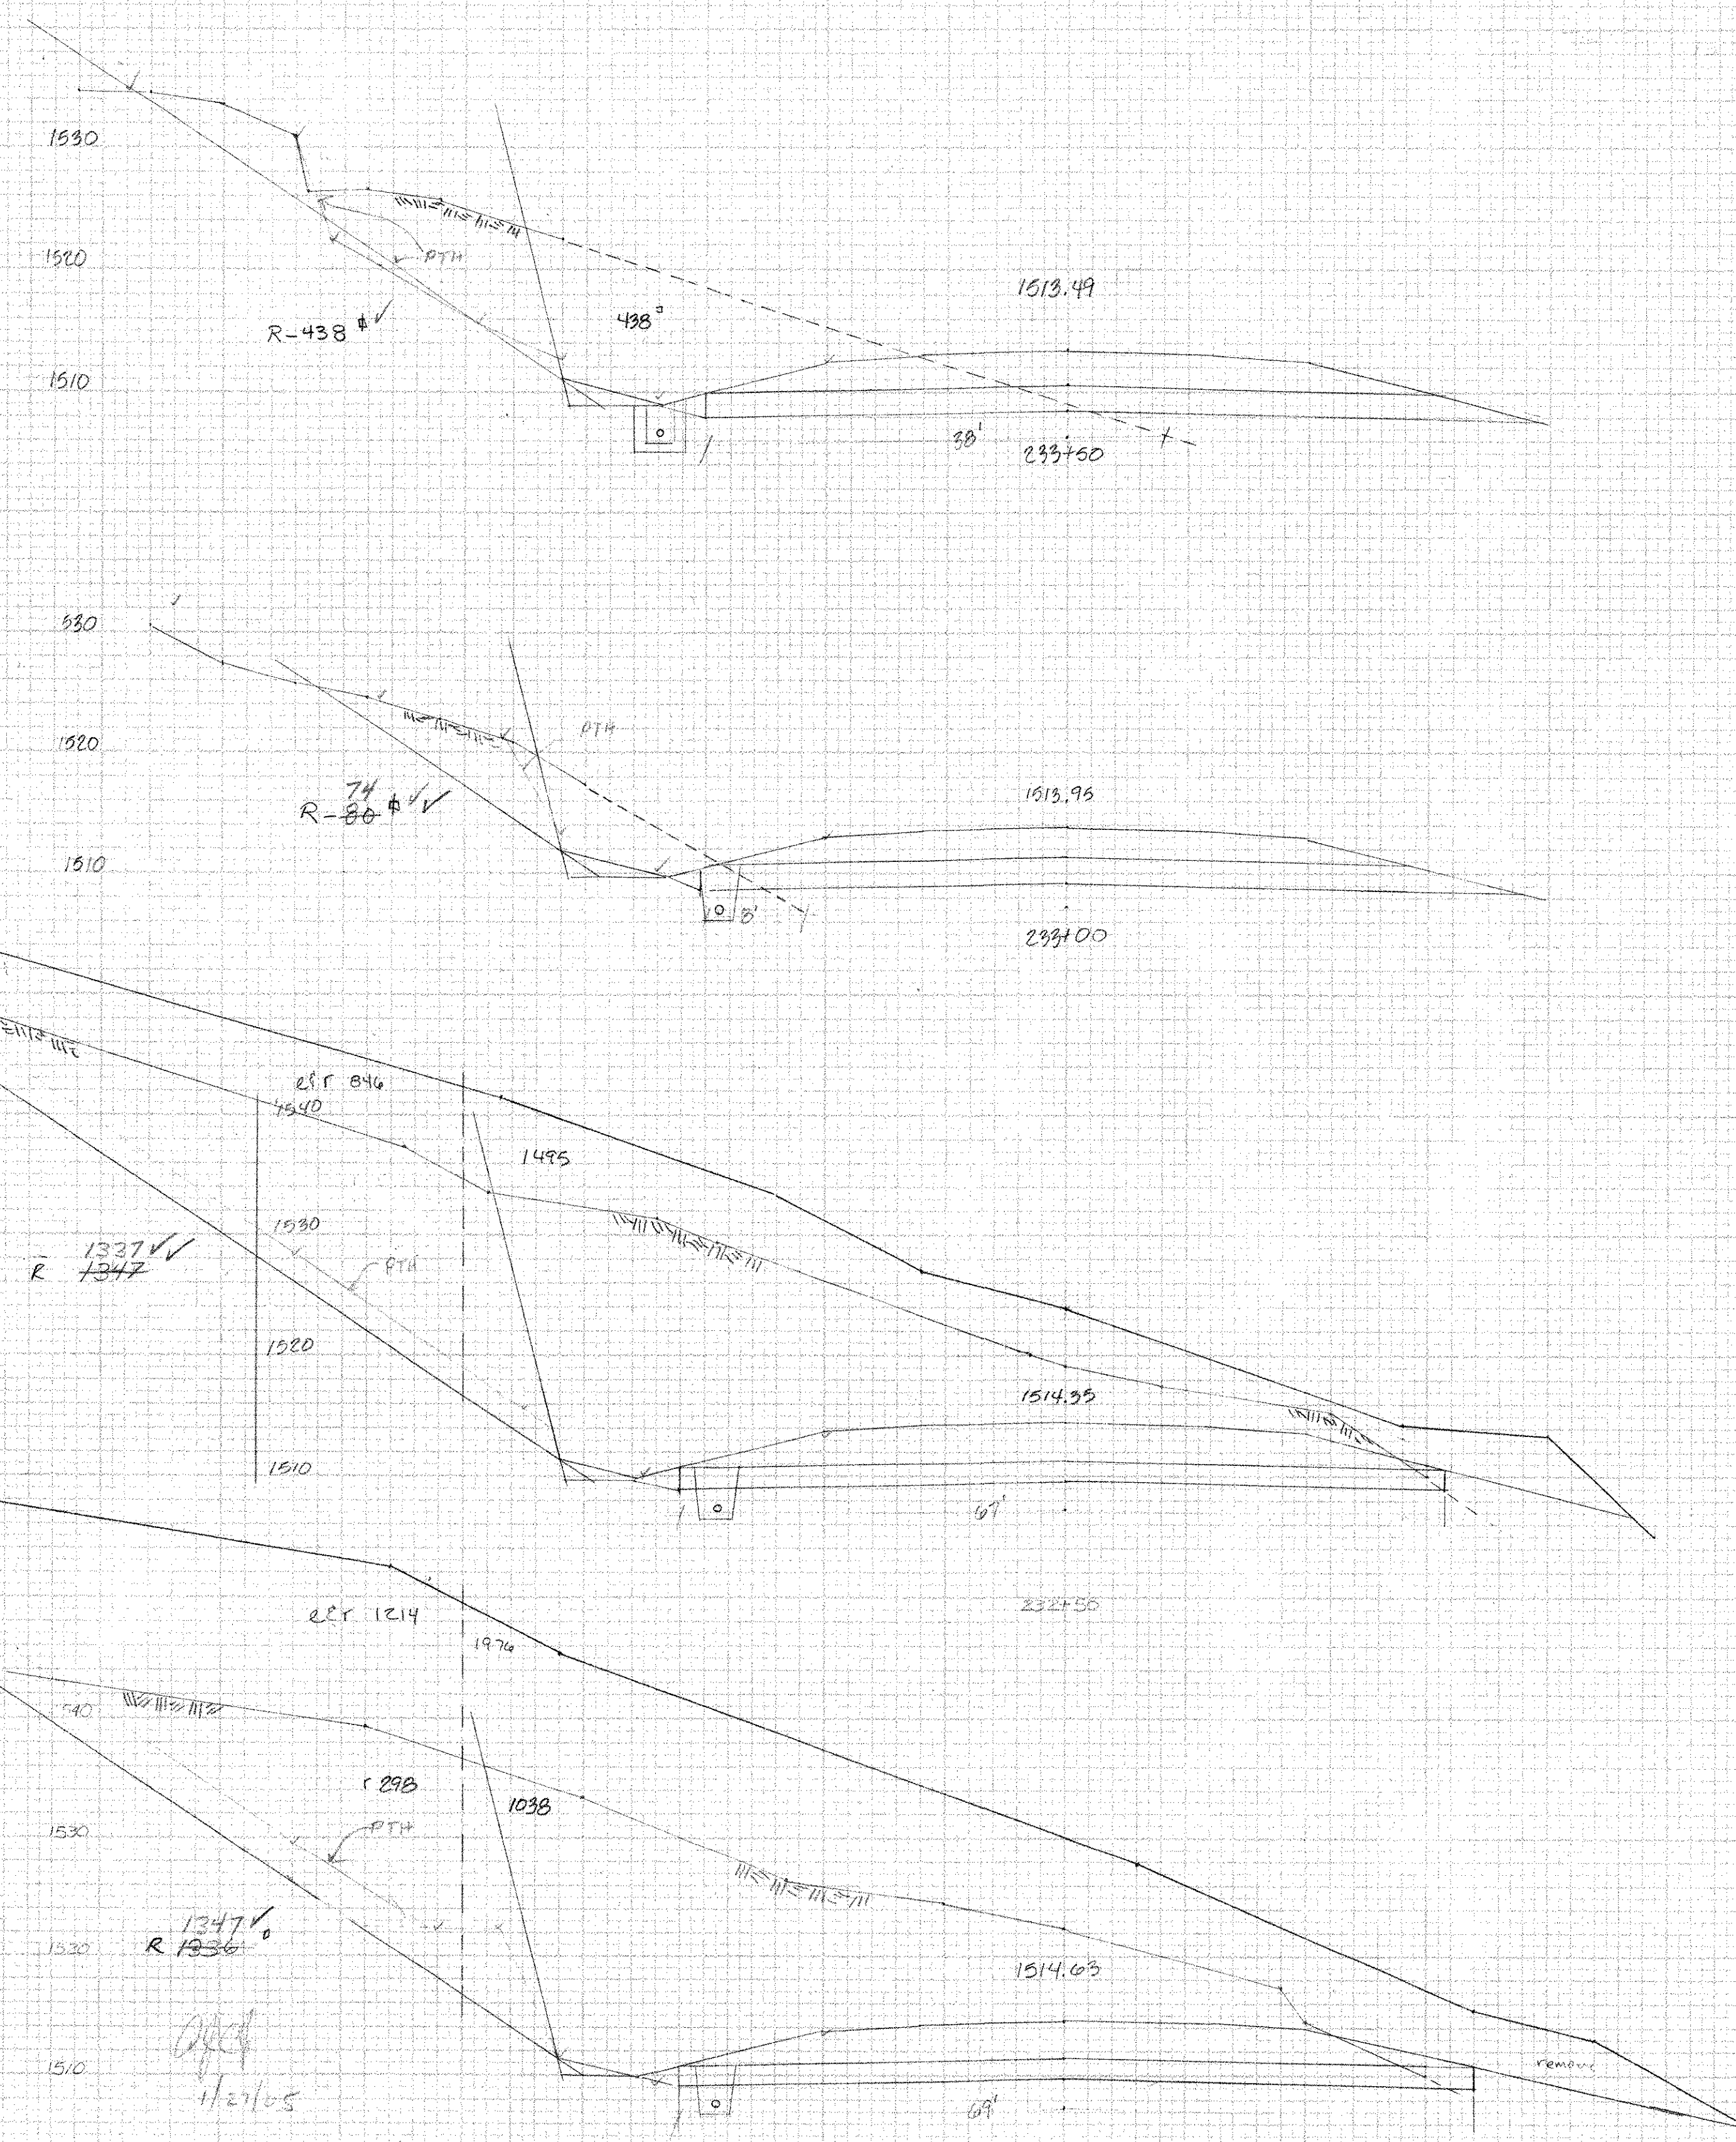

Sta	Area	Dist	Vol
203.16			Solid Rock excavation
220	0	25	16.2 ✓
+25	35 ✓	25	91.7 ✓
+50	163 ✓	25	213.5 ✓
+75	363 ✓	25	342.5 ✓
221	741 ✓	25	684.7 ✓
+25	980 ✓	25	1045.4 ✓
+50	1317 ✓	25	956.0 ✓
+75	1705 ✓	25	1306.9 ✓
222	1504 ✓	25	1184.7 ✓
+25	1874 ✓	25	1491.2 ✓
+50	1715 ✓	25	1432.4 ✓
+75	1788 ✓	25	1621.8 ✓
223		50	2993.5 ✓
+25	1445 ✓	50	2642.6 ✓
+75	1409 ✓	50	2550.6 ✓
224	1702 ✓	50	2863.9 ✓
+25	1687 ✓	50	2796.3 ✓
+50	1347 ✓	50	2455.2 ✓
+75	1336 ✓	50	2404.5 ✓
225	1337 ✓	50	1971.5 ✓
+25	741 ✓	50	474.1 ✓
+50	430 ✓	50	499.0 ✓
+75	135 ✓	25	265.3 ✓
226	114 ✓	25	66.9 ✓
+25	104 ✓	25	107.4 ✓
+50	172 ✓	25	132.4 ✓
+75	134 ✓	25	77.1 ✓
227	35 ✓	25	39.4 ✓
+25	50 ✓	25	37.0 ✓
+50	30 ✓	25	30.9 ✓
+75	54 ✓	25	46.3 ✓
228	40 ✓	25	21.3 ✓
+25	0 ✓	25	

Book 1 PAGE 71
 22,576.0 cu yd
 22,517.7 cu yd
 16,237 cu yd

Old
 Notes
 11-19-05

SEARSBURG - WILMINGTON
 NH-F010-1(18)
 SEARSBURG - WILMINGTON
 LEDGE
 232+00 to 233+50
 SHEET 400E OF 435