


ORIGINAL SURVEY
 SURVEY
 DATE

ORIGINAL SURVEY
 SURVEY
 DATE

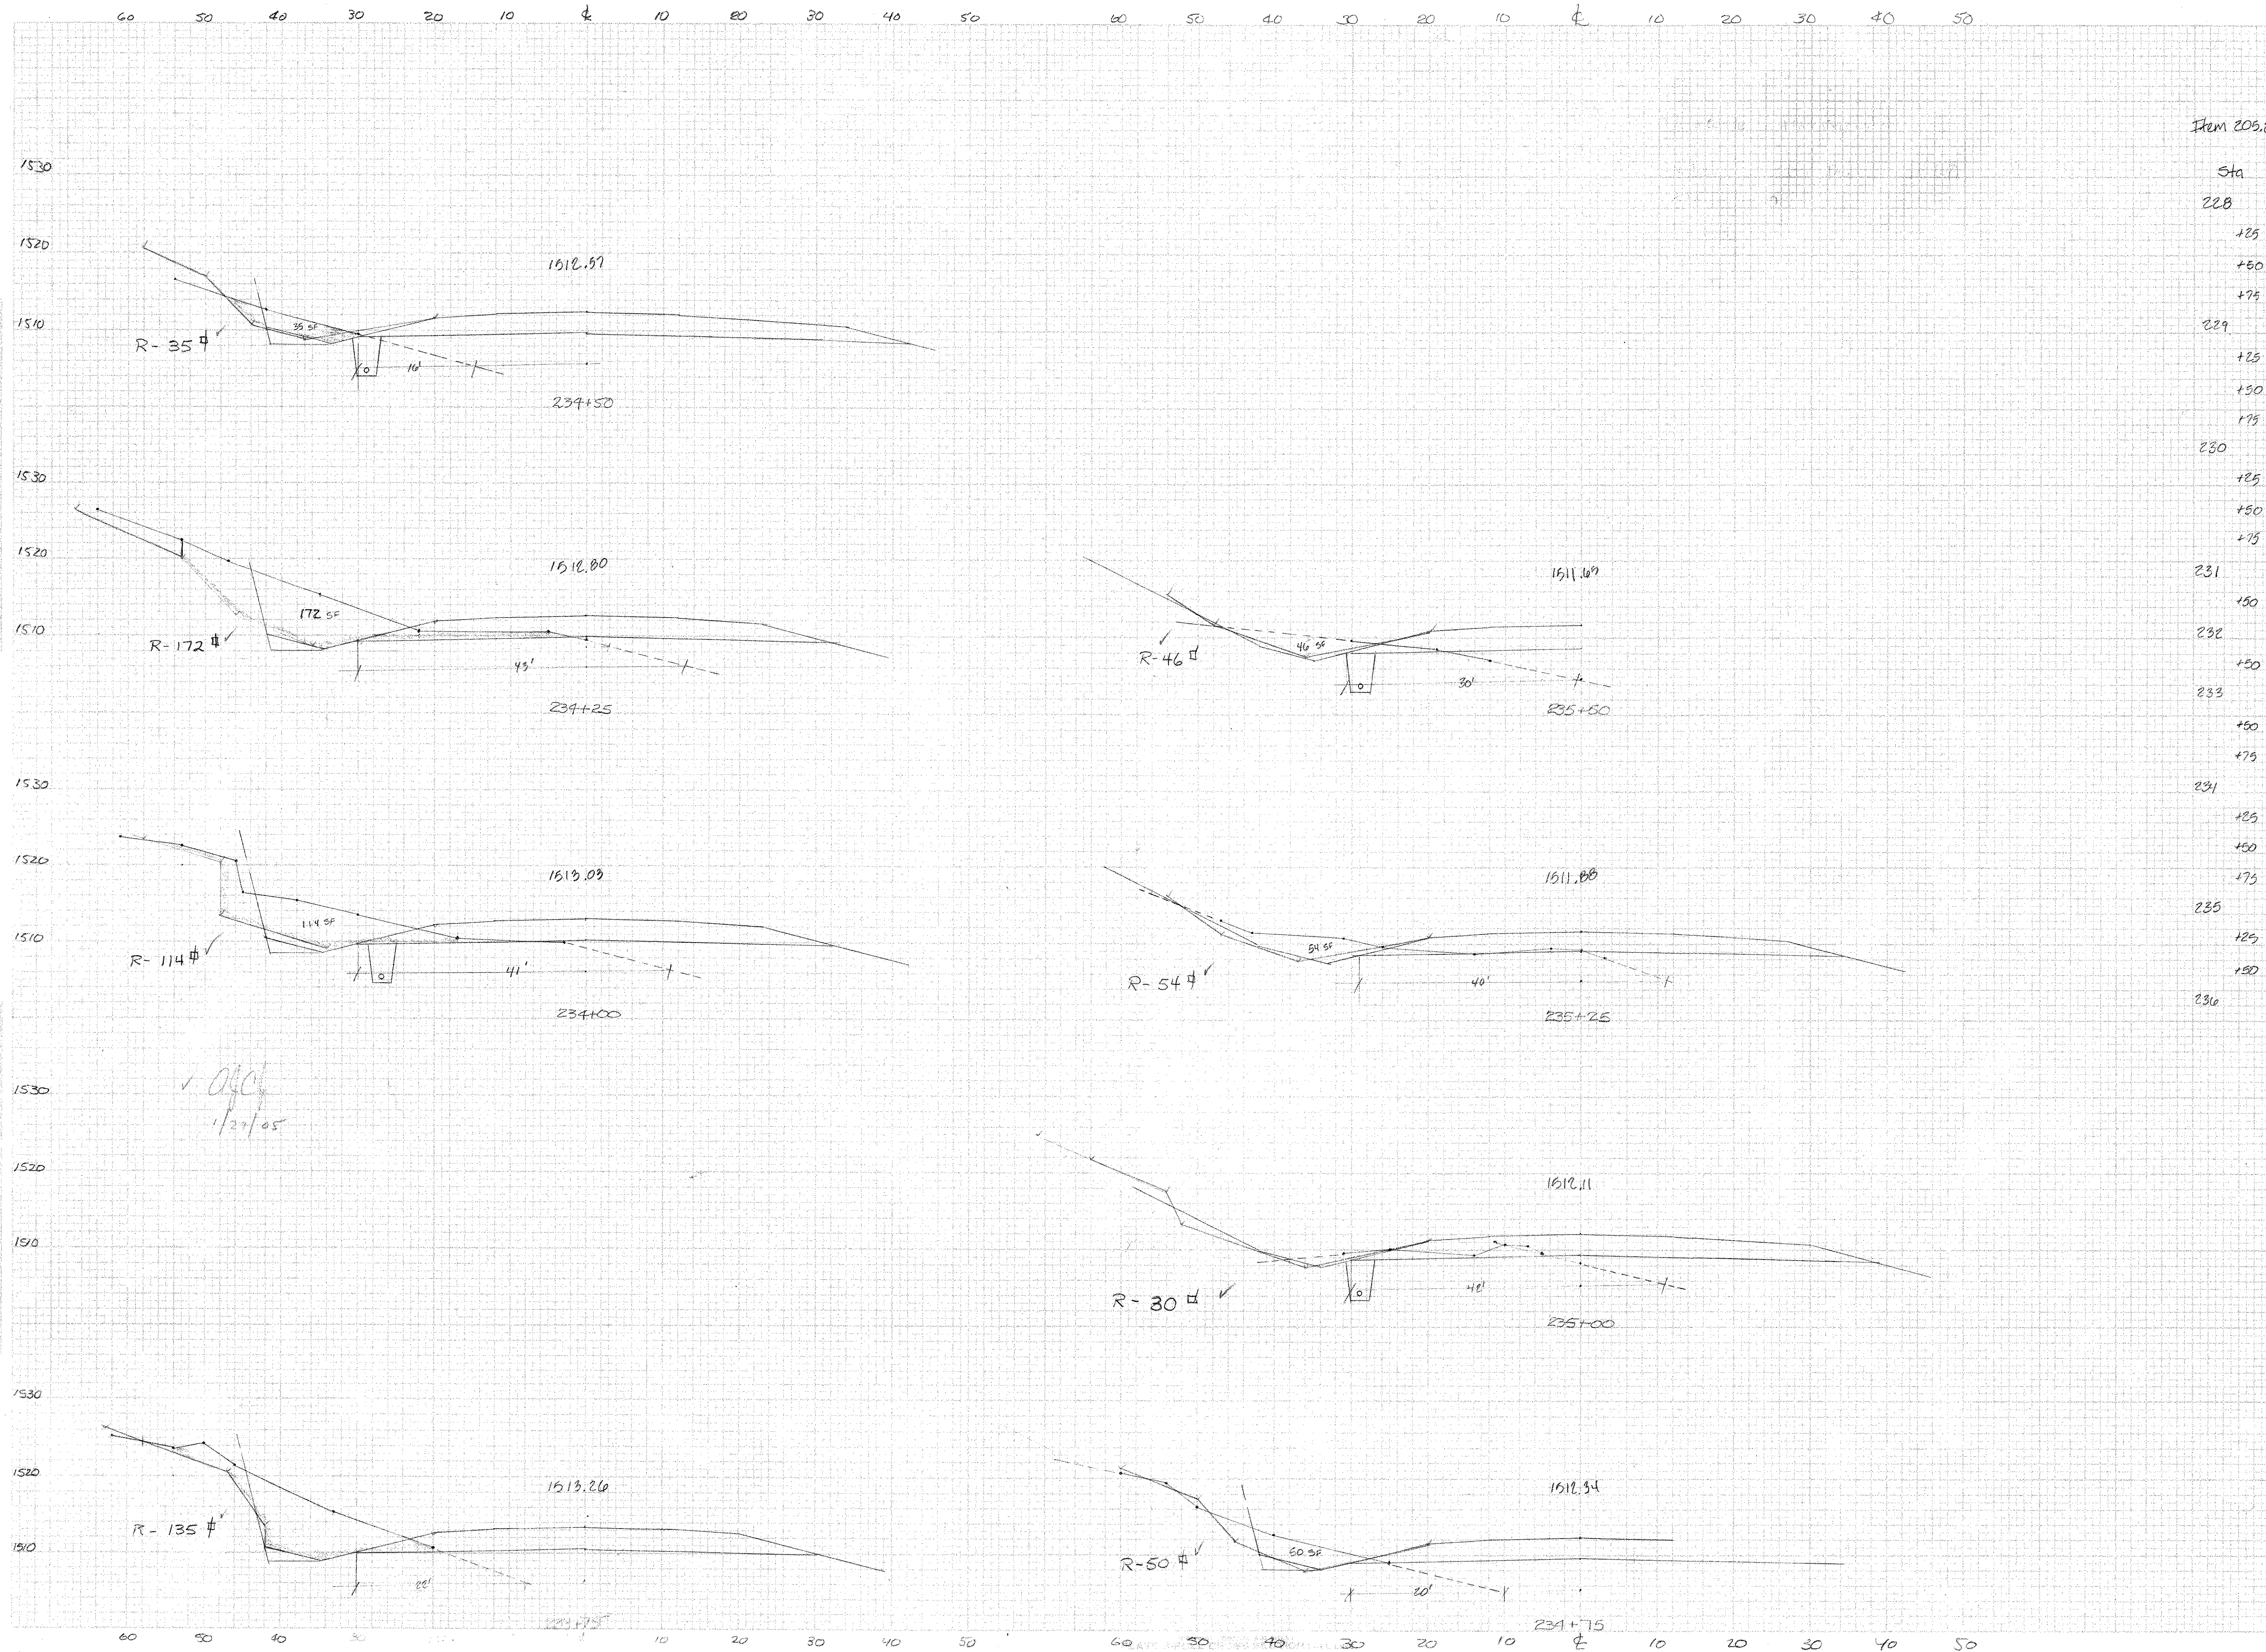

Item 205.20 Drilling & Blasting of Solid Rock subgrade

Sta	Width	Dist	Area (sq)
228	0		
+25	0	25	35 5.6 ✓
+50	4	25	22 22.2 ✓
+75	12	25	42 41.7 ✓
229	18	25	54 54.2 ✓
+25	21	25	32 31.9 ✓
+50	38	25	105 102.8 ✓
+75	56	25	145 115.3 ✓
230	47		
+25		50	267 216.7 ✓
+50	49		
+75		50	250.0
231	41	50	294 294.4 ✓
+50	69	50	328 372.2 ✓
232	69	50	371 377.8 ✓
+50	67	50	208 208.3 ✓
233	8	50	127 127.8 ✓
+50	38	25	88 85.3 ✓
+75	22	25	27 27.5 ✓
234	41	25	118 116.7 ✓
+25	43	25	27 27.5 ✓
+50	16	25	50 50.0 ✓
+75	20	25	80 86.1 ✓
235	40	25	115 113.9 ✓
+25	40	25	97 97.2 ✓
+50	80	50	89 83.3 ✓
236	0		

3144 54 1262/05
 Book 1A Page 59 3120.8 ✓
 ABC
 4/23/07
 M. H. B.
 5/10/10

SEARSBURG - WILMINGTON
 NH-F010-1(18)
 Searsburg - Wilmington
 LEDGE SECTIONS
 233+75 - 235+50
 SHEET 400F OF 435