


Supervisor V. M. J. 2/15/05
 Project V. M. J. 2/15/05

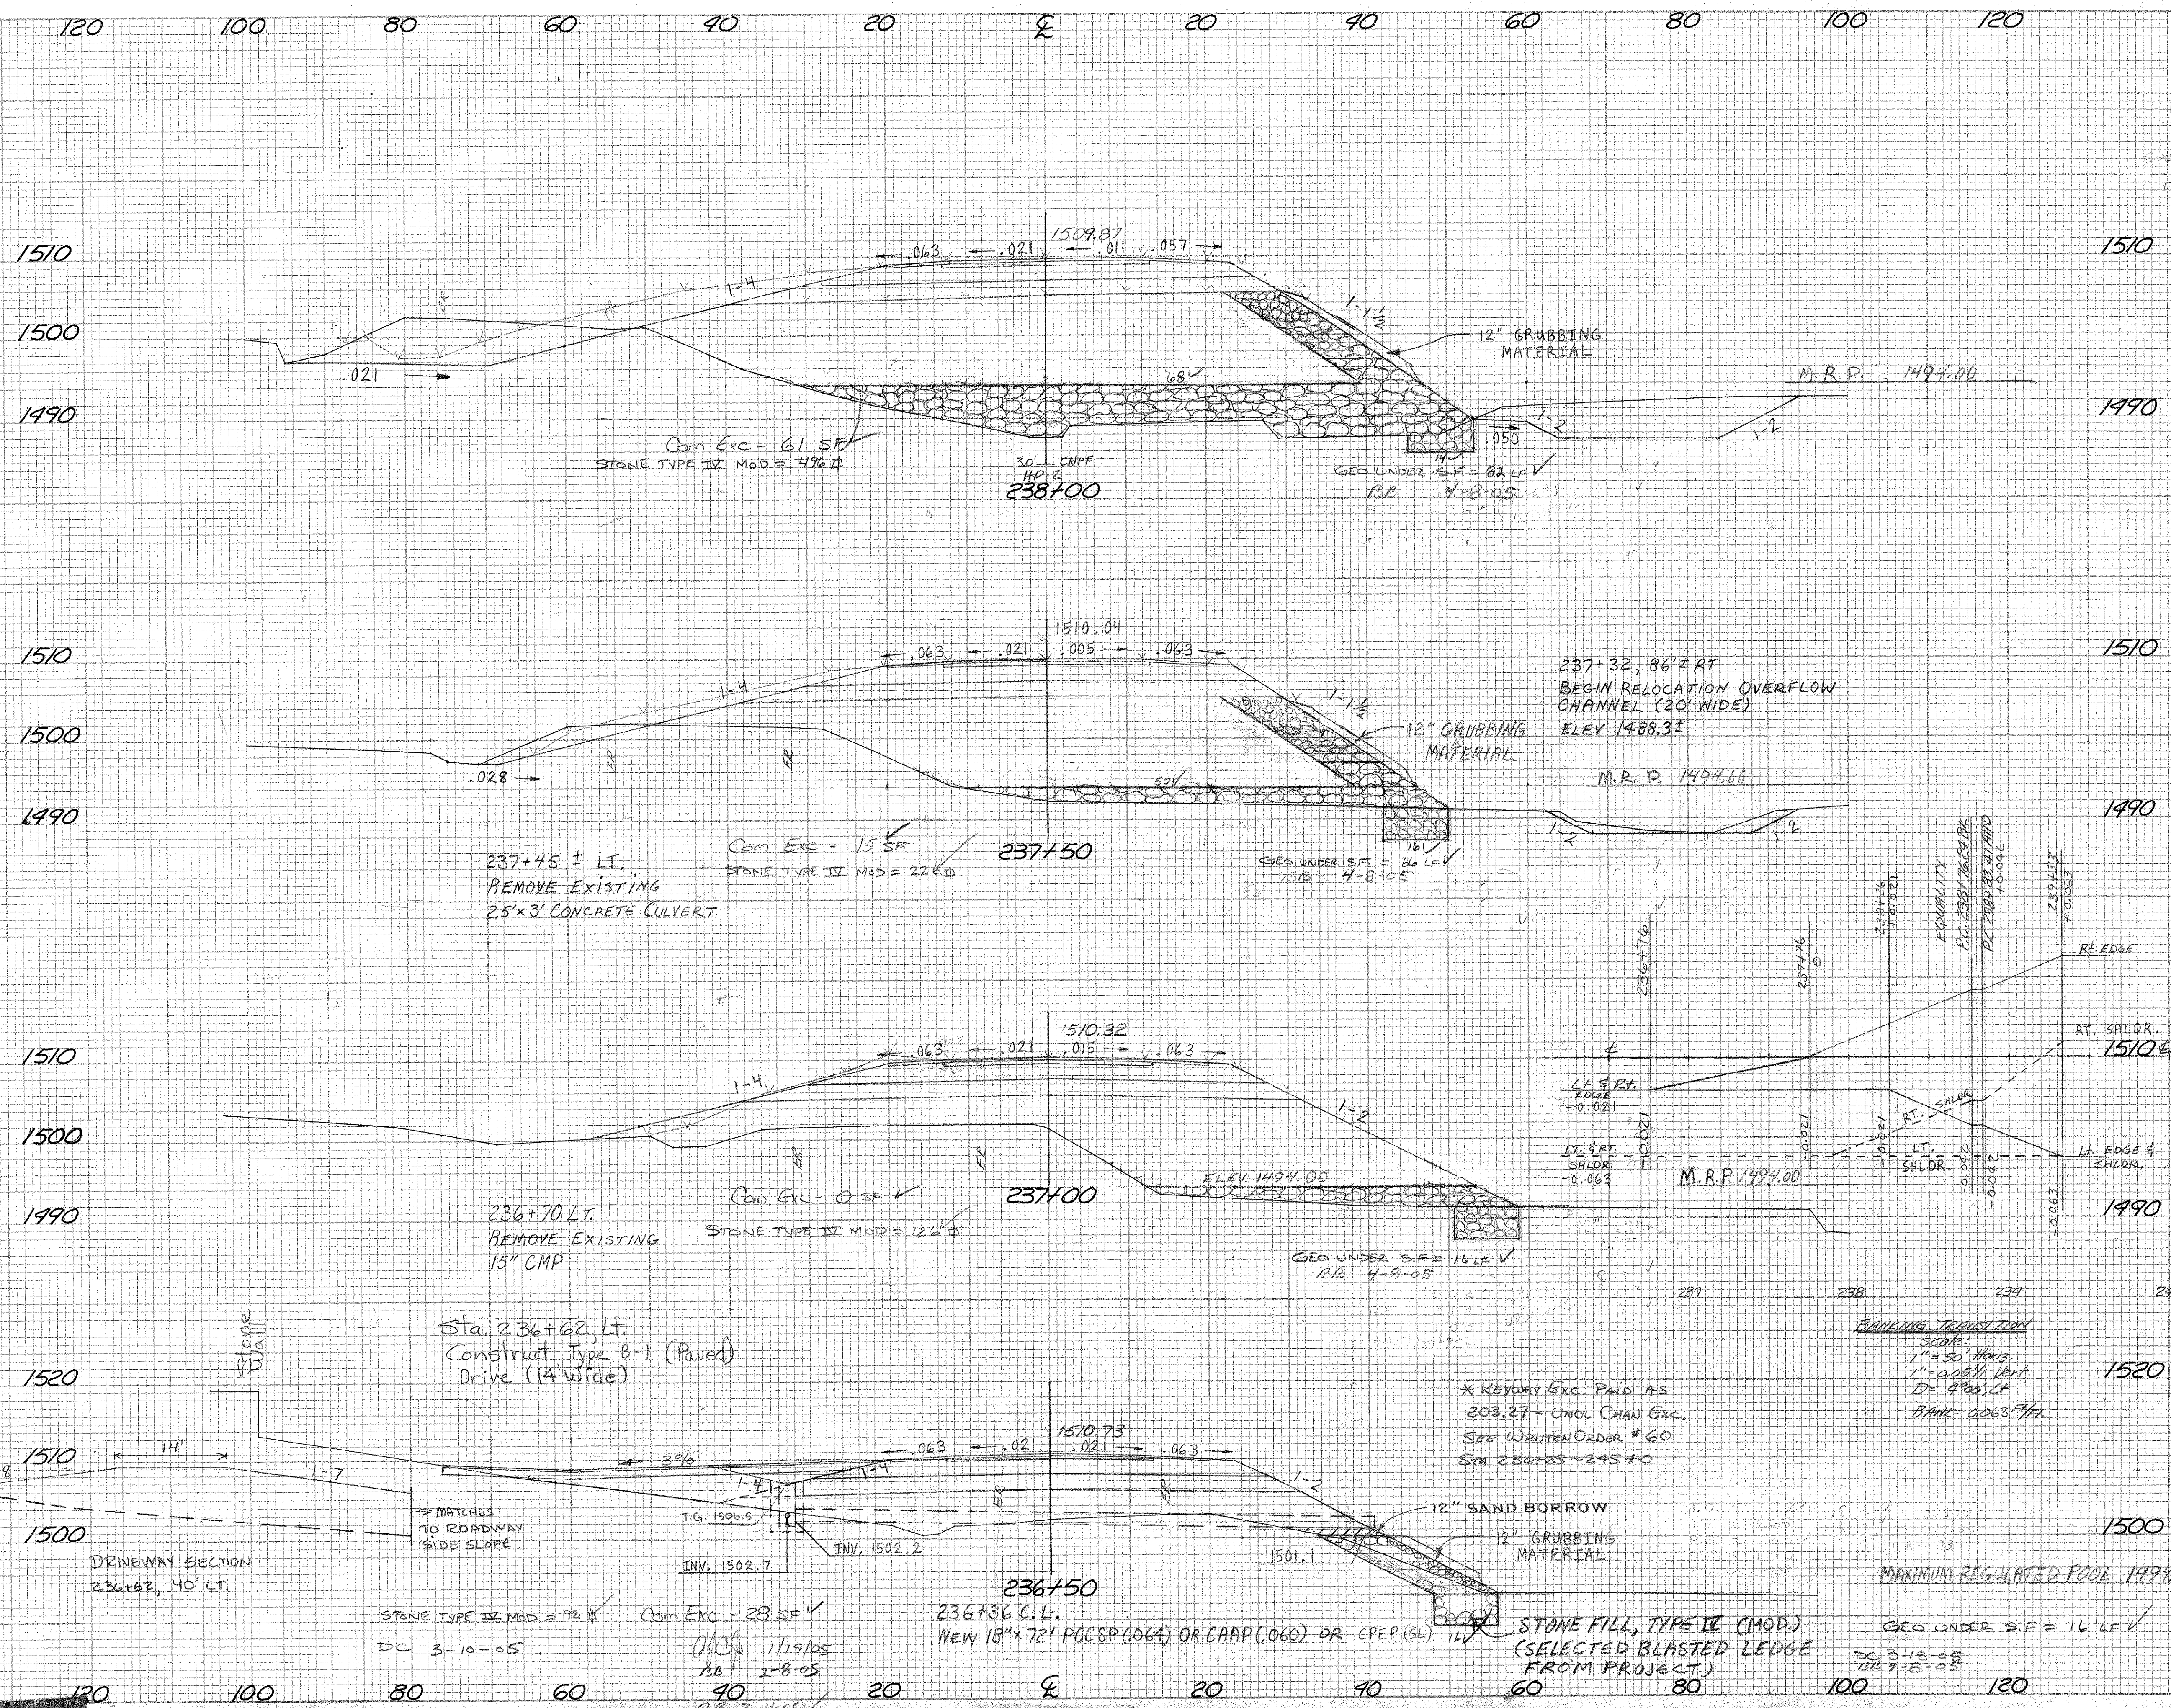

DATE	
BY	
FINAL SURVEY	
PLOTTED	
NOTE BOOK	
AREAS CHECKED	
NO.	

DATE	
BY	
ORIGINAL SURVEY	
PLOTTED	
NOTE BOOK	
AREAS CHECKED	
NO.	

* KEYWAY EXC. PAID AS
 203.27 - UNCL. CHAN. EXC.
 SEE WRITTEN ORDER # 60
 STA 236+03 - 245+10

BANKING TRANSITION
 SCALE:
 1" = 50' Horz.
 1" = 10.00' Vert.
 D = 4200' LT
 BANK = 0.063' / ft

MAXIMUM REGULATED POOL 1494.00

STONE FILL, TYPE II (MOD.)
 (SELECTED BLASTED LEDGE
 FROM PROJECT)