
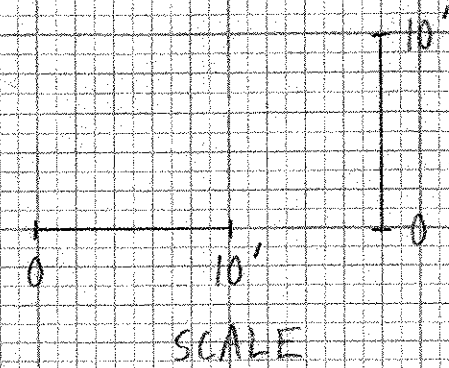


DATE	
BY	
NO.	
FINAL SURVEY	
SURVEYED	
PLOTTED	
TEMPLATE	
AREAS CHECKED	
NO.	

DATE	
BY	
NO.	
ORIGINAL SURVEY	
SURVEYED	
PLOTTED	
TEMPLATE	
AREAS CHECKED	
NO.	

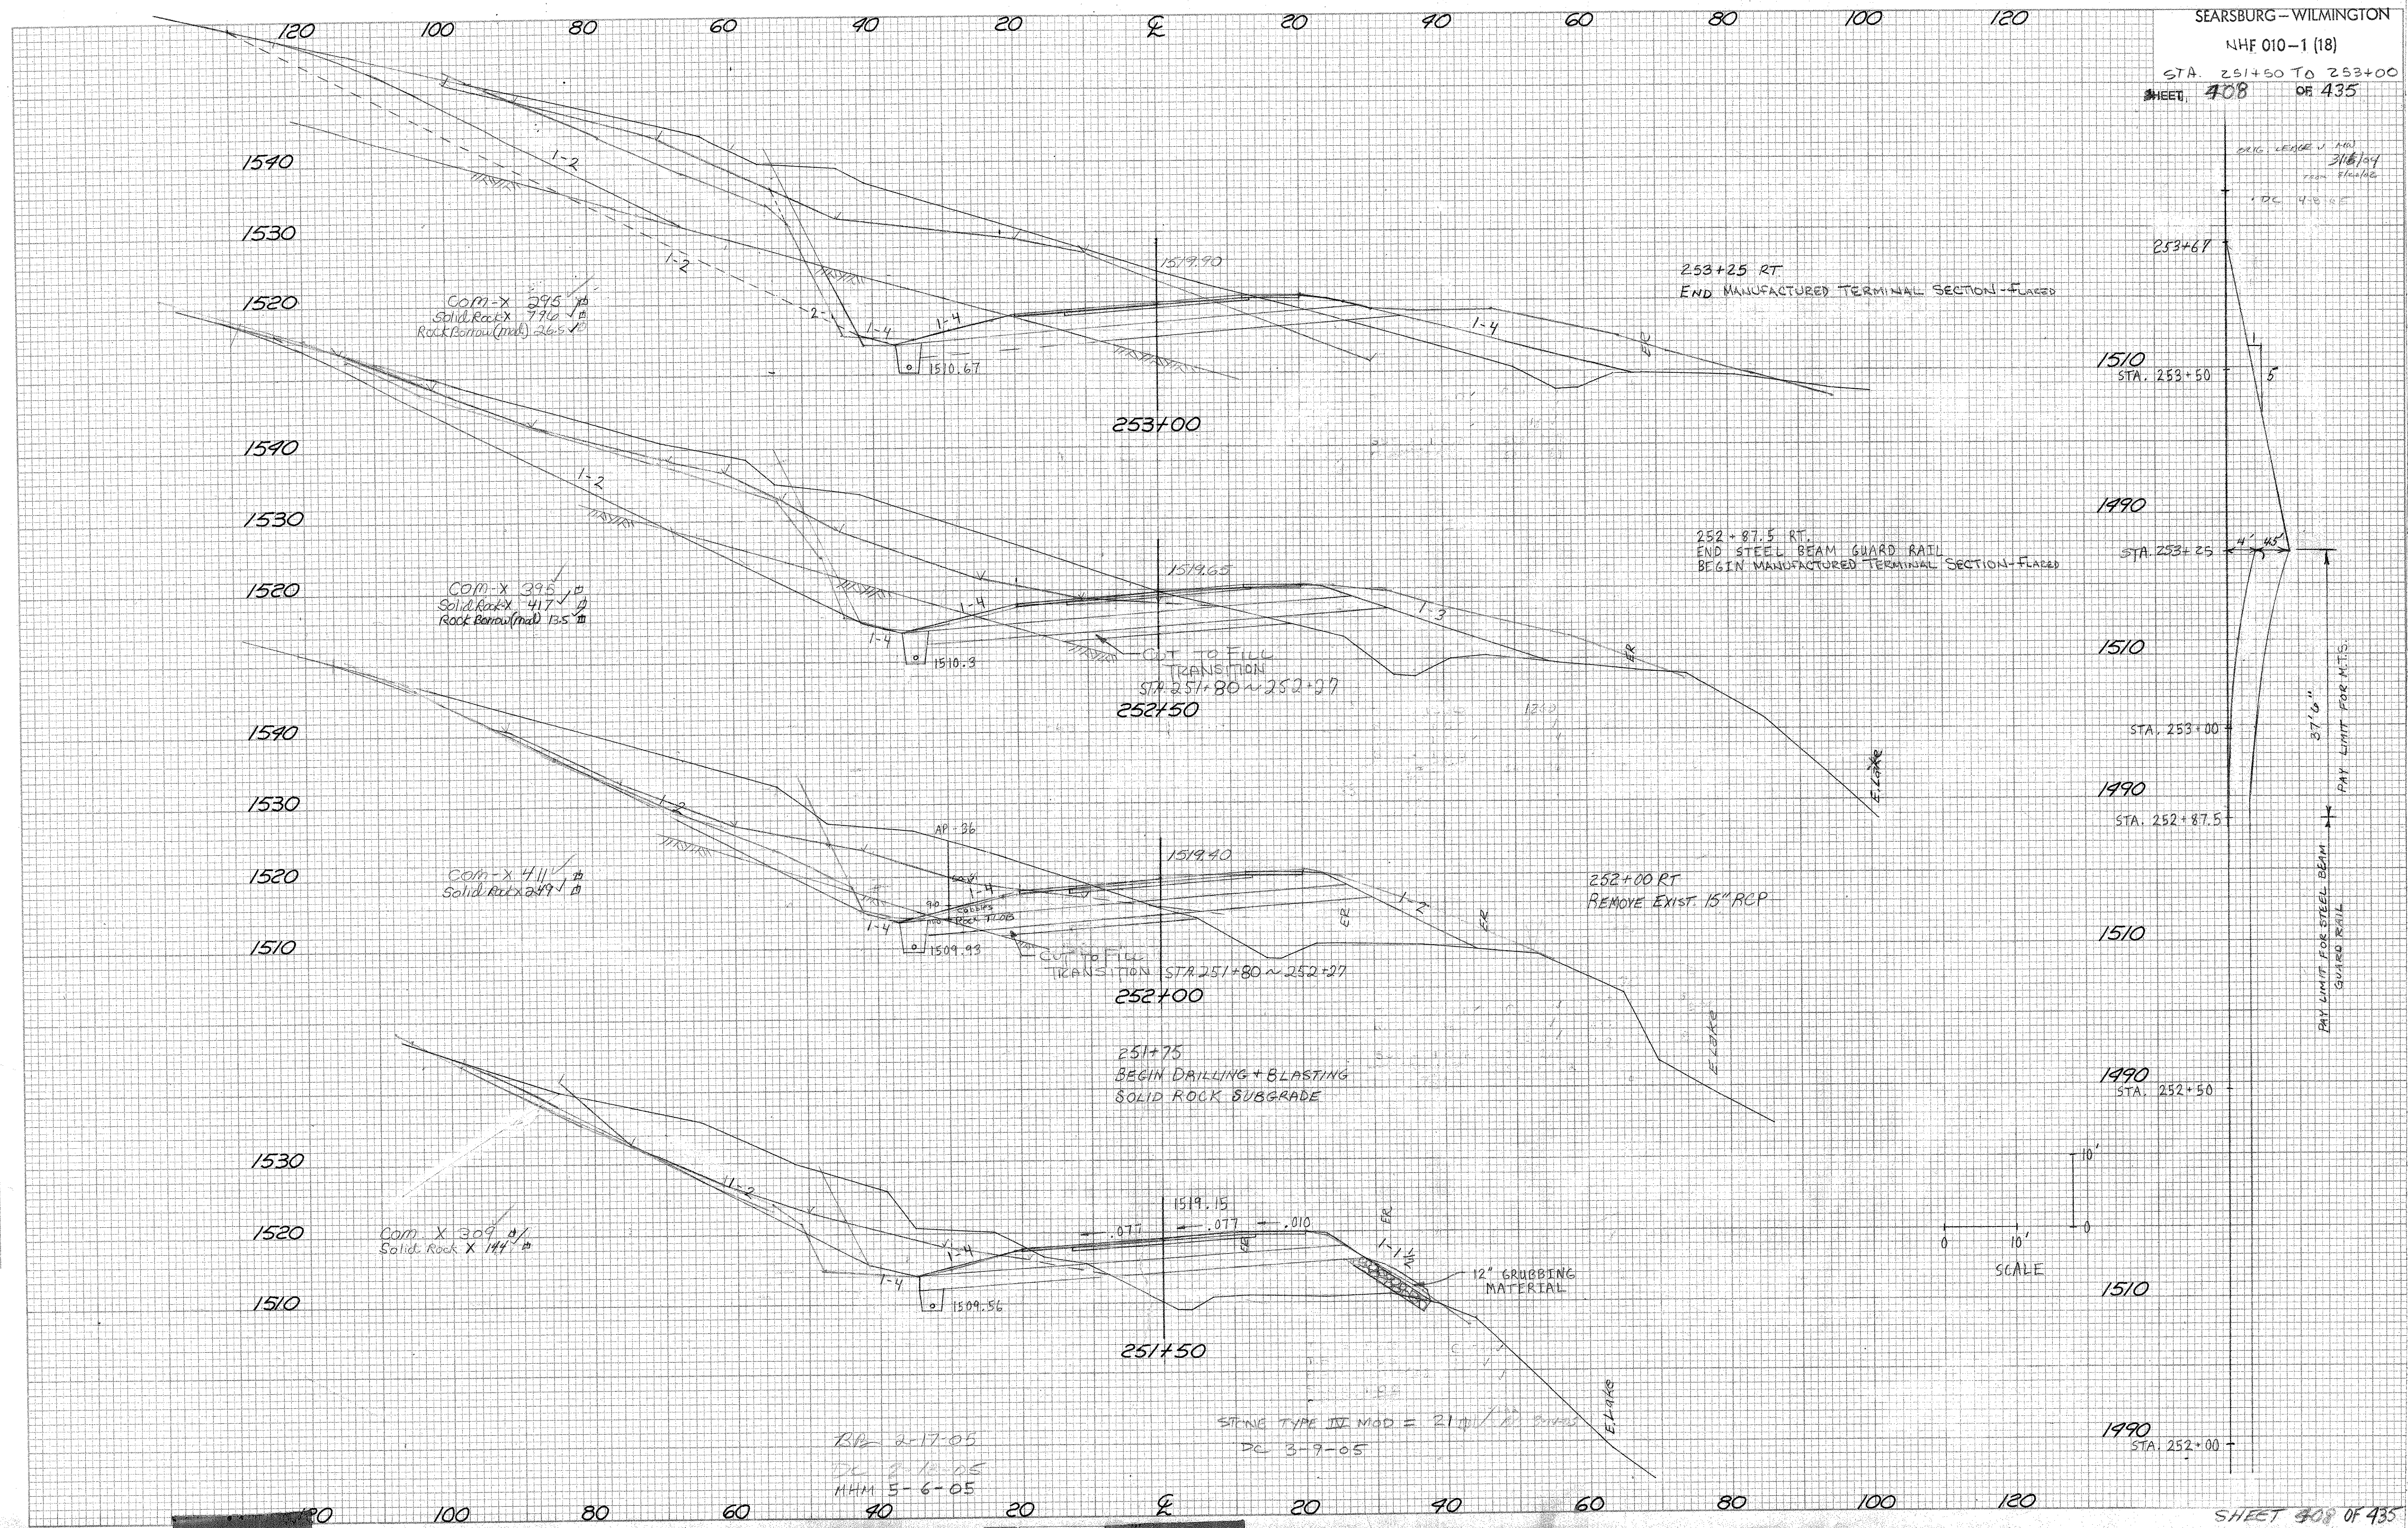

RIP 2-17-05
 DL 8-12-05
 MHM 5-6-05

STRING TYPE III MOD E 21 1/2" x 11" 20' SPACED
 DC 3-9-05