


2/16/05

DATE	
BY	
FINAL SURVEY	
SURVEYED	
PLOTTED	
AREAS CHECKED	
NO.	

DATE	
BY	
ORIGINAL SURVEY	
SURVEYED	
PLOTTED	
AREAS CHECKED	
NO.	

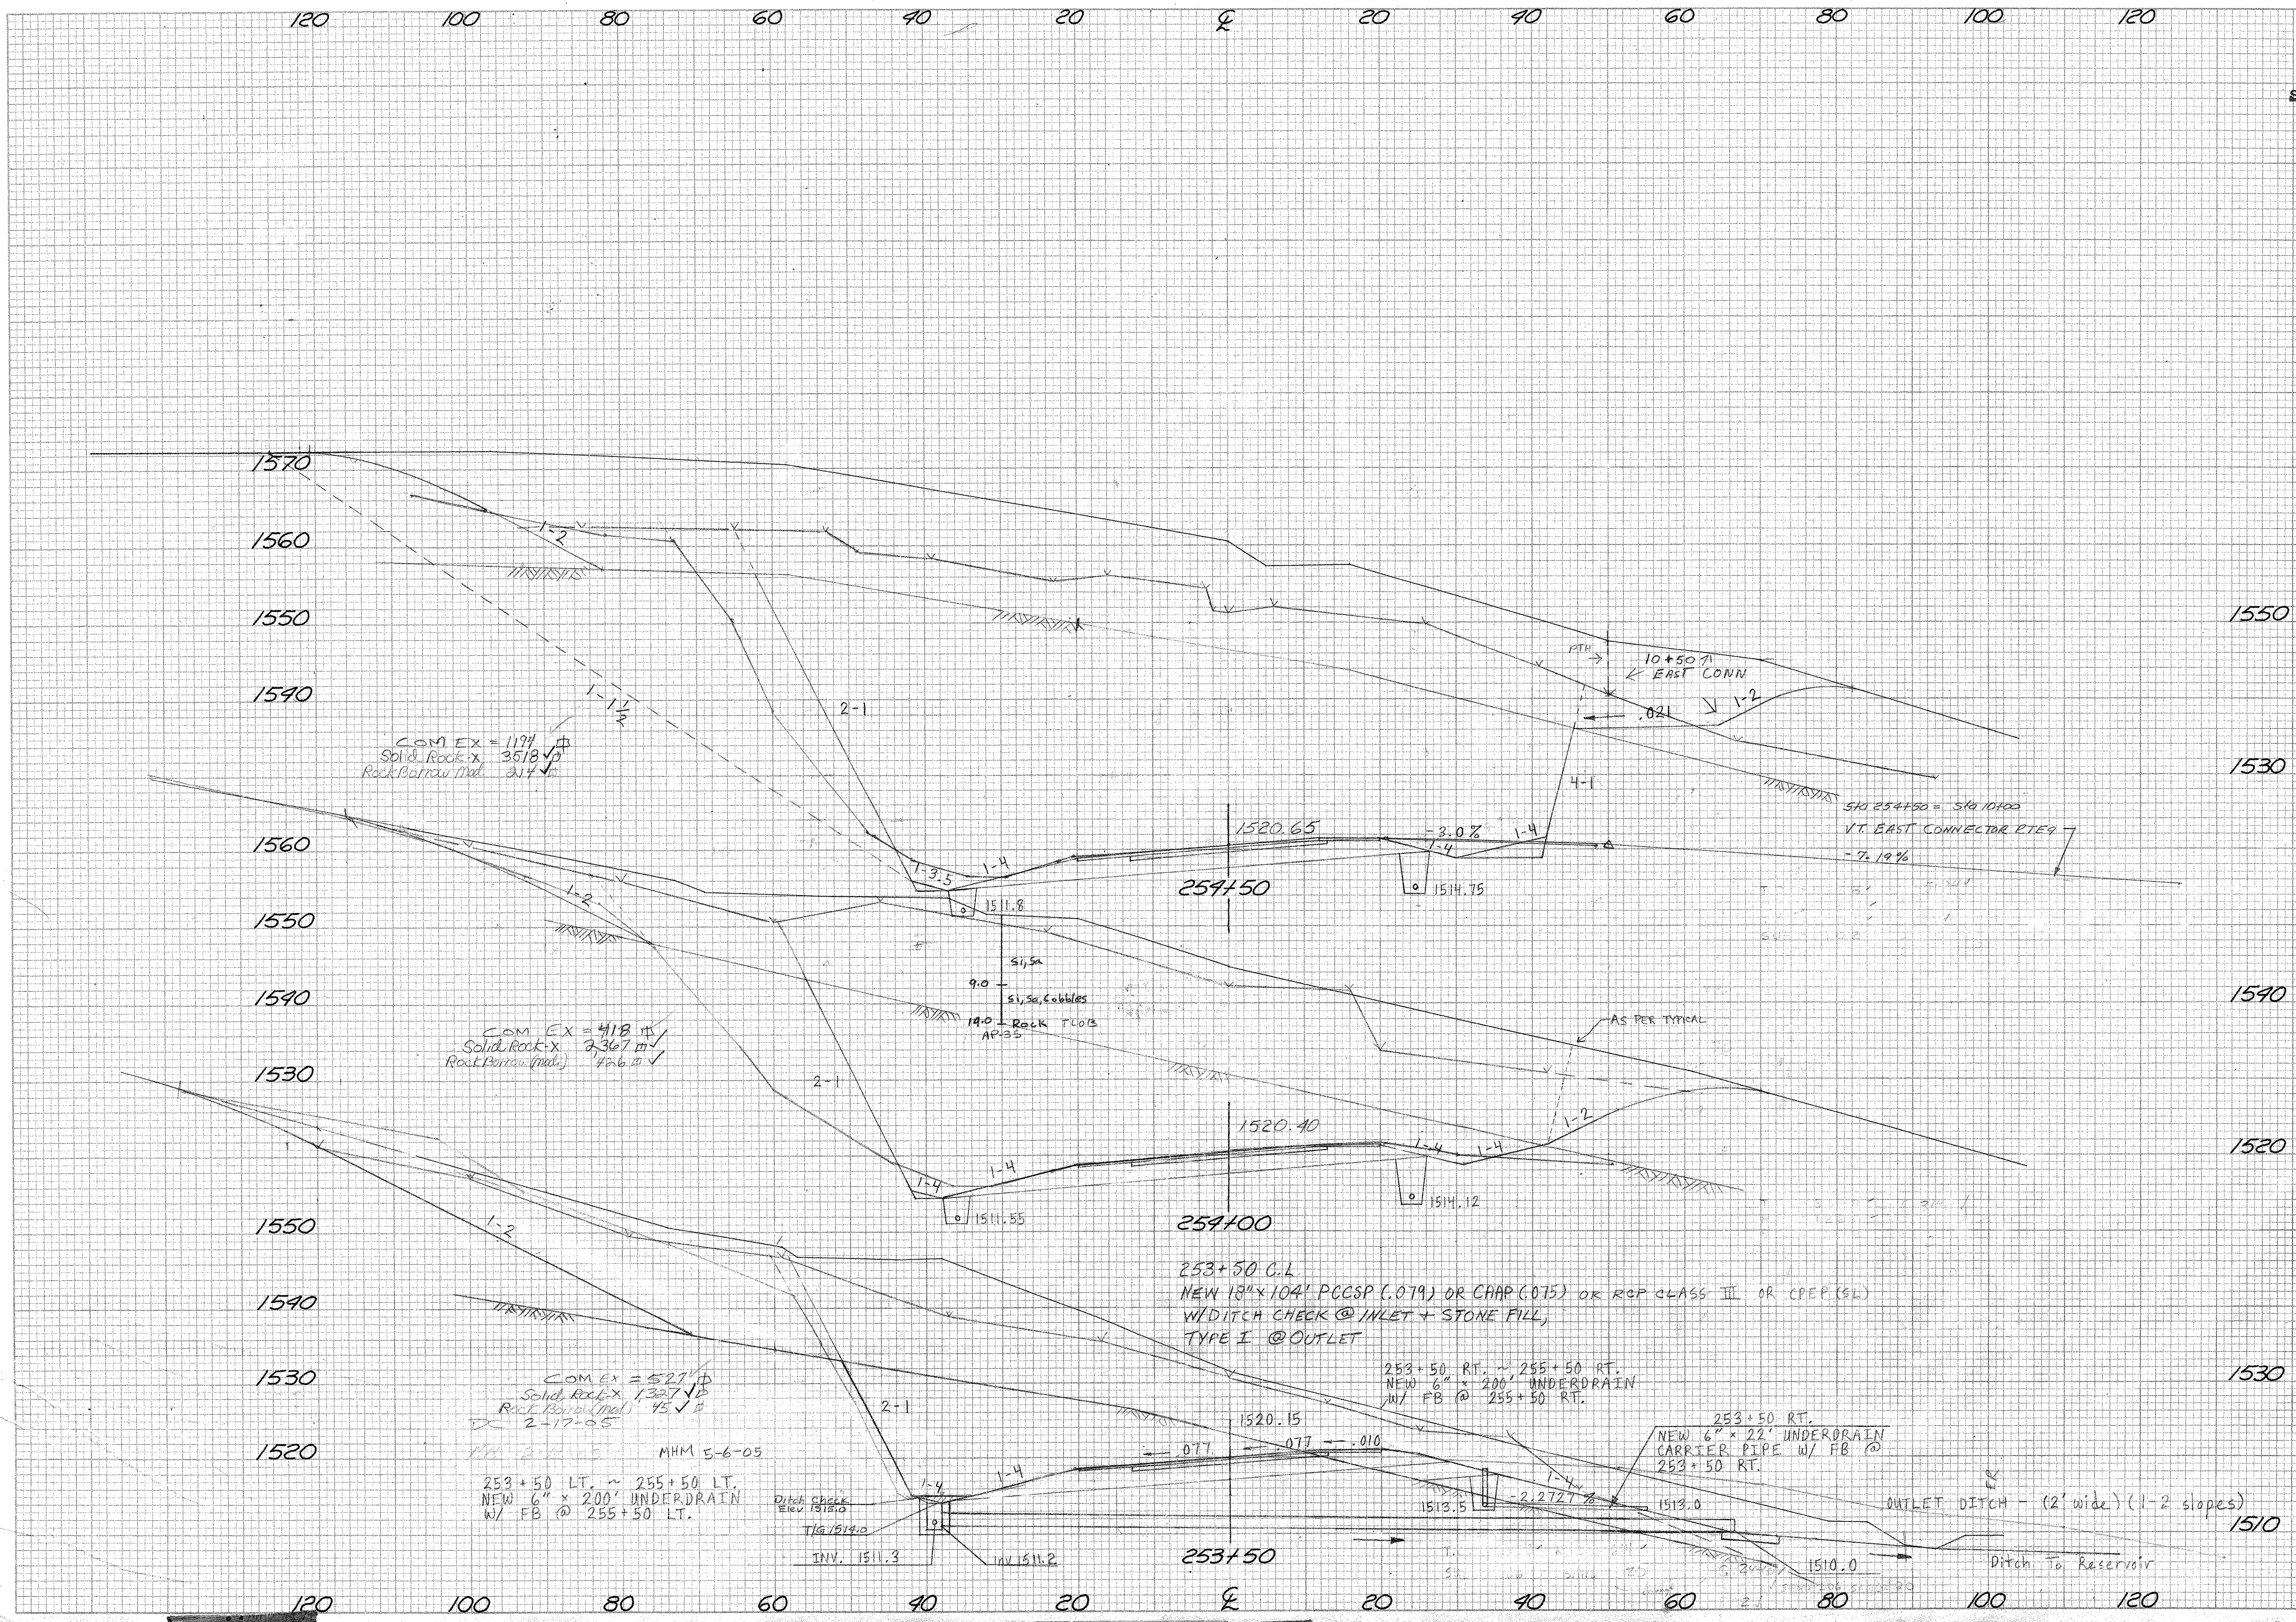

COM EX = 1174
 Solid Rock x 3518 y
 Rock Borrow Med. 214

COM EX = 418
 Solid Rock x 2367 y
 Rock Borrow (med) 456 m

COM EX = 527
 Solid Rock x 1327 y
 Rock Borrow (med) 45 y
 2-17-05

253+50 LT. ~ 255+50 LT.
 NEW 6" x 200' UNDERDRAIN
 W/ FB @ 255+50 LT.

253+50 C.L.
 NEW 18" x 104' PCCSP (.079) OR CAAP (.075) OR RSP CLASS III OR CPEP (SL)
 W/ DITCH CHECK @ INLET + STONE FILL,
 TYPE I @ OUTLET

253+50 RT. ~ 255+50 RT.
 NEW 6" x 200' UNDERDRAIN
 W/ FB @ 255+50 RT.

253+50 RT.
 NEW 6" x 22' UNDERDRAIN
 CARRIER PIPE W/ FB @
 253+50 RT.

OUTLET DITCH - (2' wide) (1-2 slopes)

Ditch To Reservoir