


EQUALITY: $269+39.89 \text{ BK.} = 270+85.60 \text{ AHD.} = -145.71' \text{ EQ.}$

DATE	
BY	
ORIGINAL SURVEY	
PLOTTED	
NOTE BOOK	
AREAS CHECKED	

DATE	
BY	
ORIGINAL SURVEY	
PLOTTED	
NOTE BOOK	
AREAS CHECKED	

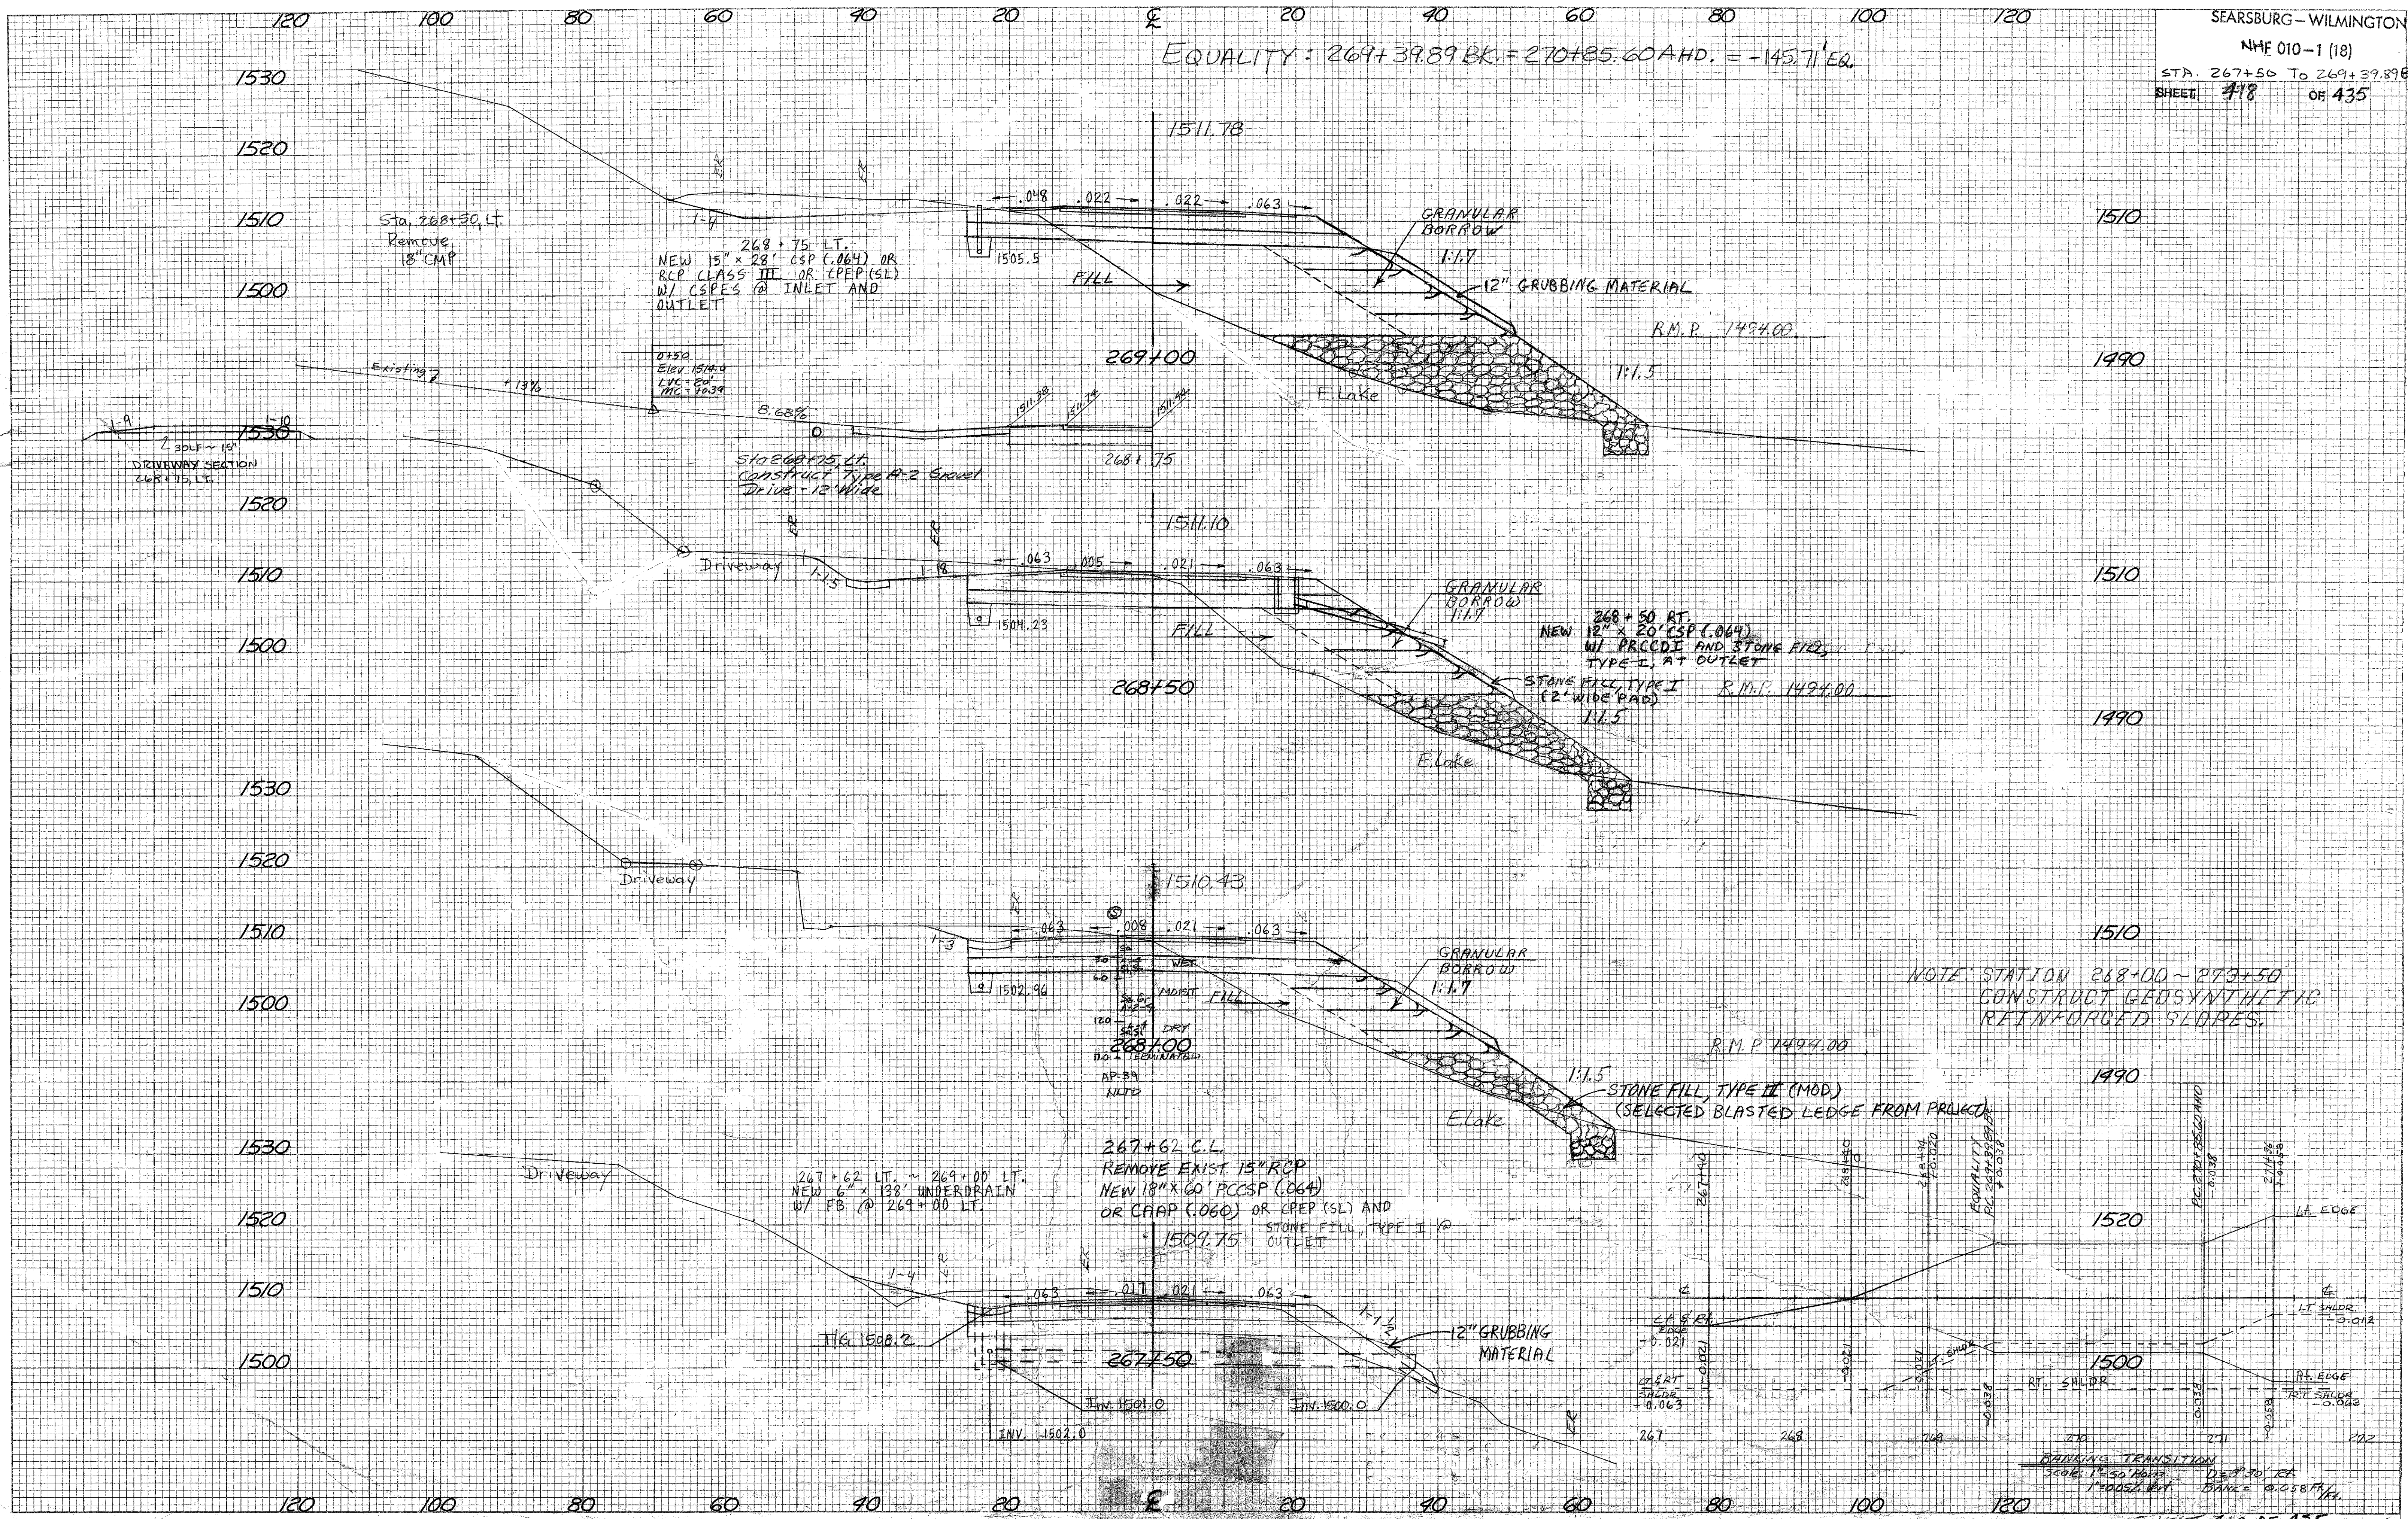

NOTE STATION 268+00 ~ 273+50
 CONSTRUCT GEOSYNTHETIC
 REINFORCED SLOPES.

TRANSITION
 SCALE: 1"=50.00 FT.
 1"=100.00 FT.
 D=3'30" RA
 BANK= 0.0587 H/F