


NOTE:
 MAINTAIN EXISTING
 PARKING AREA
 IN FRONT OF
 GARAGE
 STA. 271+40 LT.
 CONSTRUCT TYPE A1 GRAVEL
 DRIVE - 20' WIDE

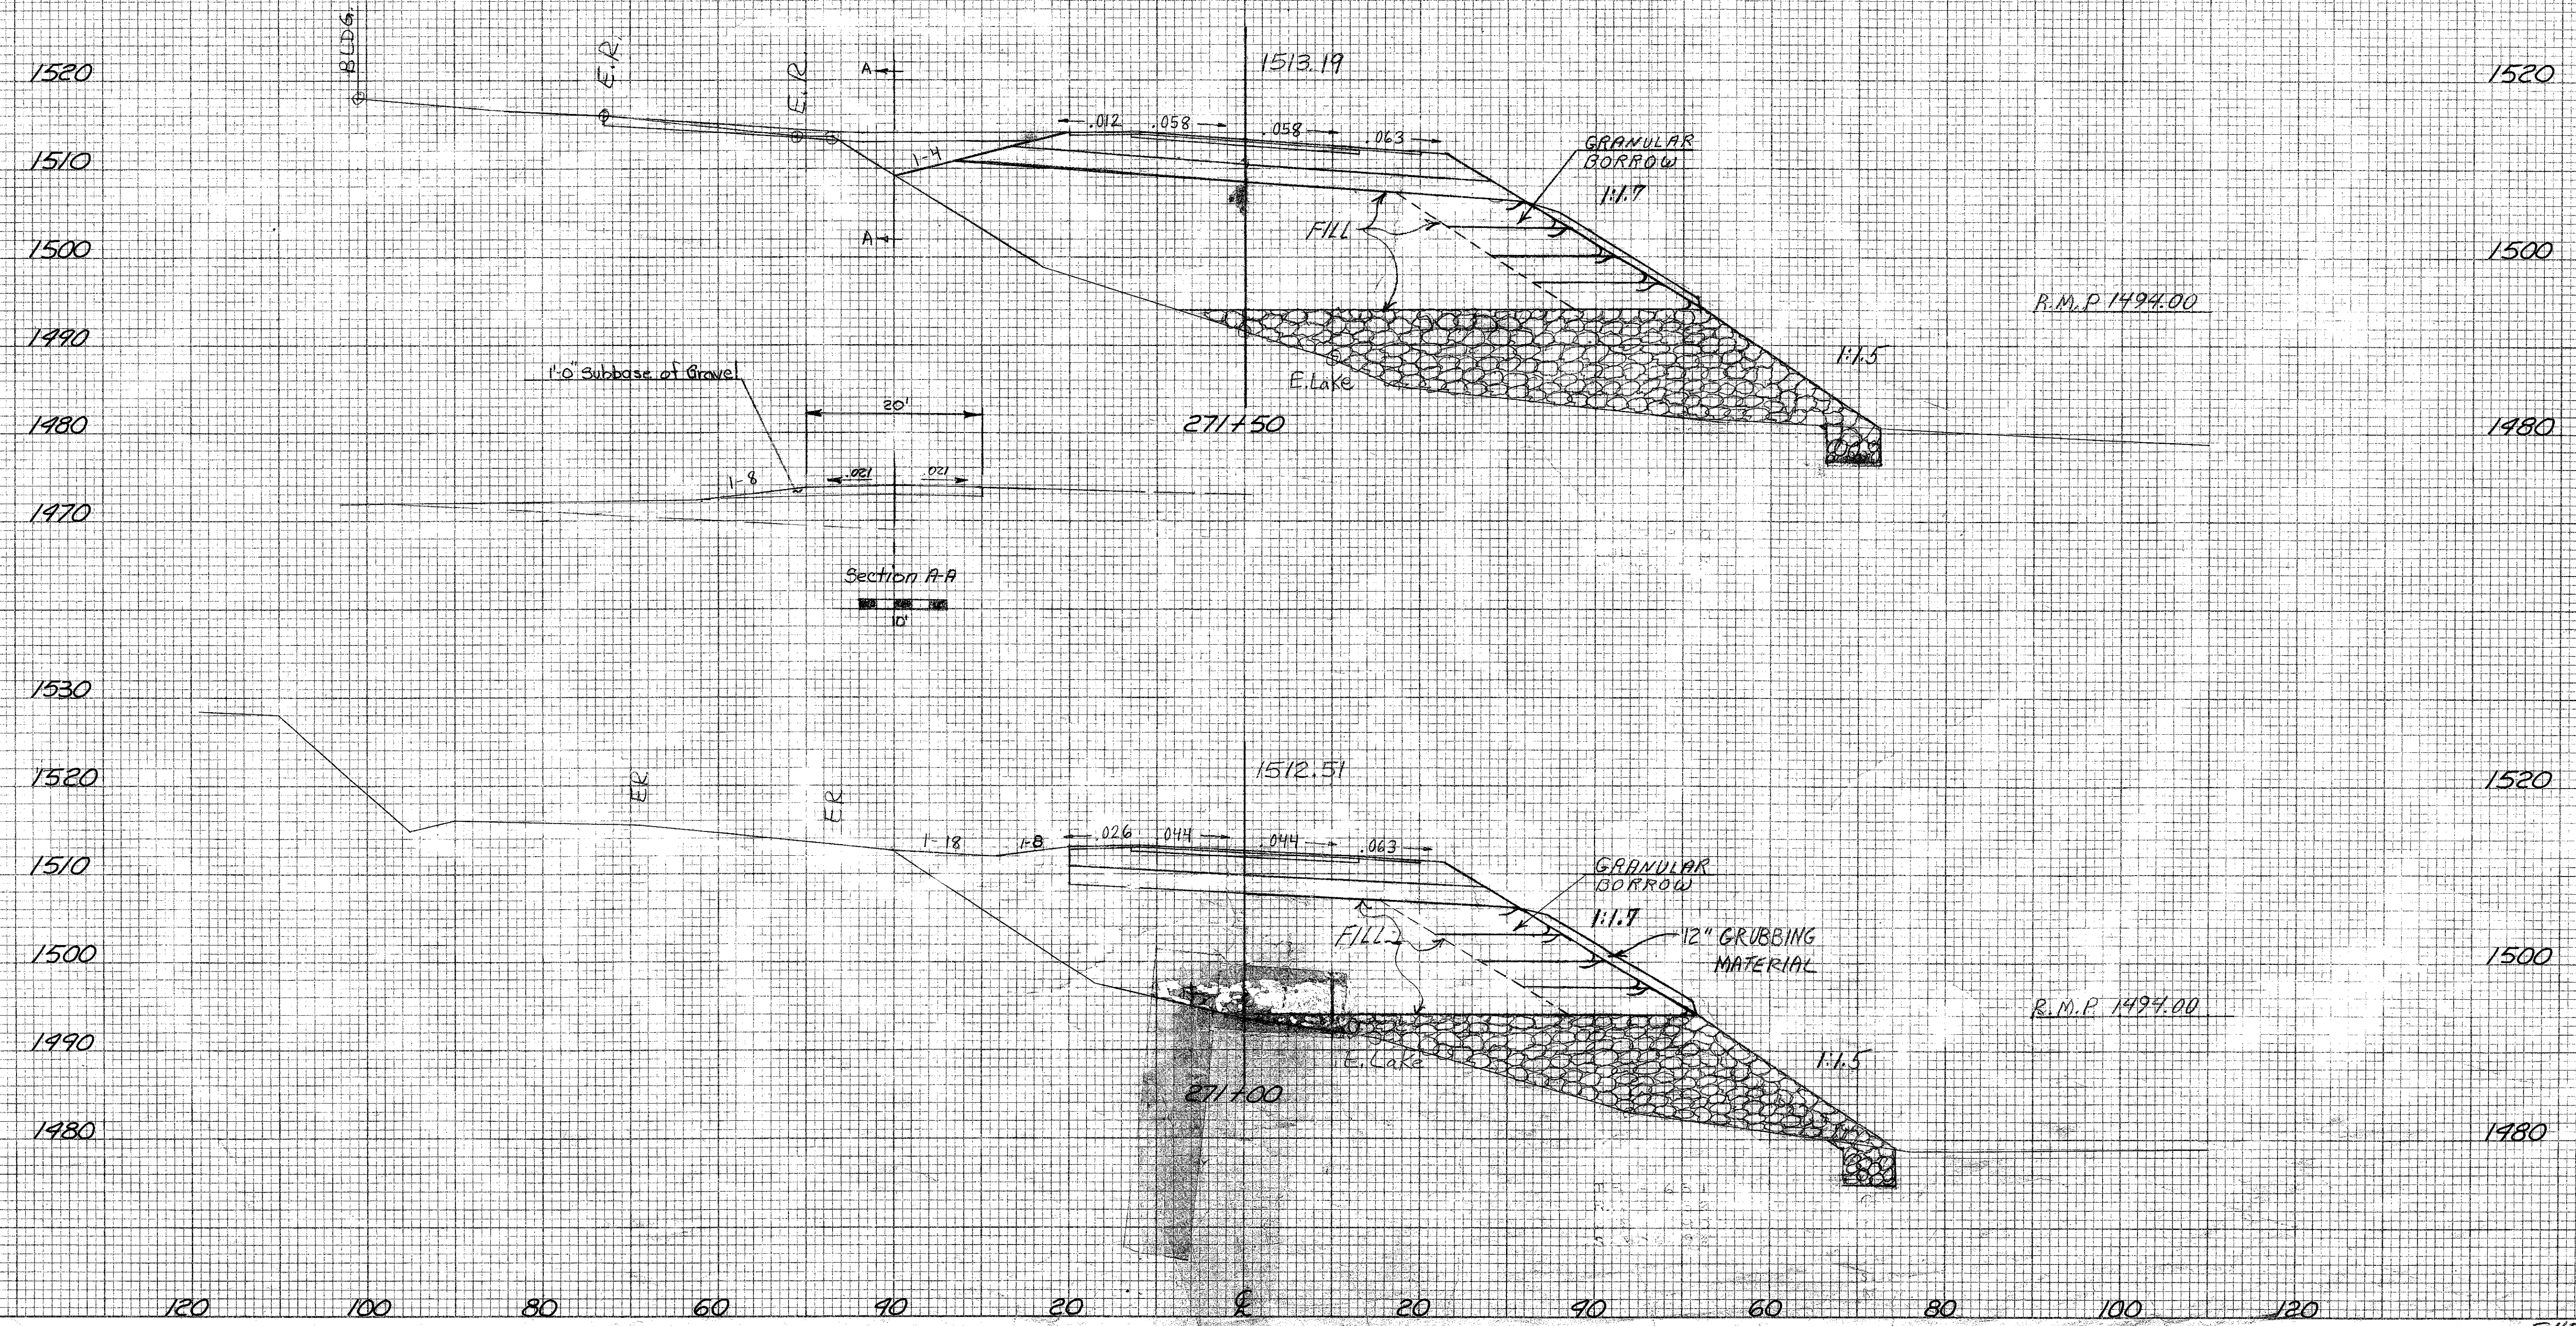

DATE	
BY	
NO.	
ORIGINAL SURVEY	
SURVEYED	
FLOTTED	
TEMPLATE	
NOTE BOOK	
AREAS CHECKED	

DATE	
BY	
NO.	
ORIGINAL SURVEY	
SURVEYED	
FLOTTED	
TEMPLATE	
NOTE BOOK	
AREAS CHECKED	