


DATE	
BY	
REVISIONS	
NO.	
DESCRIPTION	
DATE	
BY	
NO.	
DESCRIPTION	
DATE	
BY	
NO.	
DESCRIPTION	

DATE	
BY	
REVISIONS	
NO.	
DESCRIPTION	
DATE	
BY	
NO.	
DESCRIPTION	
DATE	
BY	
NO.	
DESCRIPTION	

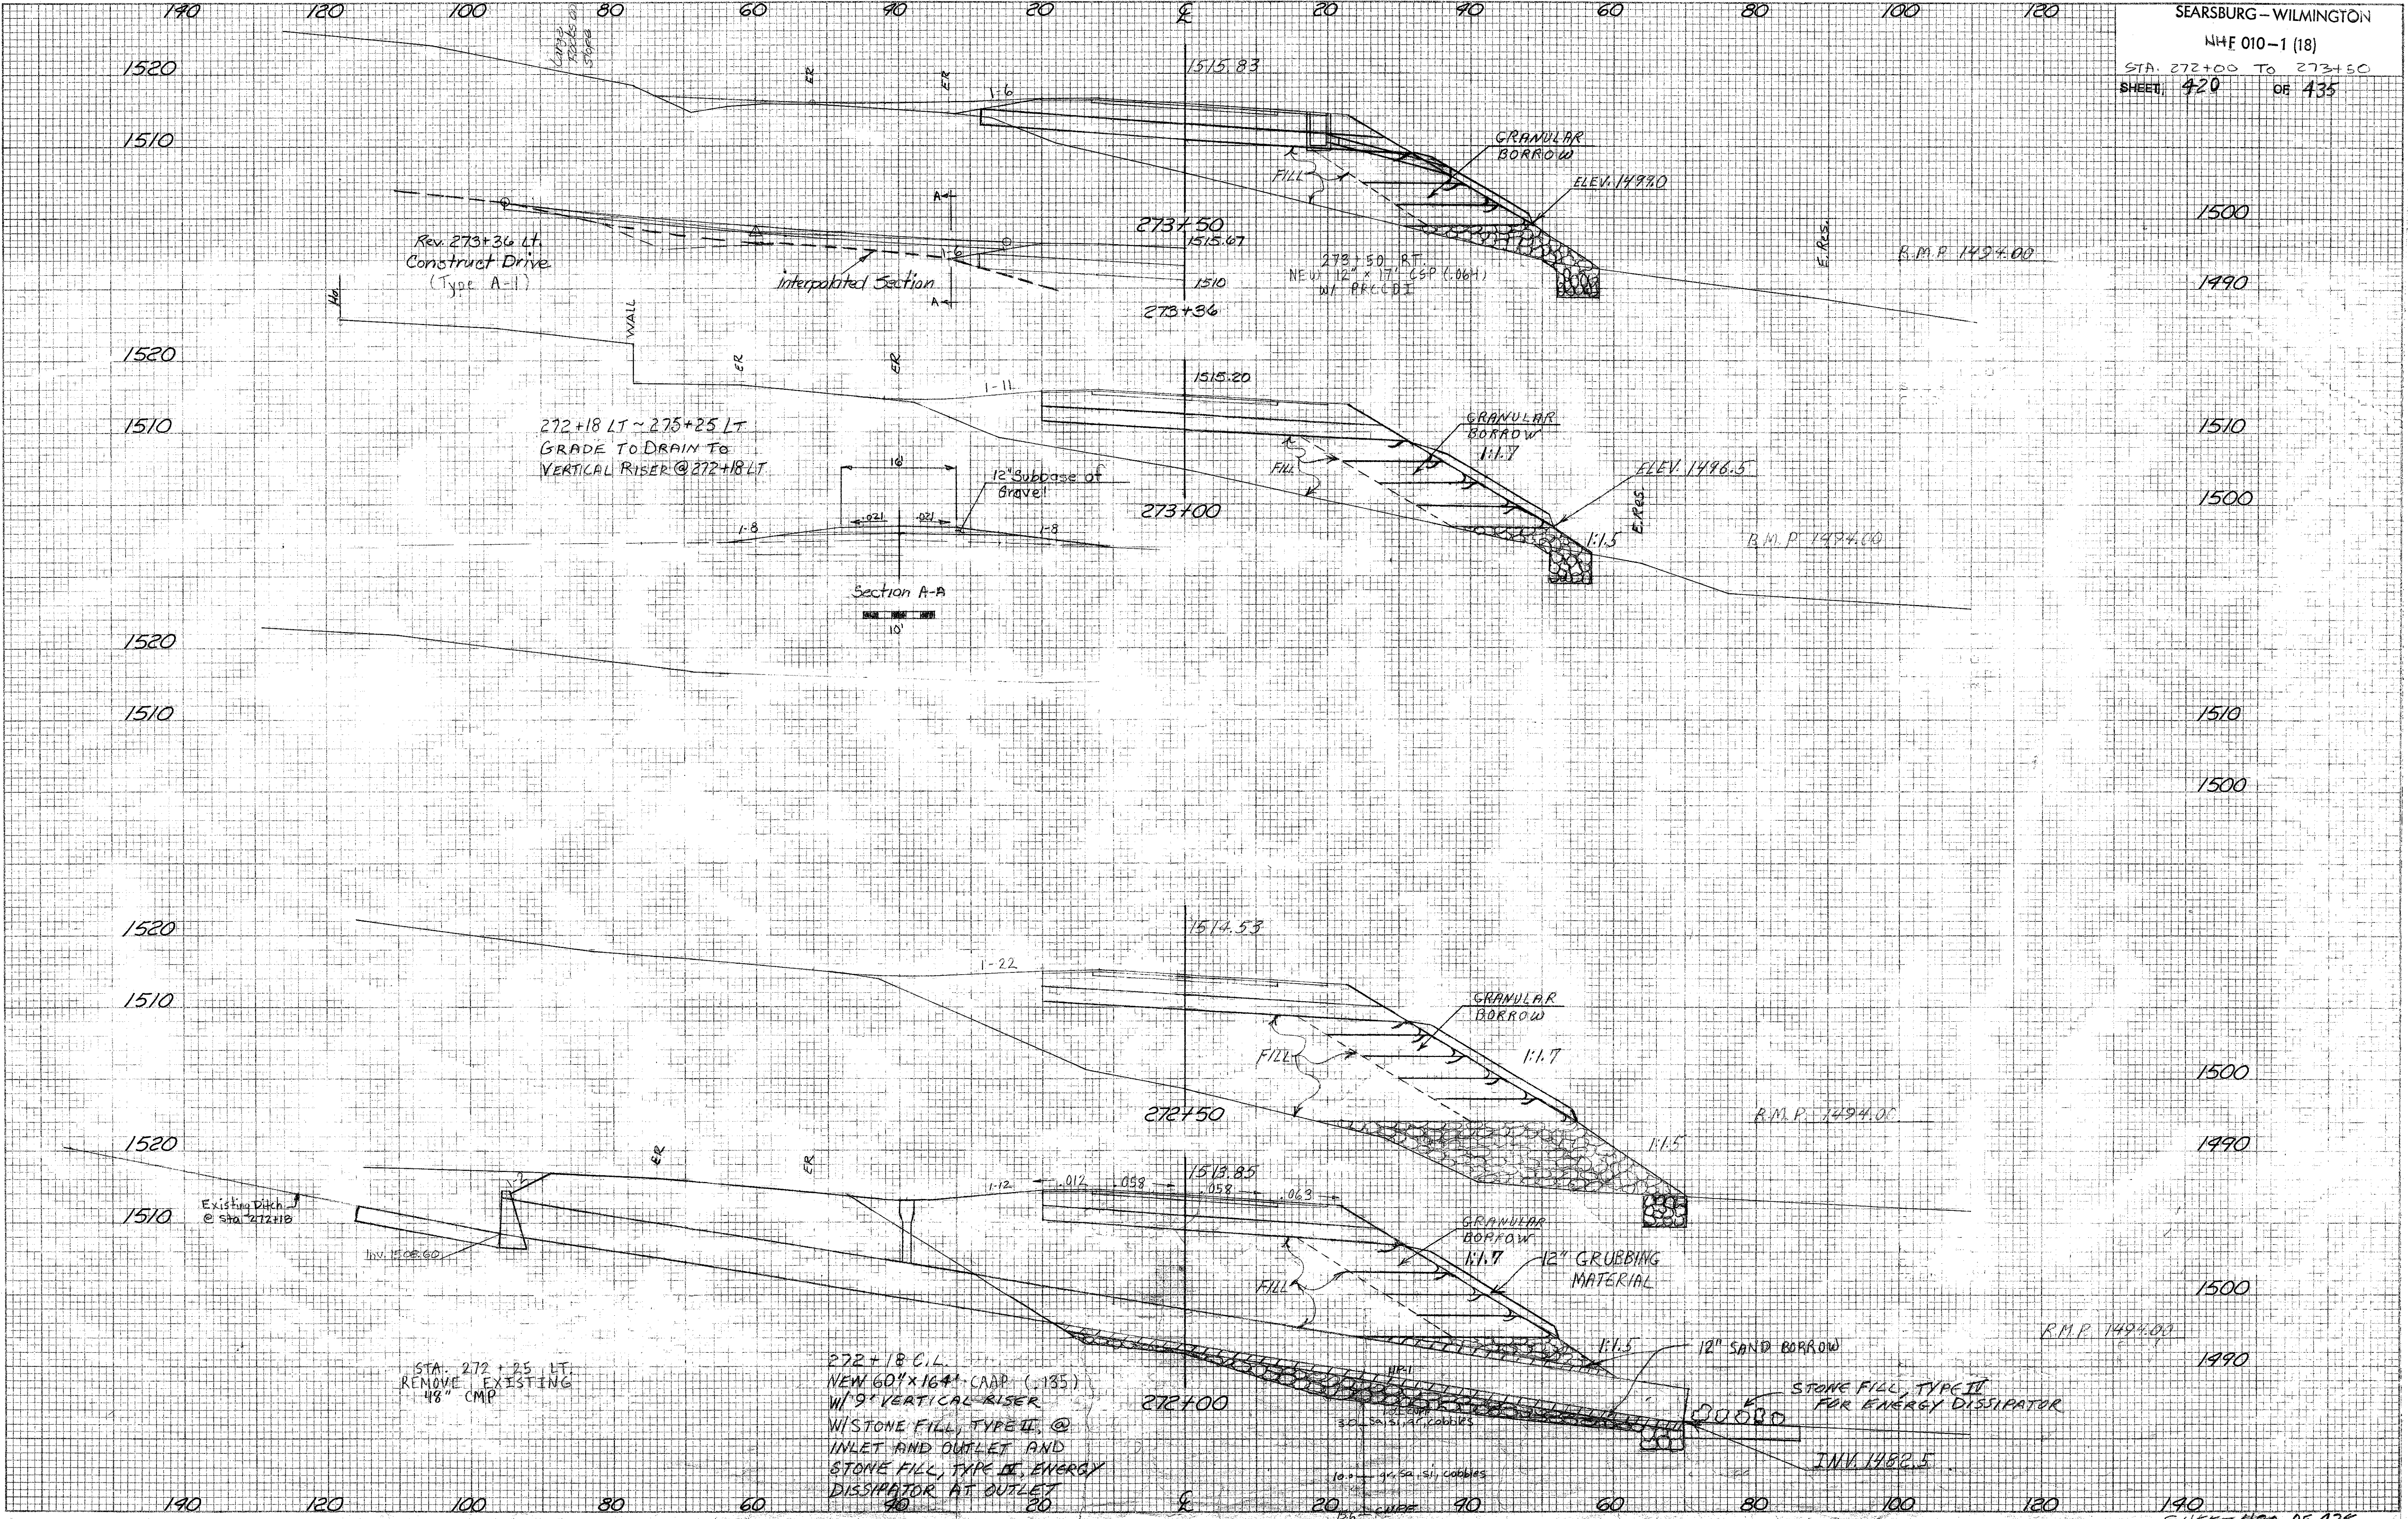

Rev. 273+36 Lt.  
Construct Drive  
(Type A-1)

272+18 LT ~ 273+25 LT  
GRADE TO DRAIN TO  
VERTICAL RISER @ 272+18 LT

Section A-A

10'

Existing Ditch  
@ Sta. 272+18

STA. 272+25 LT.  
REMOVE EXISTING  
48" CMP

272+18 C.L.  
NEW 60" x 164" CAAP (.135)  
W/ 9" VERTICAL RISER  
W/ STONE FILL, TYPE II, @  
INLET AND OUTLET AND  
STONE FILL, TYPE II, ENERGY  
DISSIPATOR AT OUTLET

STONE FILL, TYPE II  
FOR ENERGY DISSIPATOR