


DATE	
BY	
ORIGINAL SURVEY NOTE BOOK NO.	
FINAL SURVEY NOTE BOOK NO.	
AREAS CHECKED	
AREAS CHECKED	
AREAS CHECKED	
AREAS CHECKED	

DATE	7/23
BY	ZEL
ORIGINAL SURVEY NOTE BOOK NO.	
FINAL SURVEY NOTE BOOK NO.	
AREAS CHECKED	
AREAS CHECKED	
AREAS CHECKED	
AREAS CHECKED	

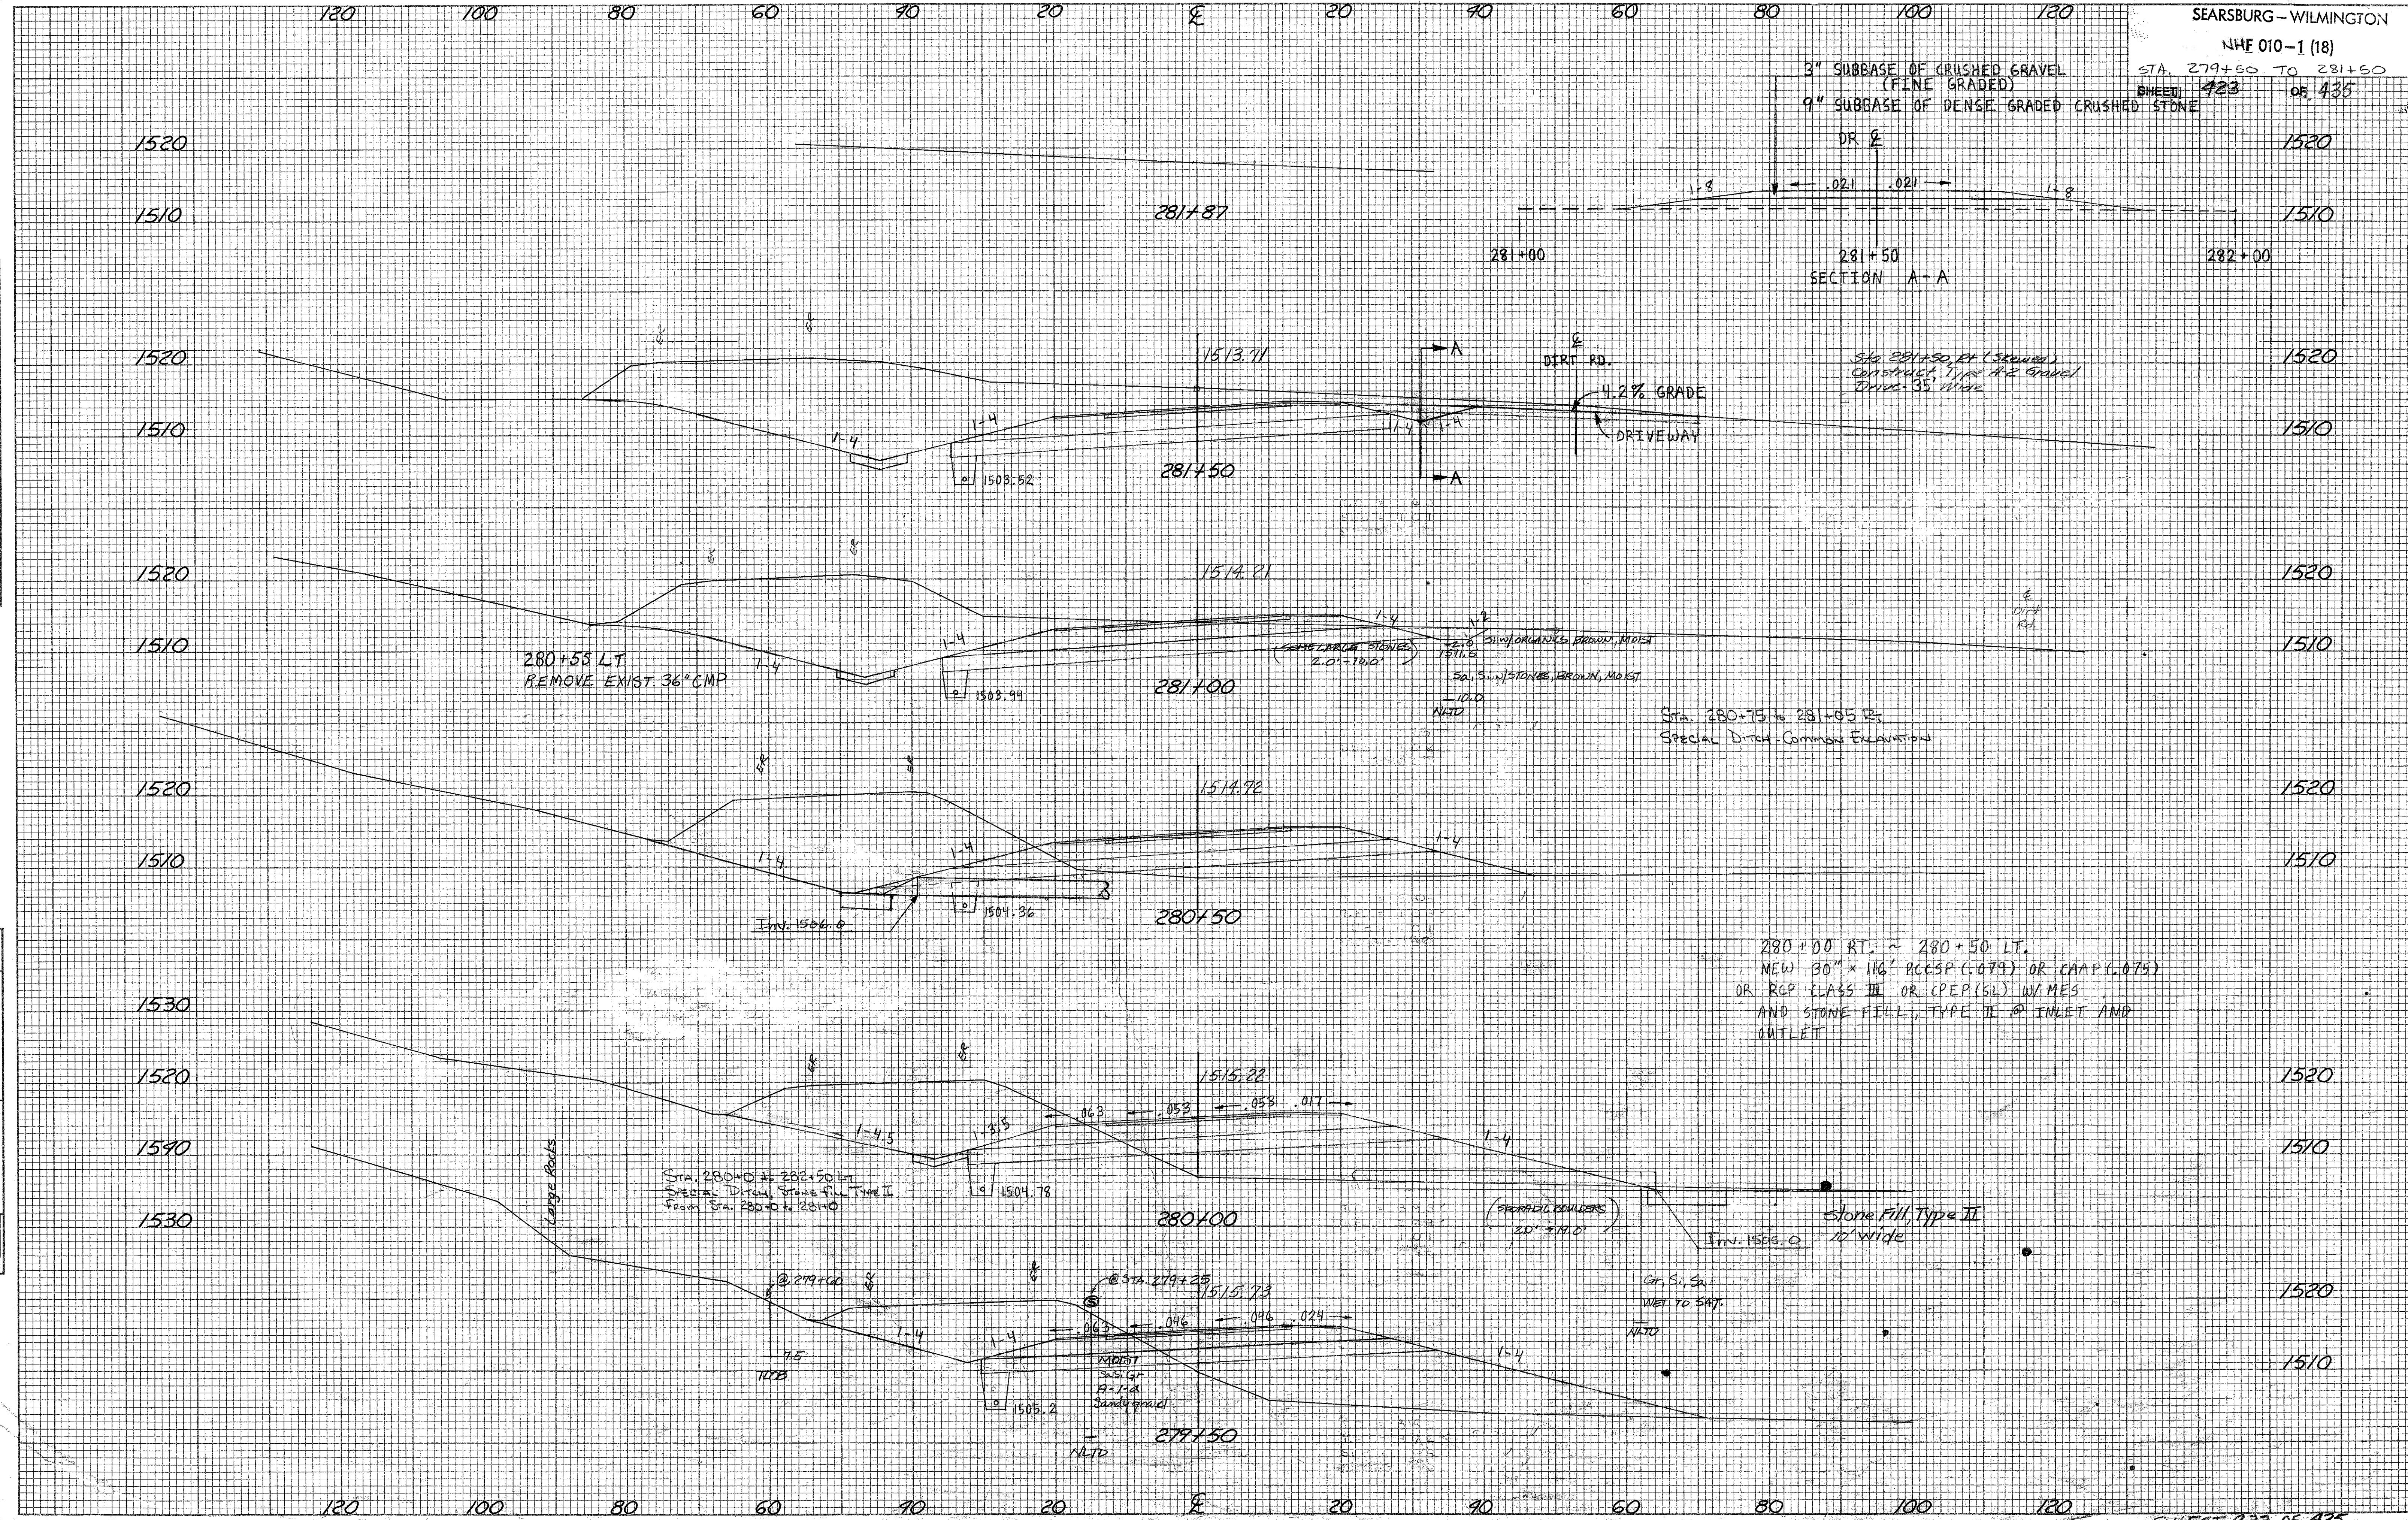

3" SUBBASE OF CRUSHED GRAVEL (FINE GRADED)
9" SUBBASE OF DENSE GRADED CRUSHED STONE

DR &
SECTION A-A

Sta 281+50 Rt (Skewer)
Construct Type II Gravel
Driv. 35' wide

DIRT RD.
4.2% GRADE
DRIVEWAY

280+55 LT
REMOVE EXIST 36" CMP

Sta. 280+75 to 281+05 Rt.
SPECIAL DITCH - COMMON EXCAVATION

280+00 RT. ~ 280+50 LT.
NEW 30" x 116" ACESP (.079) OR CAMP (.075)
OR RCP CLASS III OR CPEP (SL) W/ MES
AND STONE FILL, TYPE II @ INLET AND
OUTLET

Sta. 280+0 to 282+50 Lt
SPECIAL DITCH - Stone Fill Type II
From Sta. 280+0 to 281+0

SPECIAL SHOULDERS
20' x 10'

Stone Fill, Type II
10' wide