


WEST CONNECTOR CROSS SECTIONS

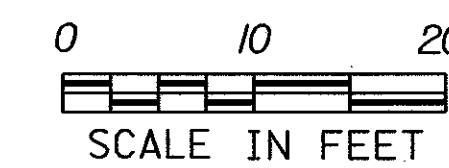

PROJECT NAME:	SEARSBURG - WILMINGTON		
PROJECT NUMBER:	NHF 010-(18)		
PLOT FILE NAME:	DD096X28	PLOT DATE:	25-OCT-2001
PROJECT LEADER:	DELLA SANTA	DRAWN BY:	SQUAD B
DESIGN FILE NAME:	78D096/DESIGN/DD096CWRK.DGN		SHEET 428 OF 435