


WEST CONNECTOR CROSS SECTIONS

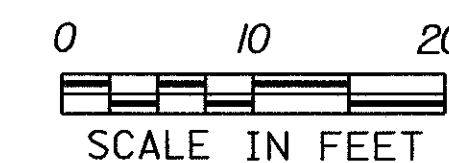

PROJECT NAME:	SEARSBURG - WILMINGTON
PROJECT NUMBER:	NHF 010-1(18)
PLOT FILE NAME:	DD096X29
PROJECT LEADER:	DELLA SANTA
DESIGN FILE NAME:	78D096/DESIGN/DD096CWRK.DGN
PLOT DATE:	25-OCT-2001
DRAWN BY:	SQUAD B
SHEET 429 OF 435	