


DATE	
BY	
FINAL SURVEY	SURVEYED
NOTE BOOK	PLOTTED
NO.	TEMPERATURE
	AREAS CHECKED

DATE	
BY	
ORIGINAL SURVEY	SURVEYED
NOTE BOOK	PLOTTED
NO.	TEMPERATURE
	AREAS CHECKED

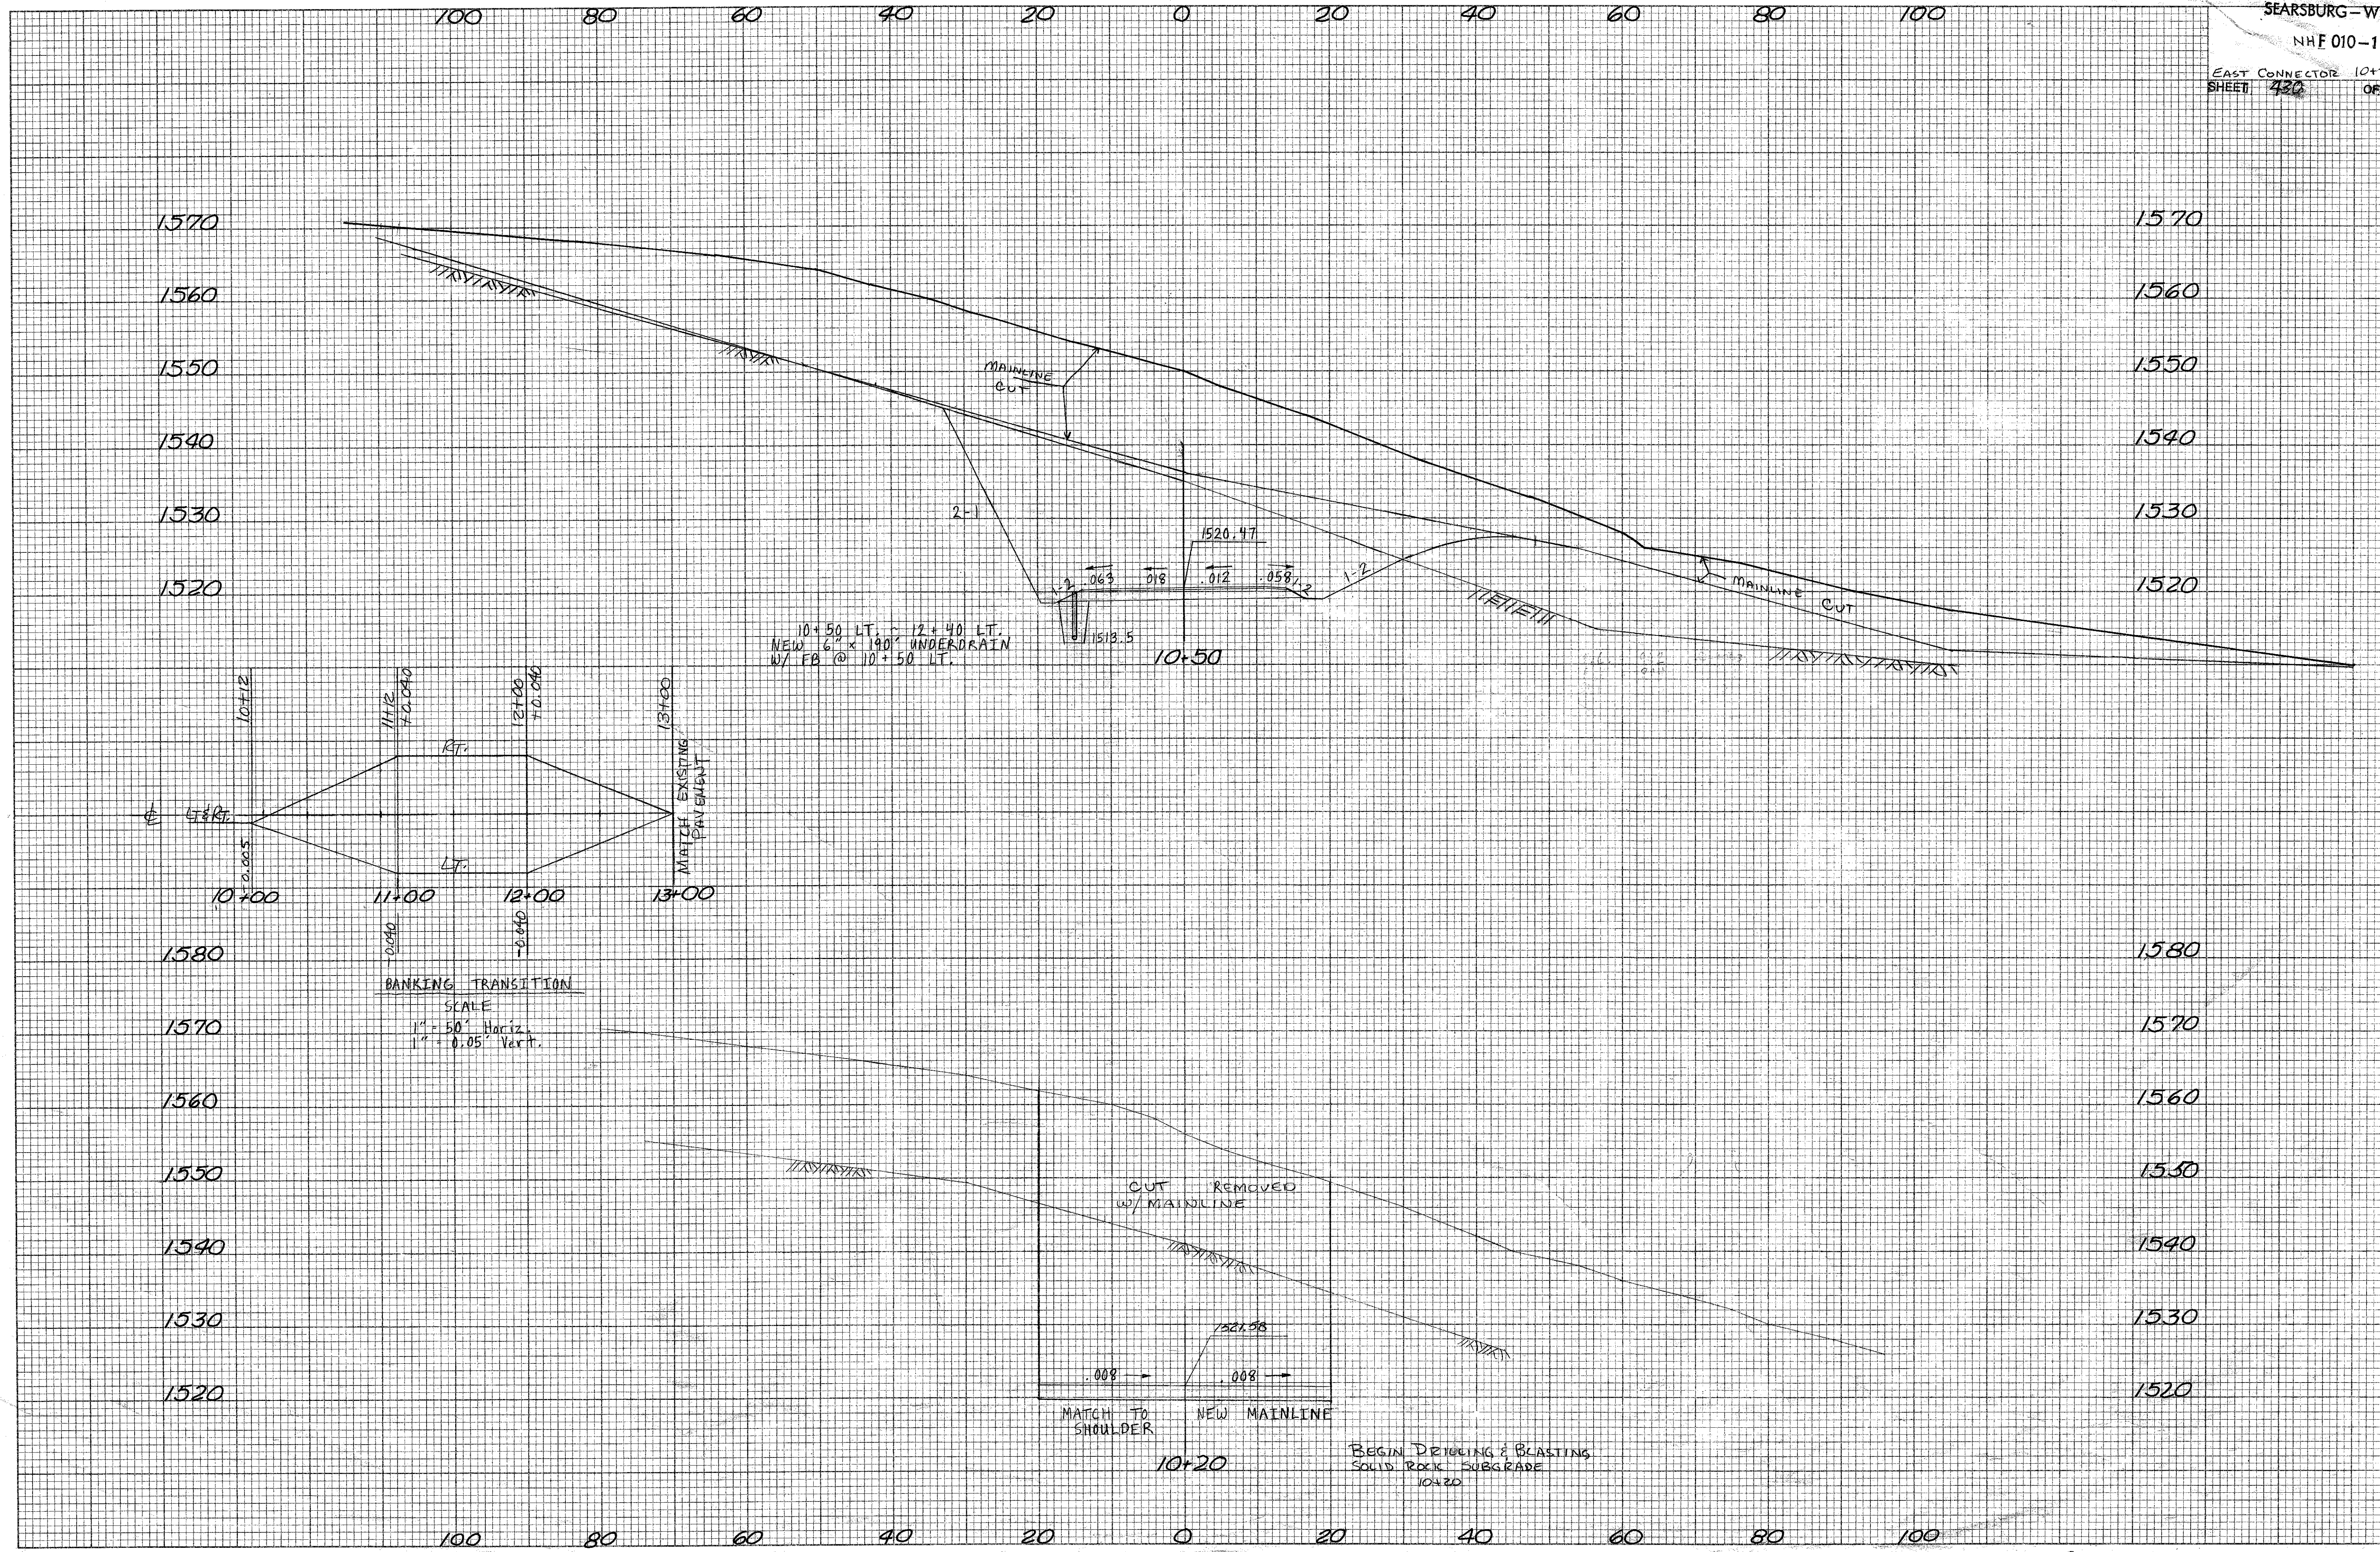

10+50 LT. ~ 12+40 LT.  
 NEW 6" x 190" UNDERDRAIN  
 W/ FB @ 10+50 LT.

BANKING TRANSITION  
 SCALE  
 1" = 50' Horiz.  
 1" = 0.05' Vert.

MATCH TO SHOULDER  
 NEW MAINLINE  
 10+20

BEGIN DRIVING & BLASTING  
 SOLID ROCK SUBGRADE  
 10+20