

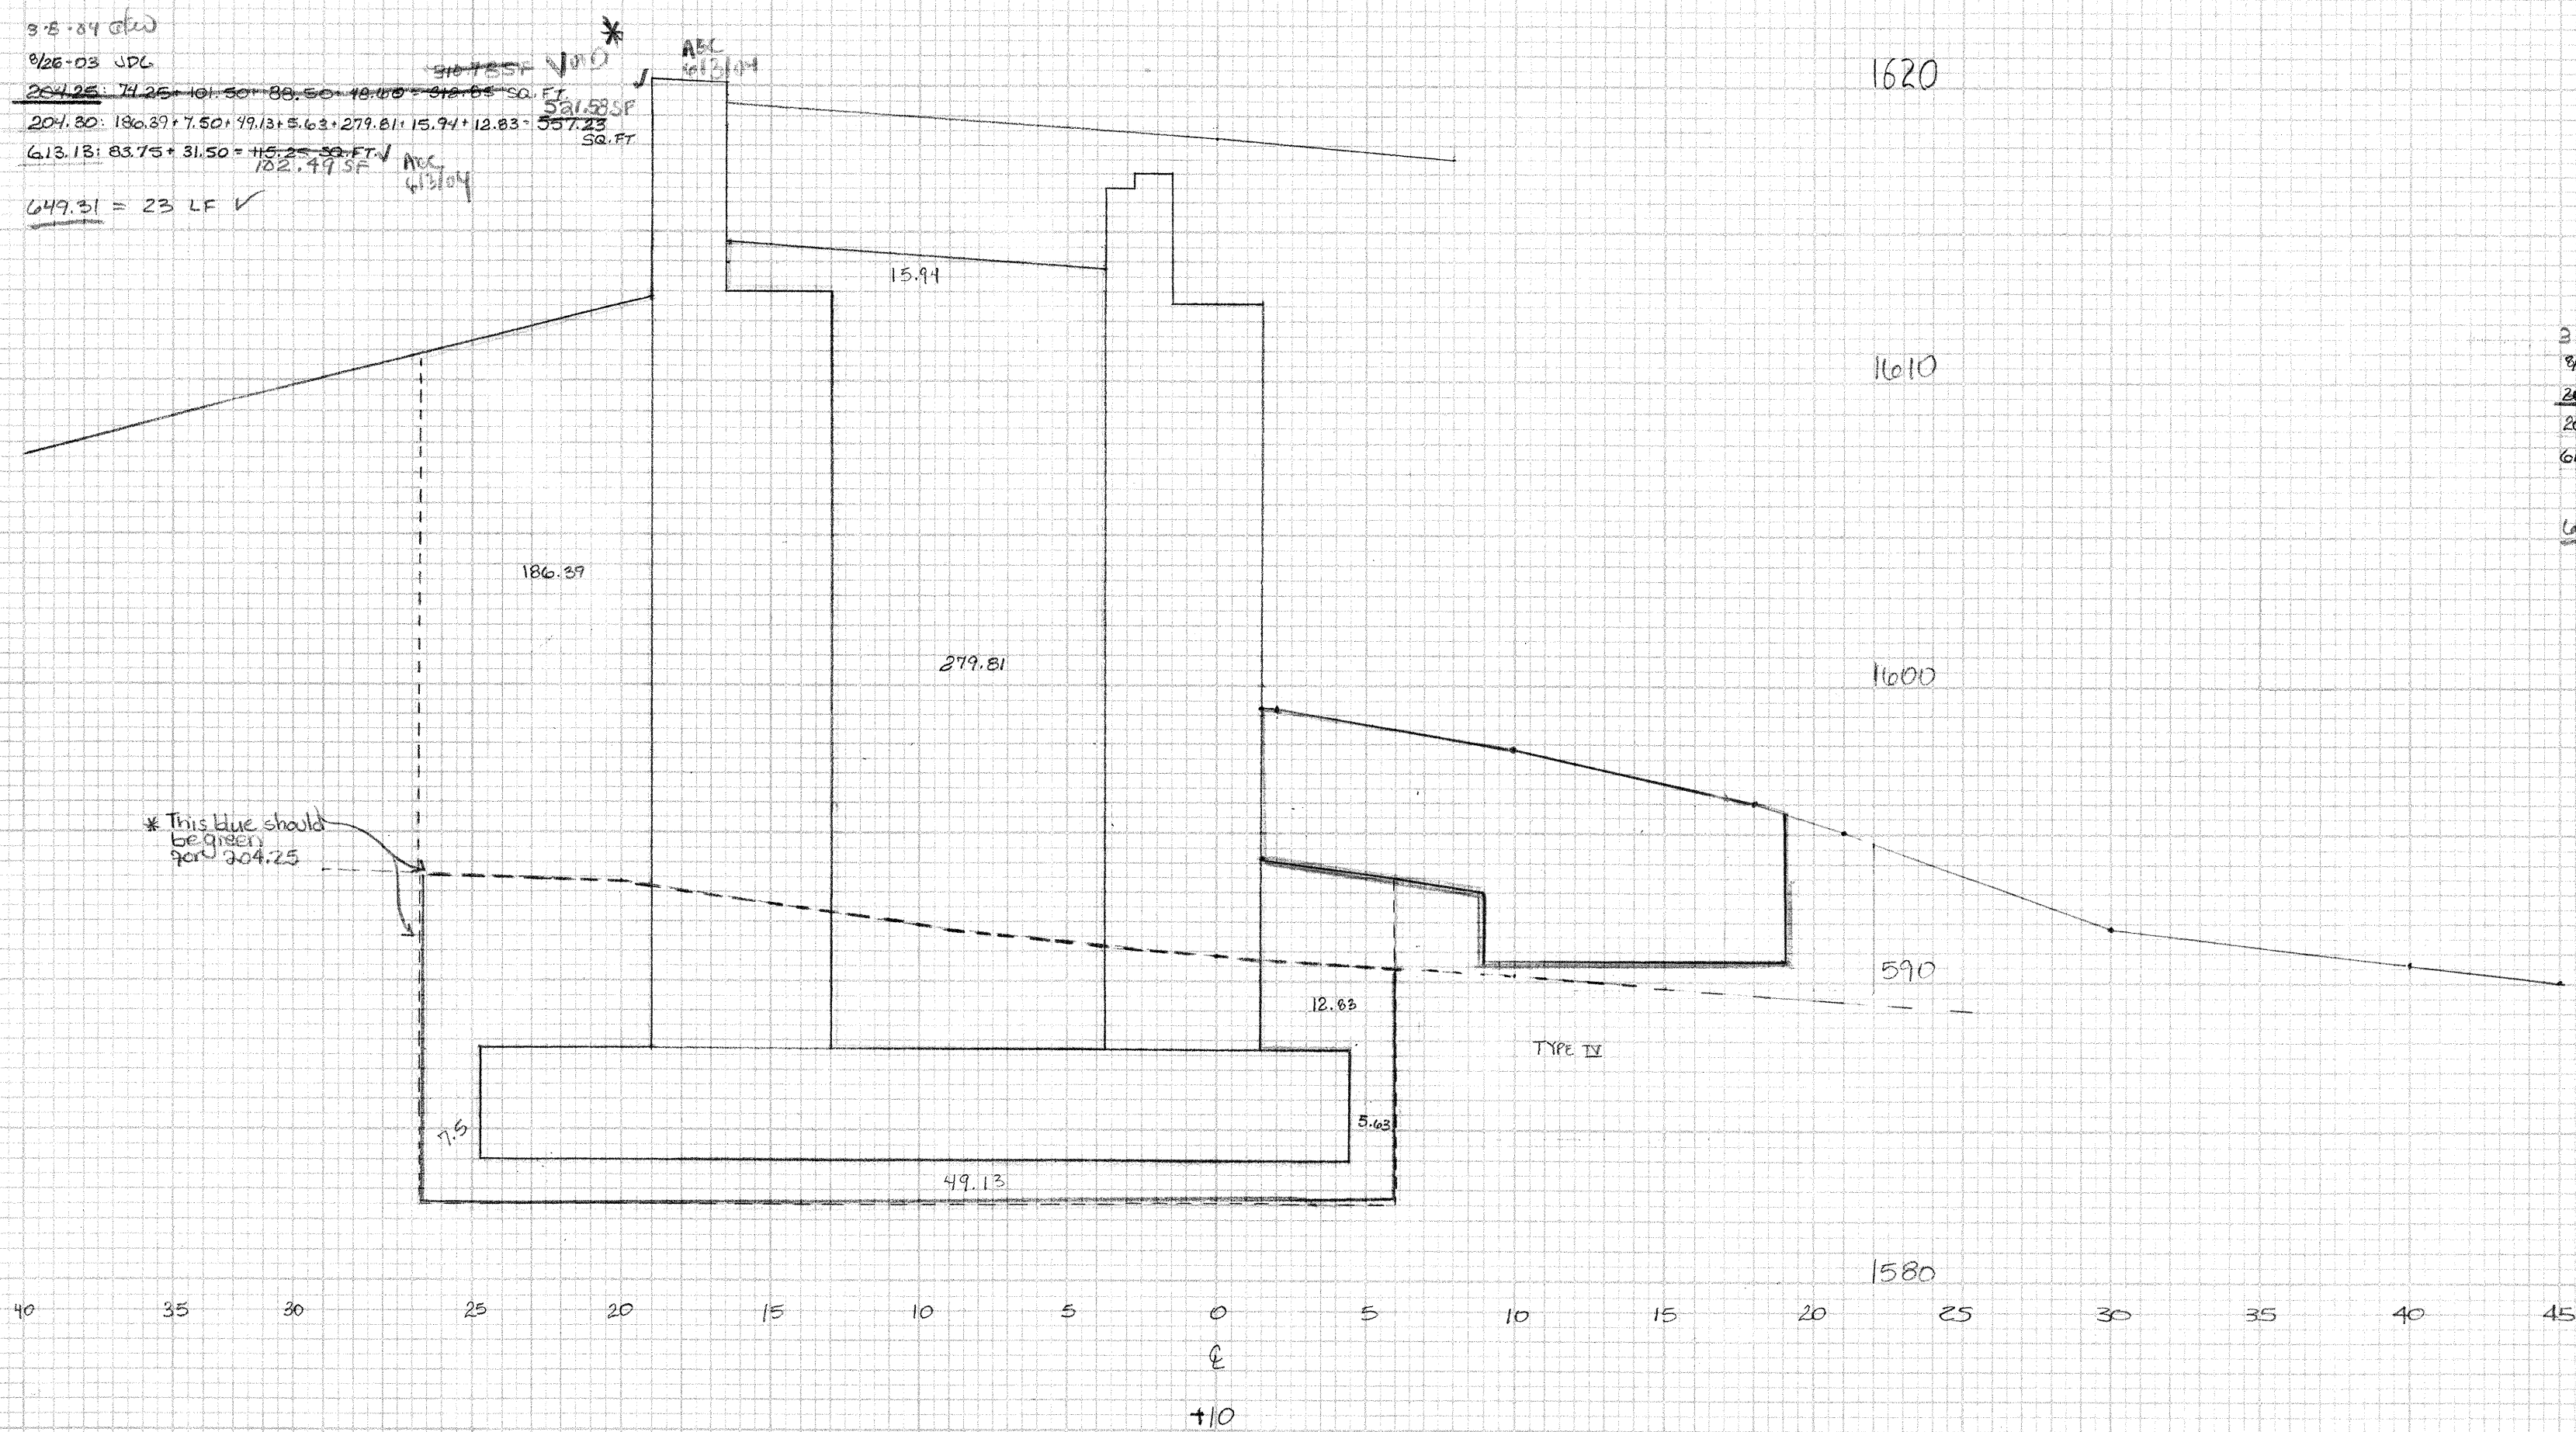



* ITEM 204.25 CALCULATIONS
 NOT BASED ON THESE SECTIONS
 SEE CALCULATION SHEET
 SEE NOTE ON XBR25B-1

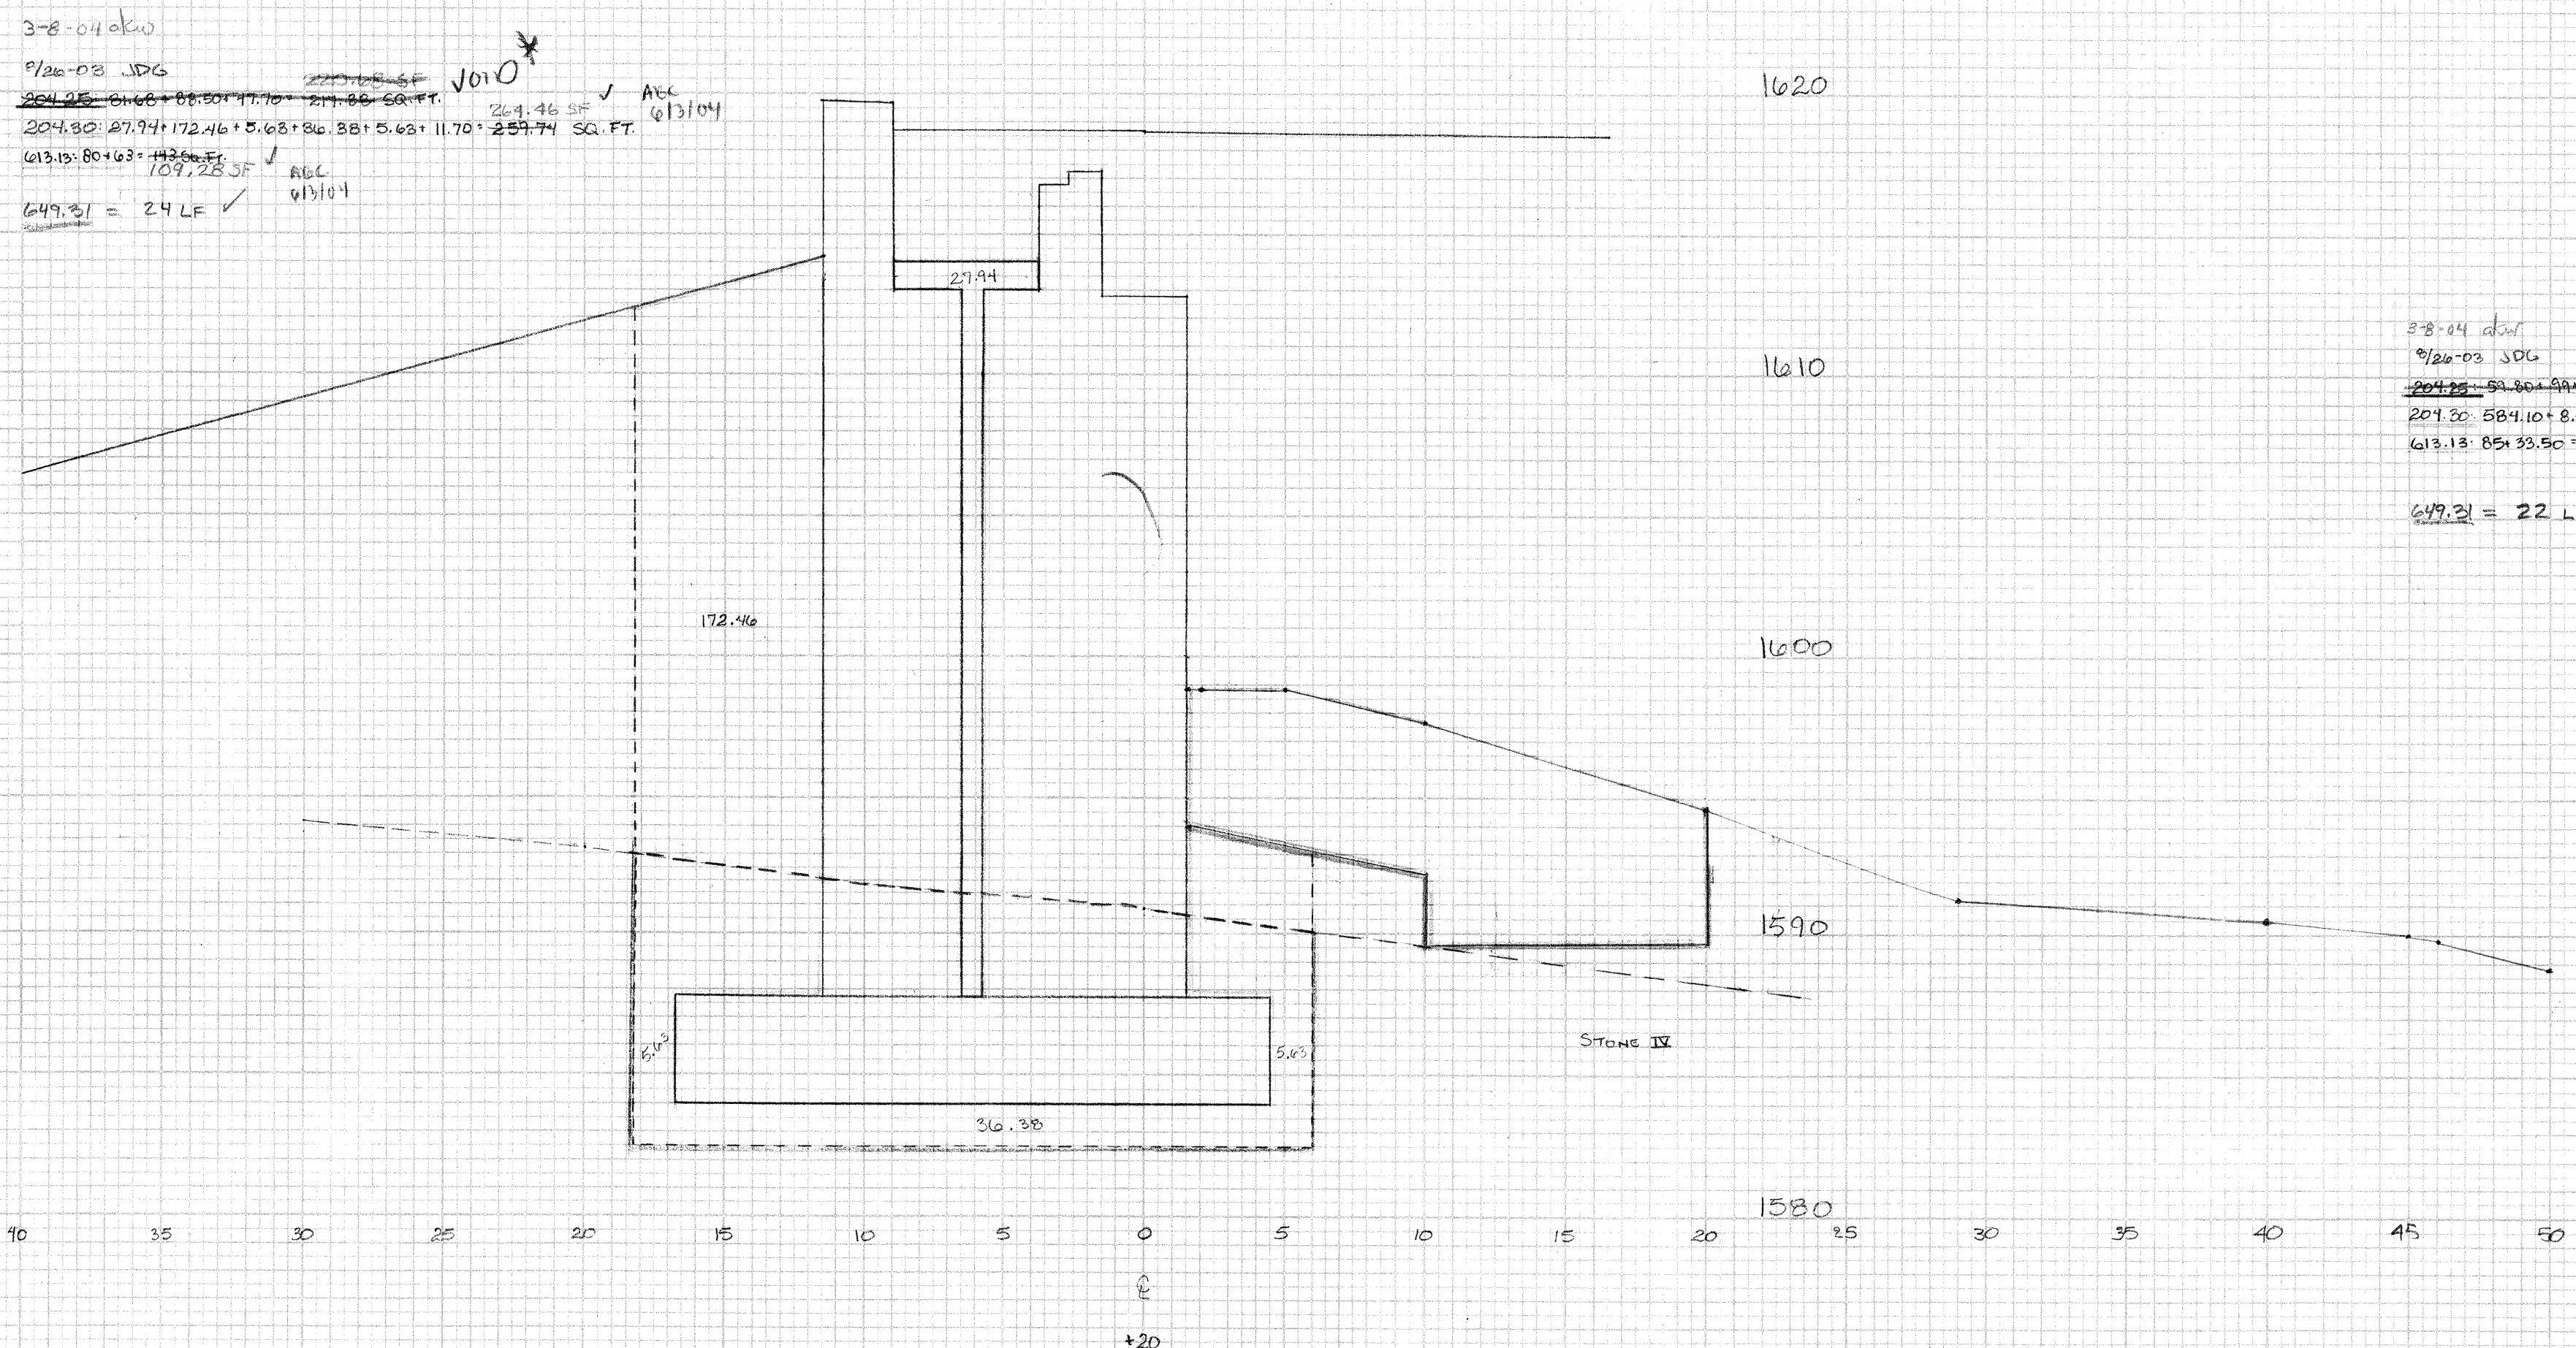

3-9-04 dcl
 9/26-03 JDC
~~204.25~~ 34.15 + 29.54 + 18.00 + 18.00 = 99.69 SF
 204.30 217 + 5.63 + 26.80 + 2.63 + 2.40 + 16.56 = 300.32 SF
 613.13 81.25 + 26.5 = 107.75 SF
 93.38 SF
 649.51 = 21 LF ✓
 ABC 6/13/04

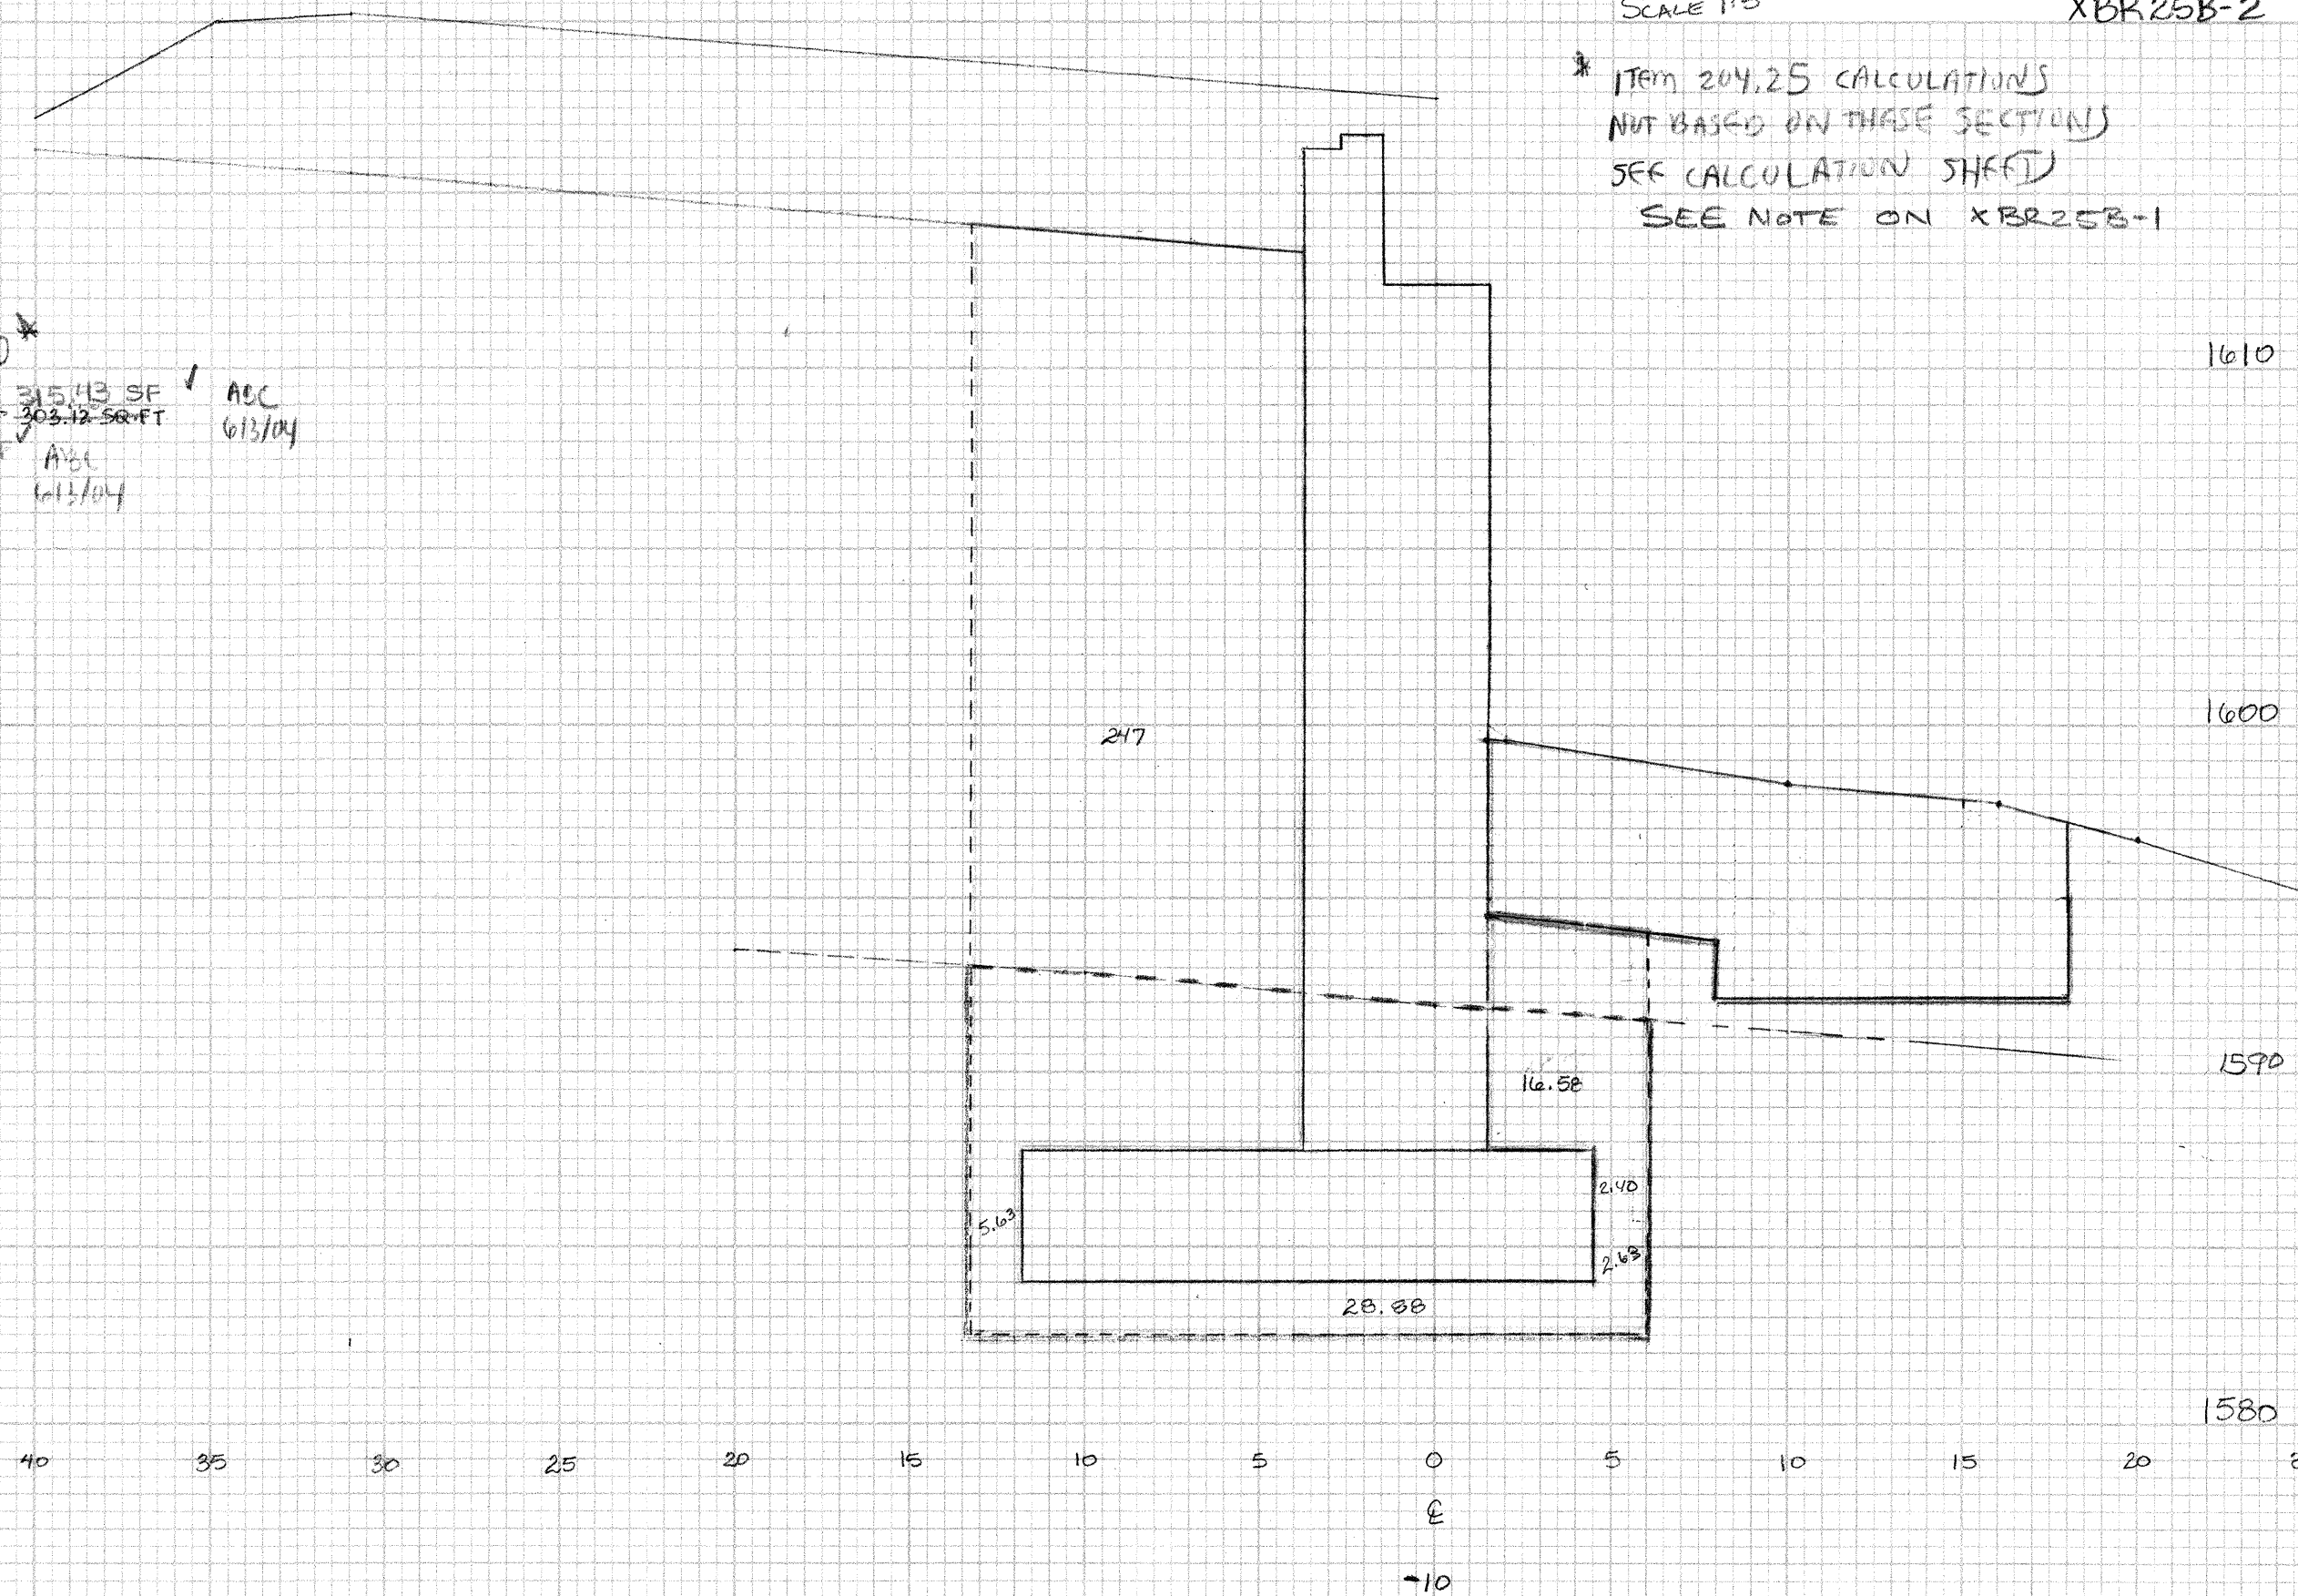

3-8-04 dcl
 9/26-03 JDC
~~204.25~~ 81.60 + 18.50 + 17.70 + 21.80 = 149.60 SF
 204.80 27.94 + 172.46 + 5.63 + 86.38 + 5.63 + 11.70 = 259.74 SF
 613.13 80 + 63 = 143 SF
 129.23 SF
 649.51 = 24 LF ✓
 ABC 6/13/04

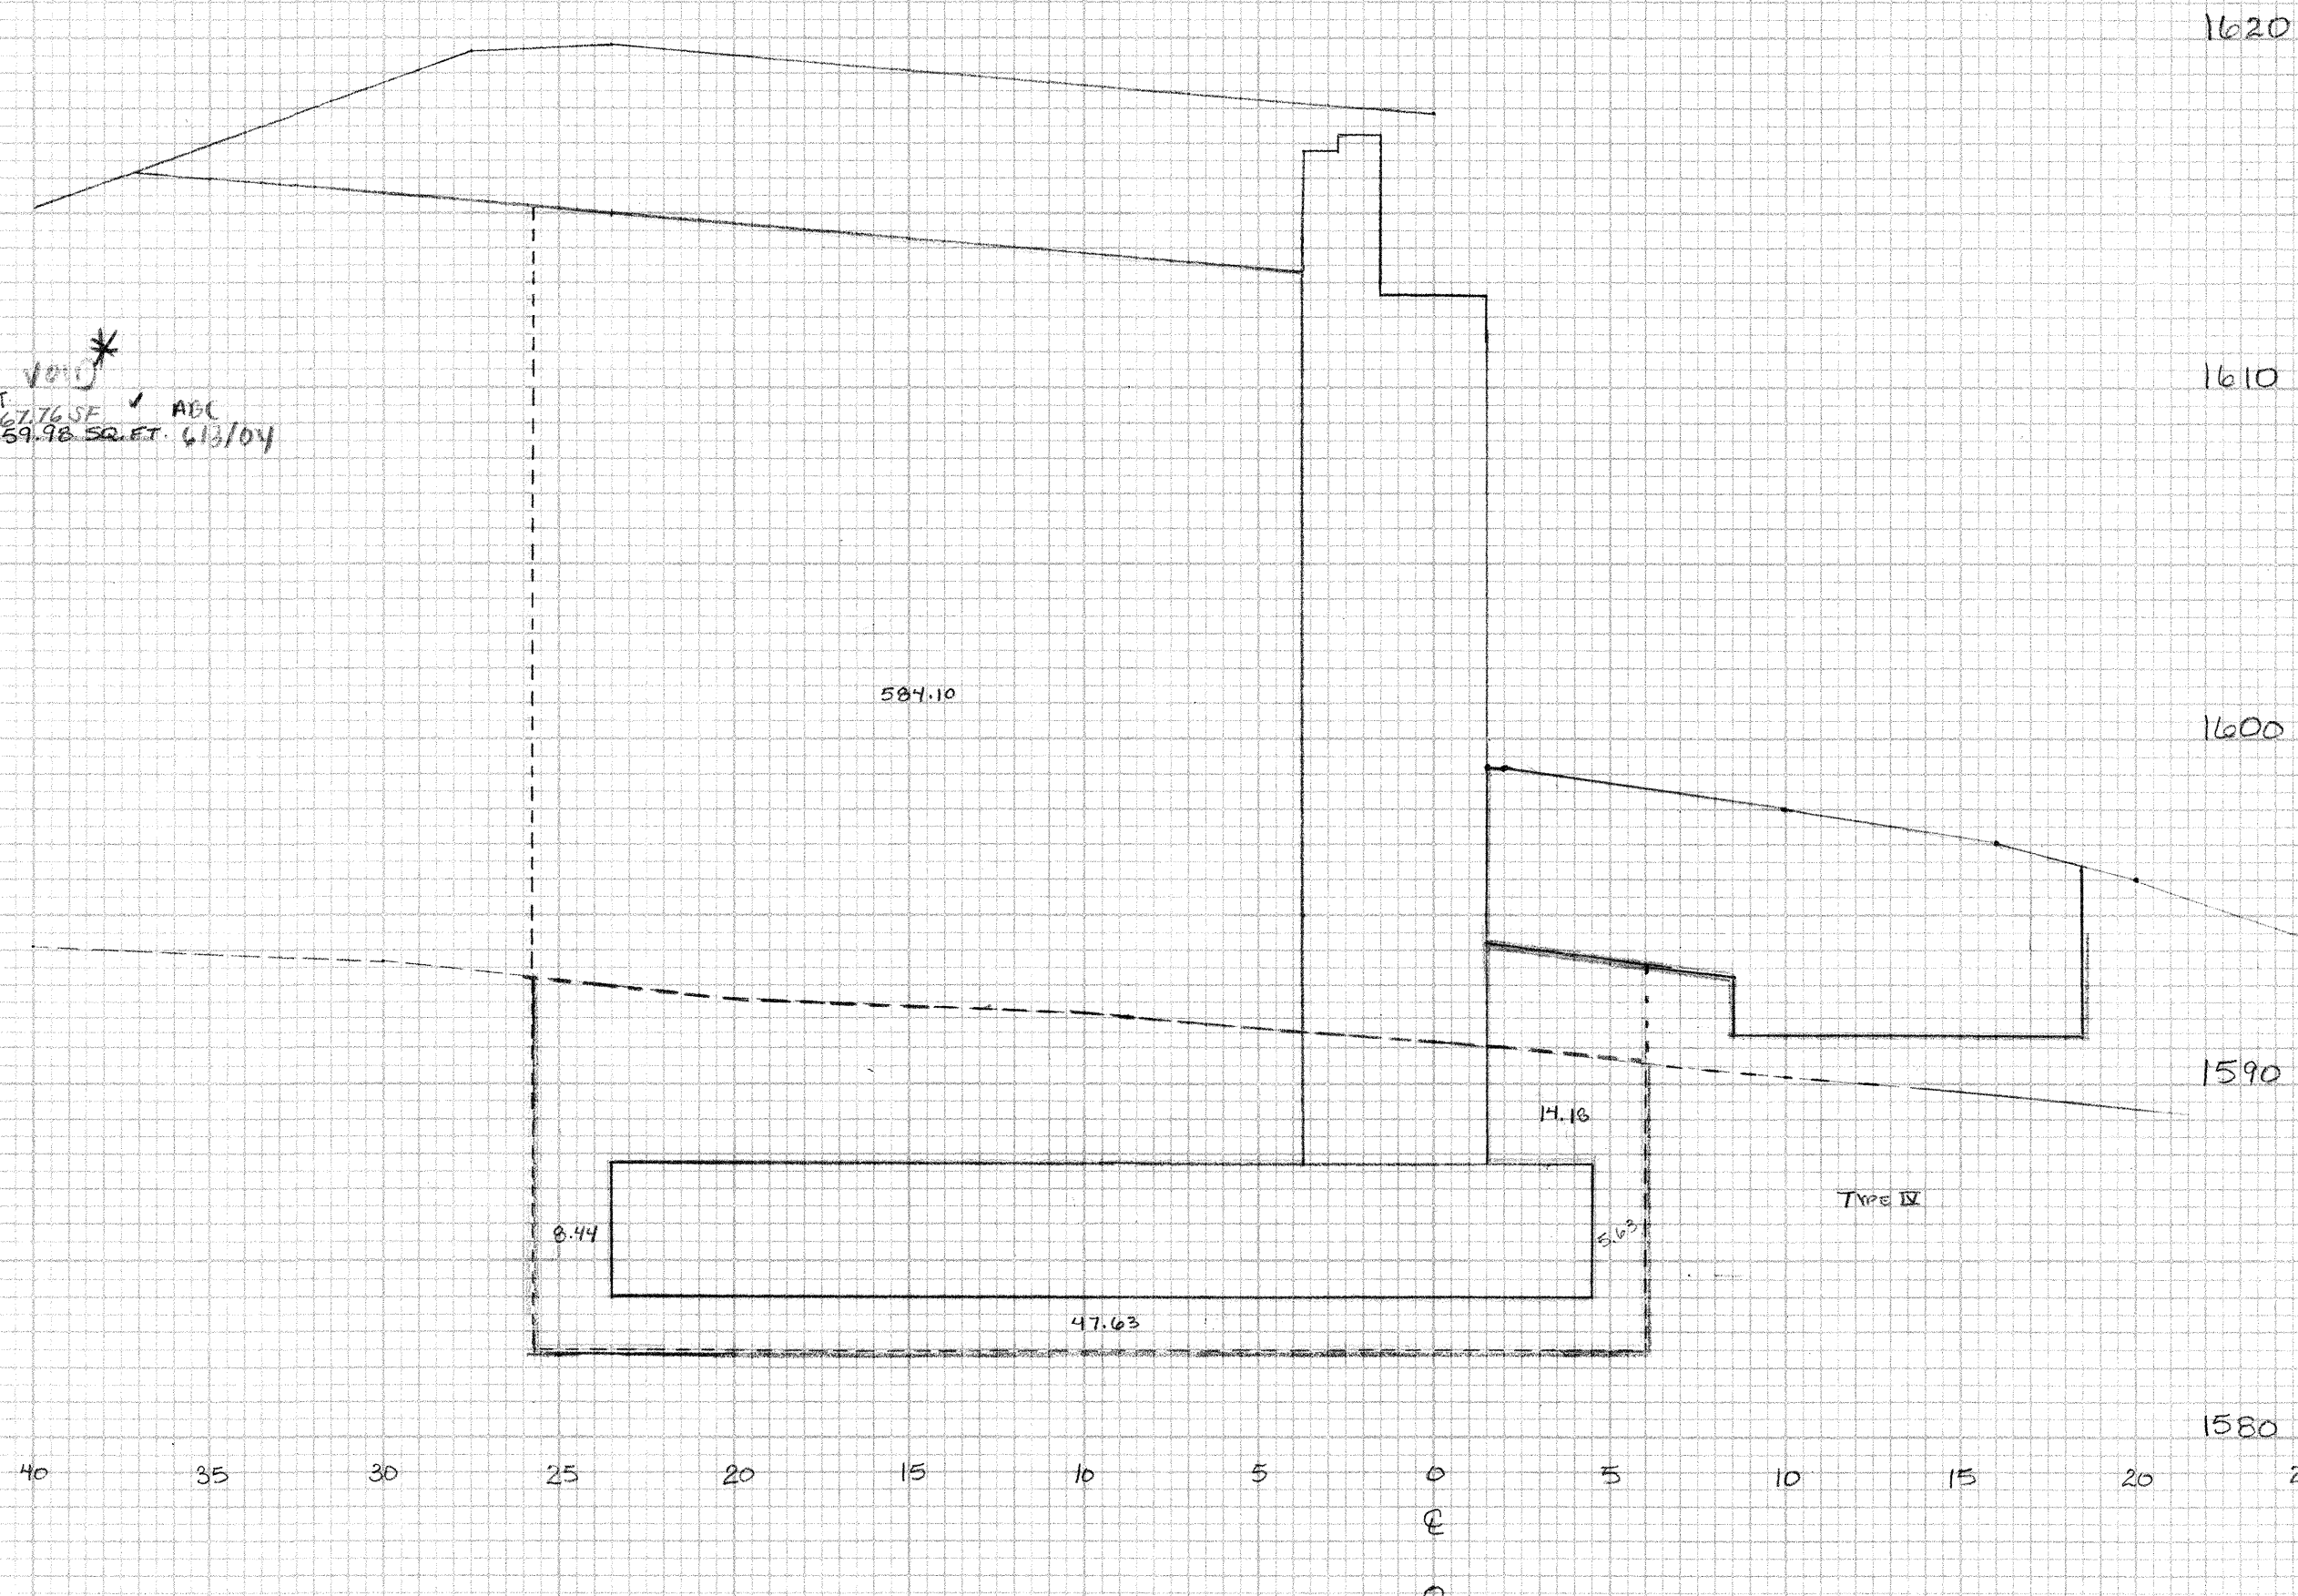

FINAL SURVEY
 SURVEYED BY: []
 DATE: []
 NOTE BOOK: []
 AREA: []
 NO. OF SHEETS: []

ORIGINAL SURVEY
 SURVEYED BY: []
 DATE: []
 NOTE BOOK: []
 AREA: []
 NO. OF SHEETS: []